


S.S. No 110 & 111.

MIDSHIP SECTION.

SCALE $\frac{1}{2}'' = 1'-0''$

TO CLASS 100 A1+ LLOYDS.

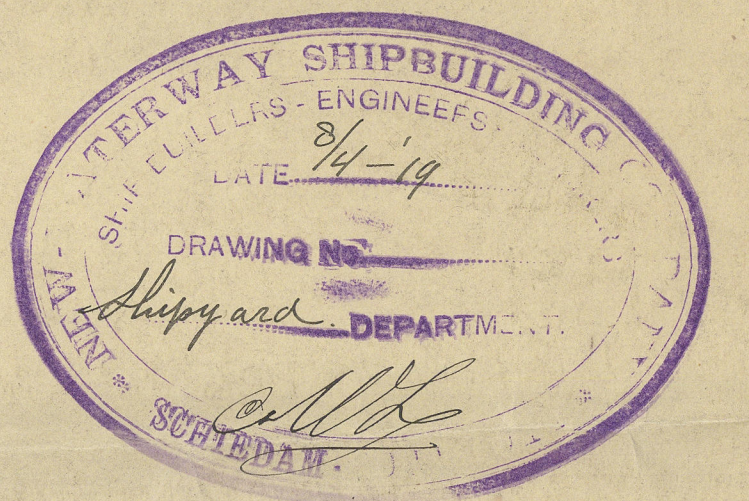


DIMENSIONS

LENGTH BETWEEN R.R.	450'-0"
BREADTH MOULDED	60'-0"
DEPTH TO SHELTERDECK	39'-6"
HEIGHT OF SHELTERDECK	8'-0"
" " TWEEDECK	10'-0"
" " DECKHOUSE	7'-6"
ROUND OF BEAM	15'

NUMERALS

$B+D = 60 + 39.6 - 8.0 =$	91.5
$L \times (B+D) =$	41175
$L : D =$	11.39
$d =$	17.75


SKETCH SHOWING
HATCH SIDE CORNING
OF MAIN & LOWERDECK

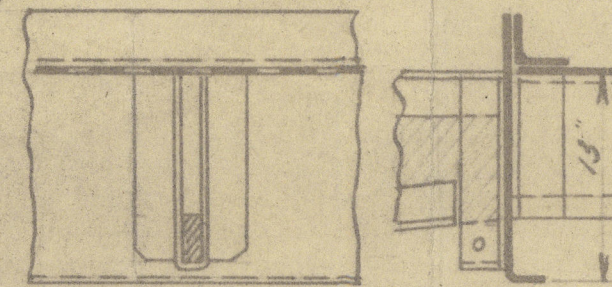

EQUIPMENT

$L \times (B + D)$	41175		
SHELTERDECK	34' x 8' x 450'	2700	✓
STEER GEAR HOUSE	12' x 7.5' x 44'	165	✓
CABIN	12' x 7.5' x 72'	270	✓
SALOON DECKHOUSE	12' x 7.5' x 24'	90	✓
OFFICE DECKHOUSE	12' x 7.5' x 24'	90	
<i>Deck from north</i>	308 x 75 x 8	125	
EQUIPMENT NUMBER	44000	44000	

3 BOWER ANCHORS STOCKLESS	
219 1/2 CWT. COLL. WEIGHT	
1 STEAM ANCHOR 22 CWT. EX. STOCK	
1 KEDGE ANCHOR 10	
300 FATHOMS 2 1/2" STUD CHAIN CABLE	
130 5/8" STEEL WIRE	
120 5/8" STEEL WIRE	
4 x 100' 8" MANILLA	

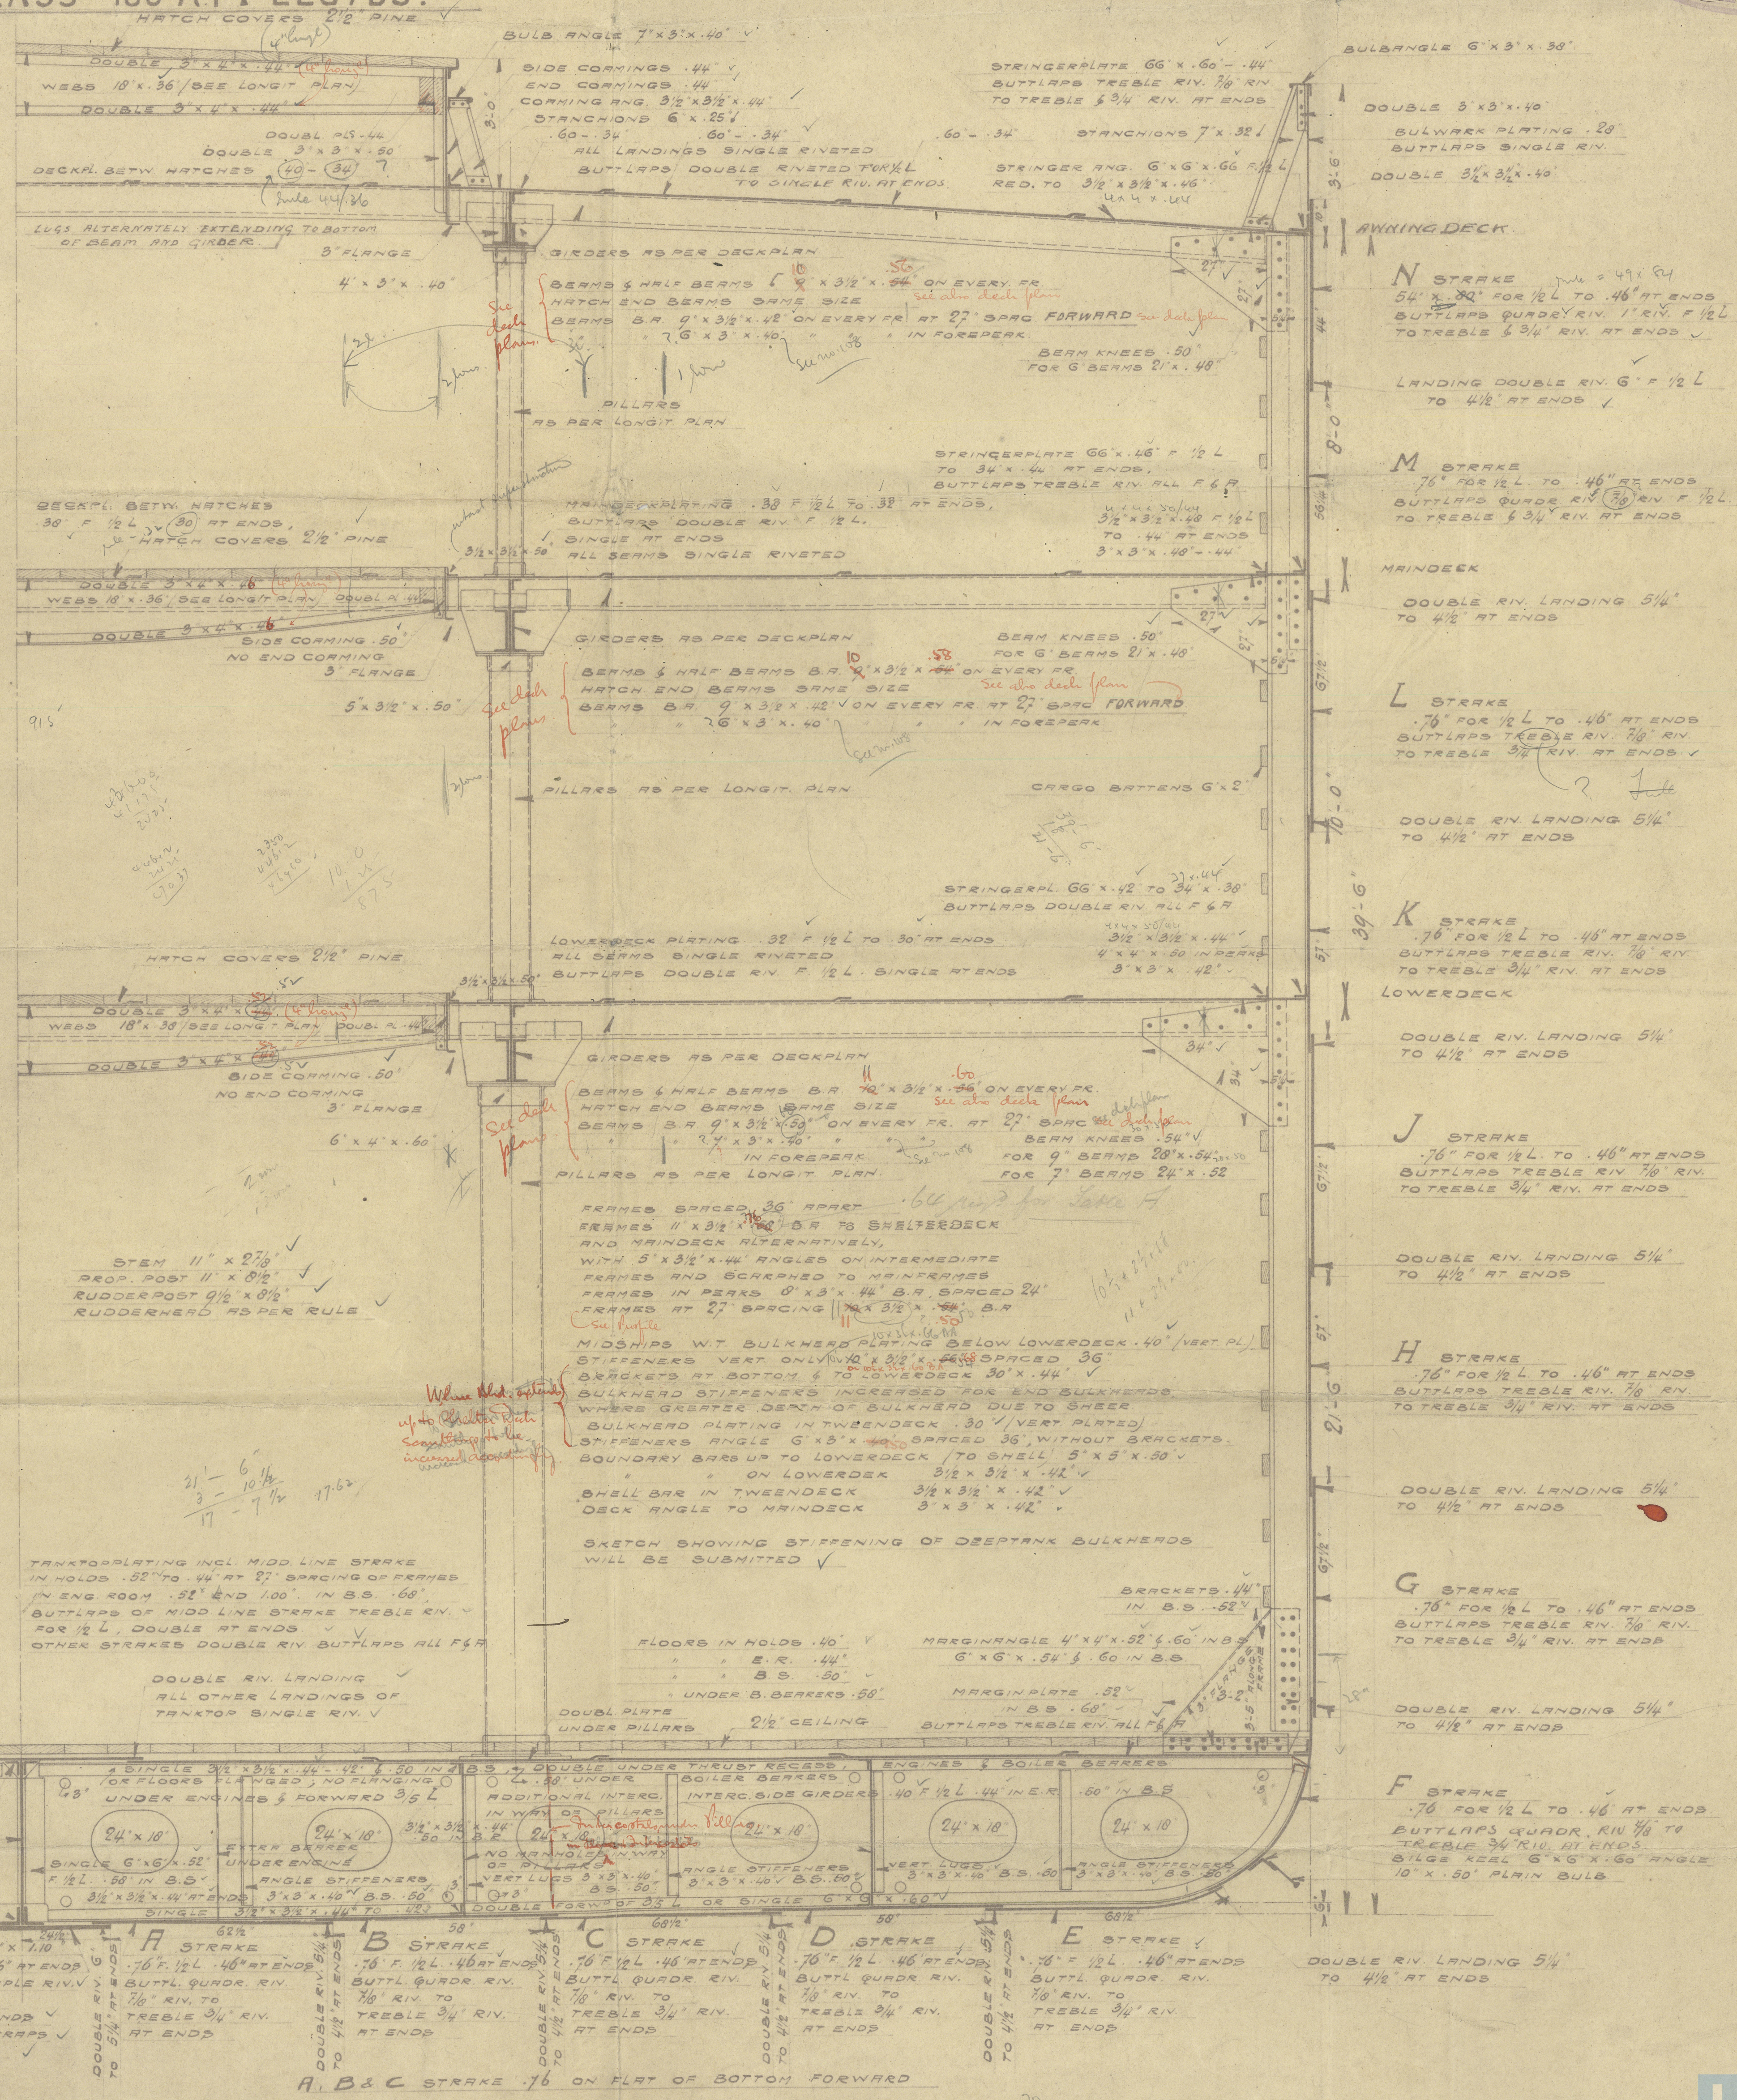


Ans. 110 / 111

WJH

London Affee
WJH mter

Sl. "Gemma" "Surooskuk"
Vol. 12167.

Sl. "Yasma"
Vol. 12315.

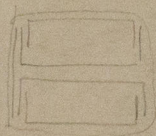

W214-0212



© 2019

Lloyd's Register
Foundation



W. D. Hunter



© 2019

Lloyd's Register
Foundation