

SHIP N^o 154.


PROFILE & DECKS.

DIMENSIONS :- 297'0" x 44'8" x 22'7"

SCALE 1/8" = ONE FOOT.






Handwritten: Bulkhead on upper dk. Bhd 53.

ITEM.	BHD 10.	BHD 48.	BHD 67.	BHD 113.	NON MTS. 63.
PLATING.	30	31-26	31-26	35-30	30
COAMING.	FR 6-39	36-36	36-36	45-41	36-36
STIFFENERS.	9-3/4-43 BA	9-3/4-45 BA	9-3/4-45 BA	9-3/4-37 BA	6-3/4-36 BA
SPACING.	24"	30 3/4"	30 3/4"	24"	36"
FRAMES.	3 1/2 x 3-40	3 1/2 x 3-41	3 1/2 x 3-41	3 1/2 x 3-45	3 1/2 x 3-40
BEAMS.	3 1/2 x 3-36	3 1/2 x 3-36	3 1/2 x 3-36	3 x 3-26	3 1/2 x 3-36
T.T. BAR.	—	3 x 3-21	3 x 3-21	—	3 x 3-40
BRACKETS.	22 1/2 x 34 PL 26	22 1/2 x 34 PL 26	22 1/2 x 34 PL 26	—	—
RIVETS.	6-3/4"	6-3/4"	6-3/4"	6-3/4"	—

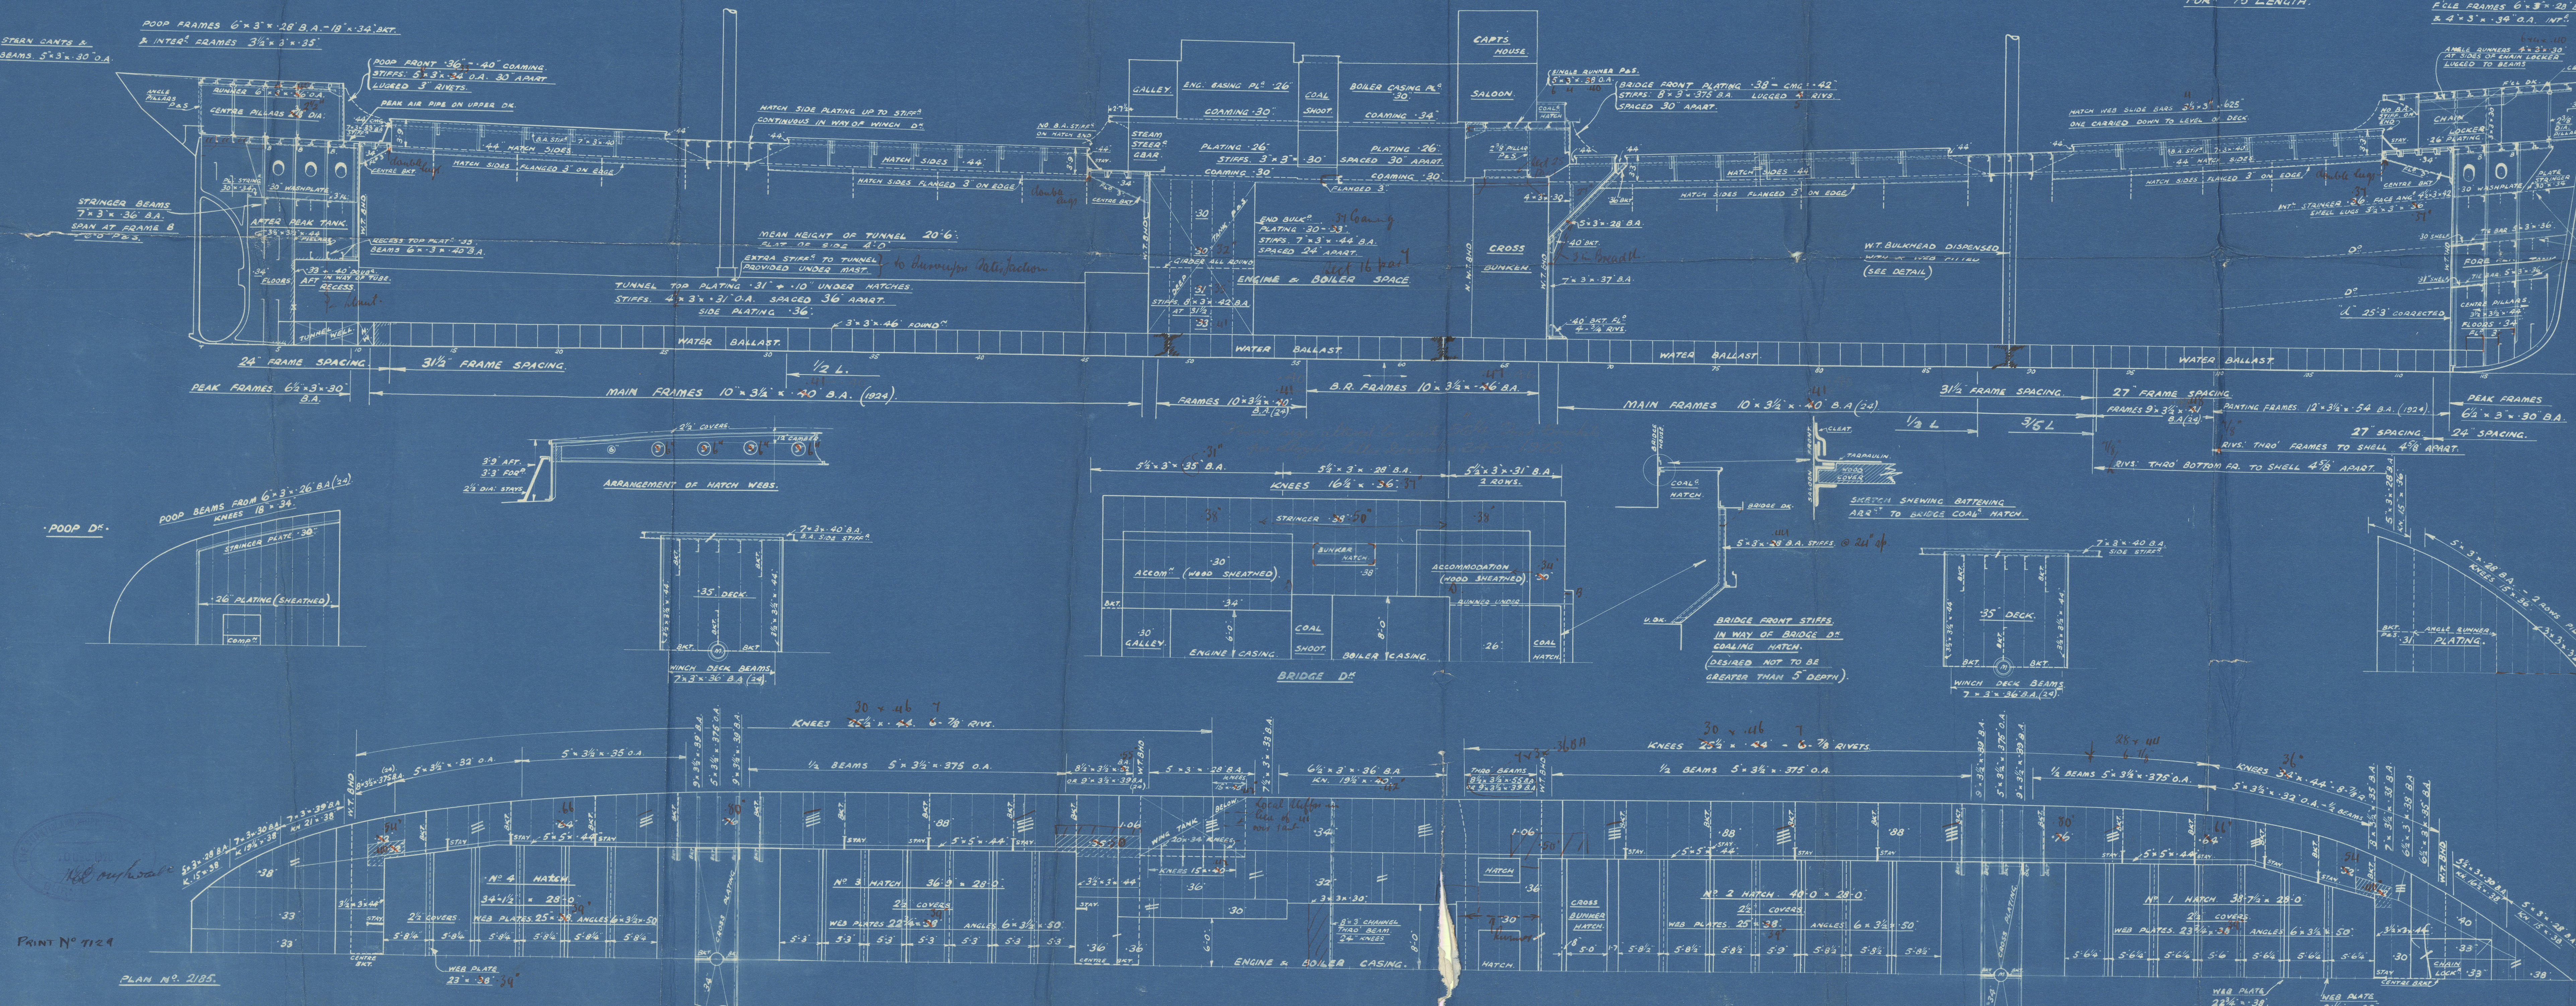

PRINT N^o 7124

PLAN N^o 2185.

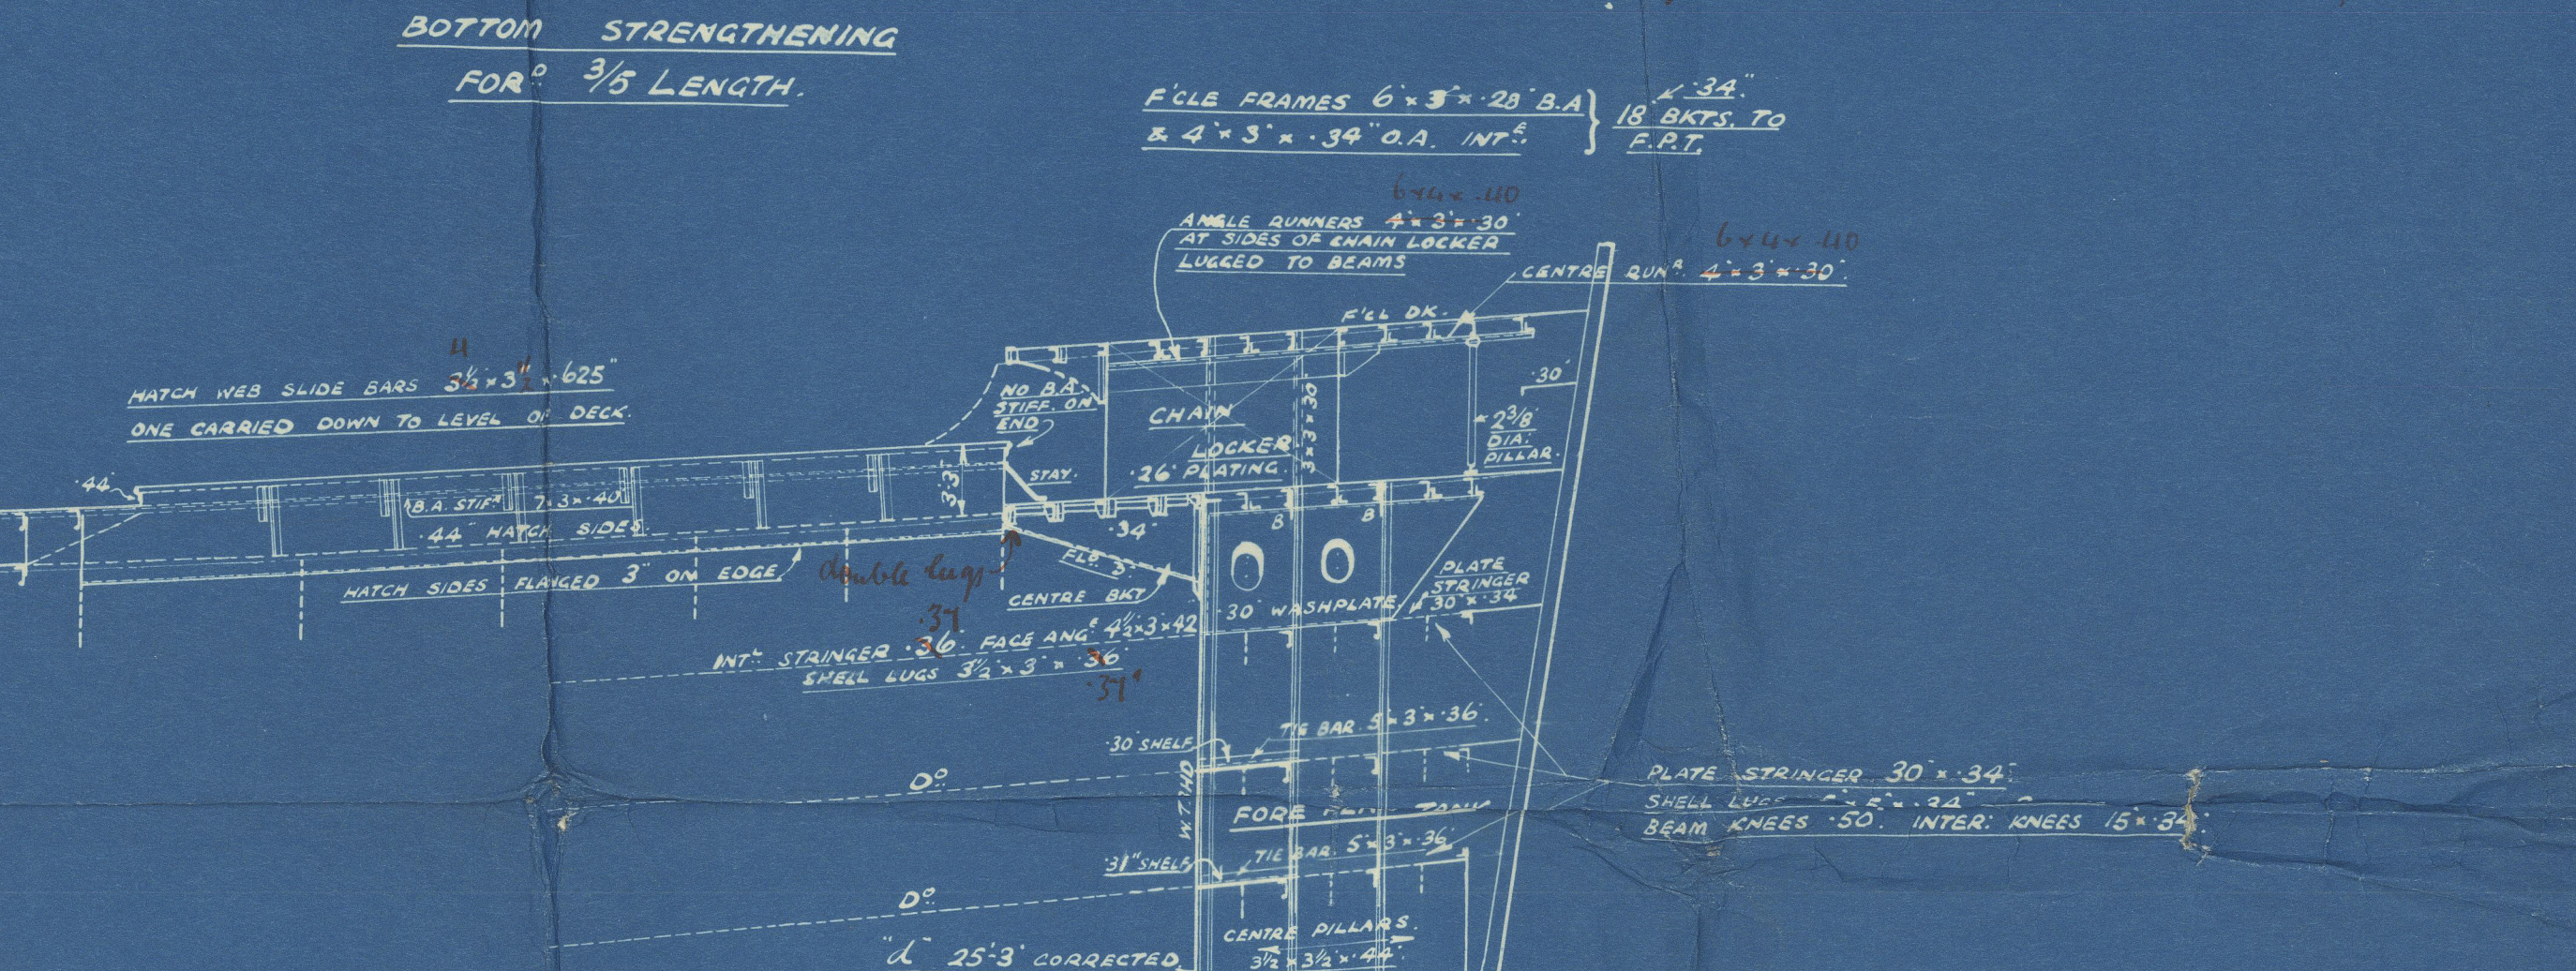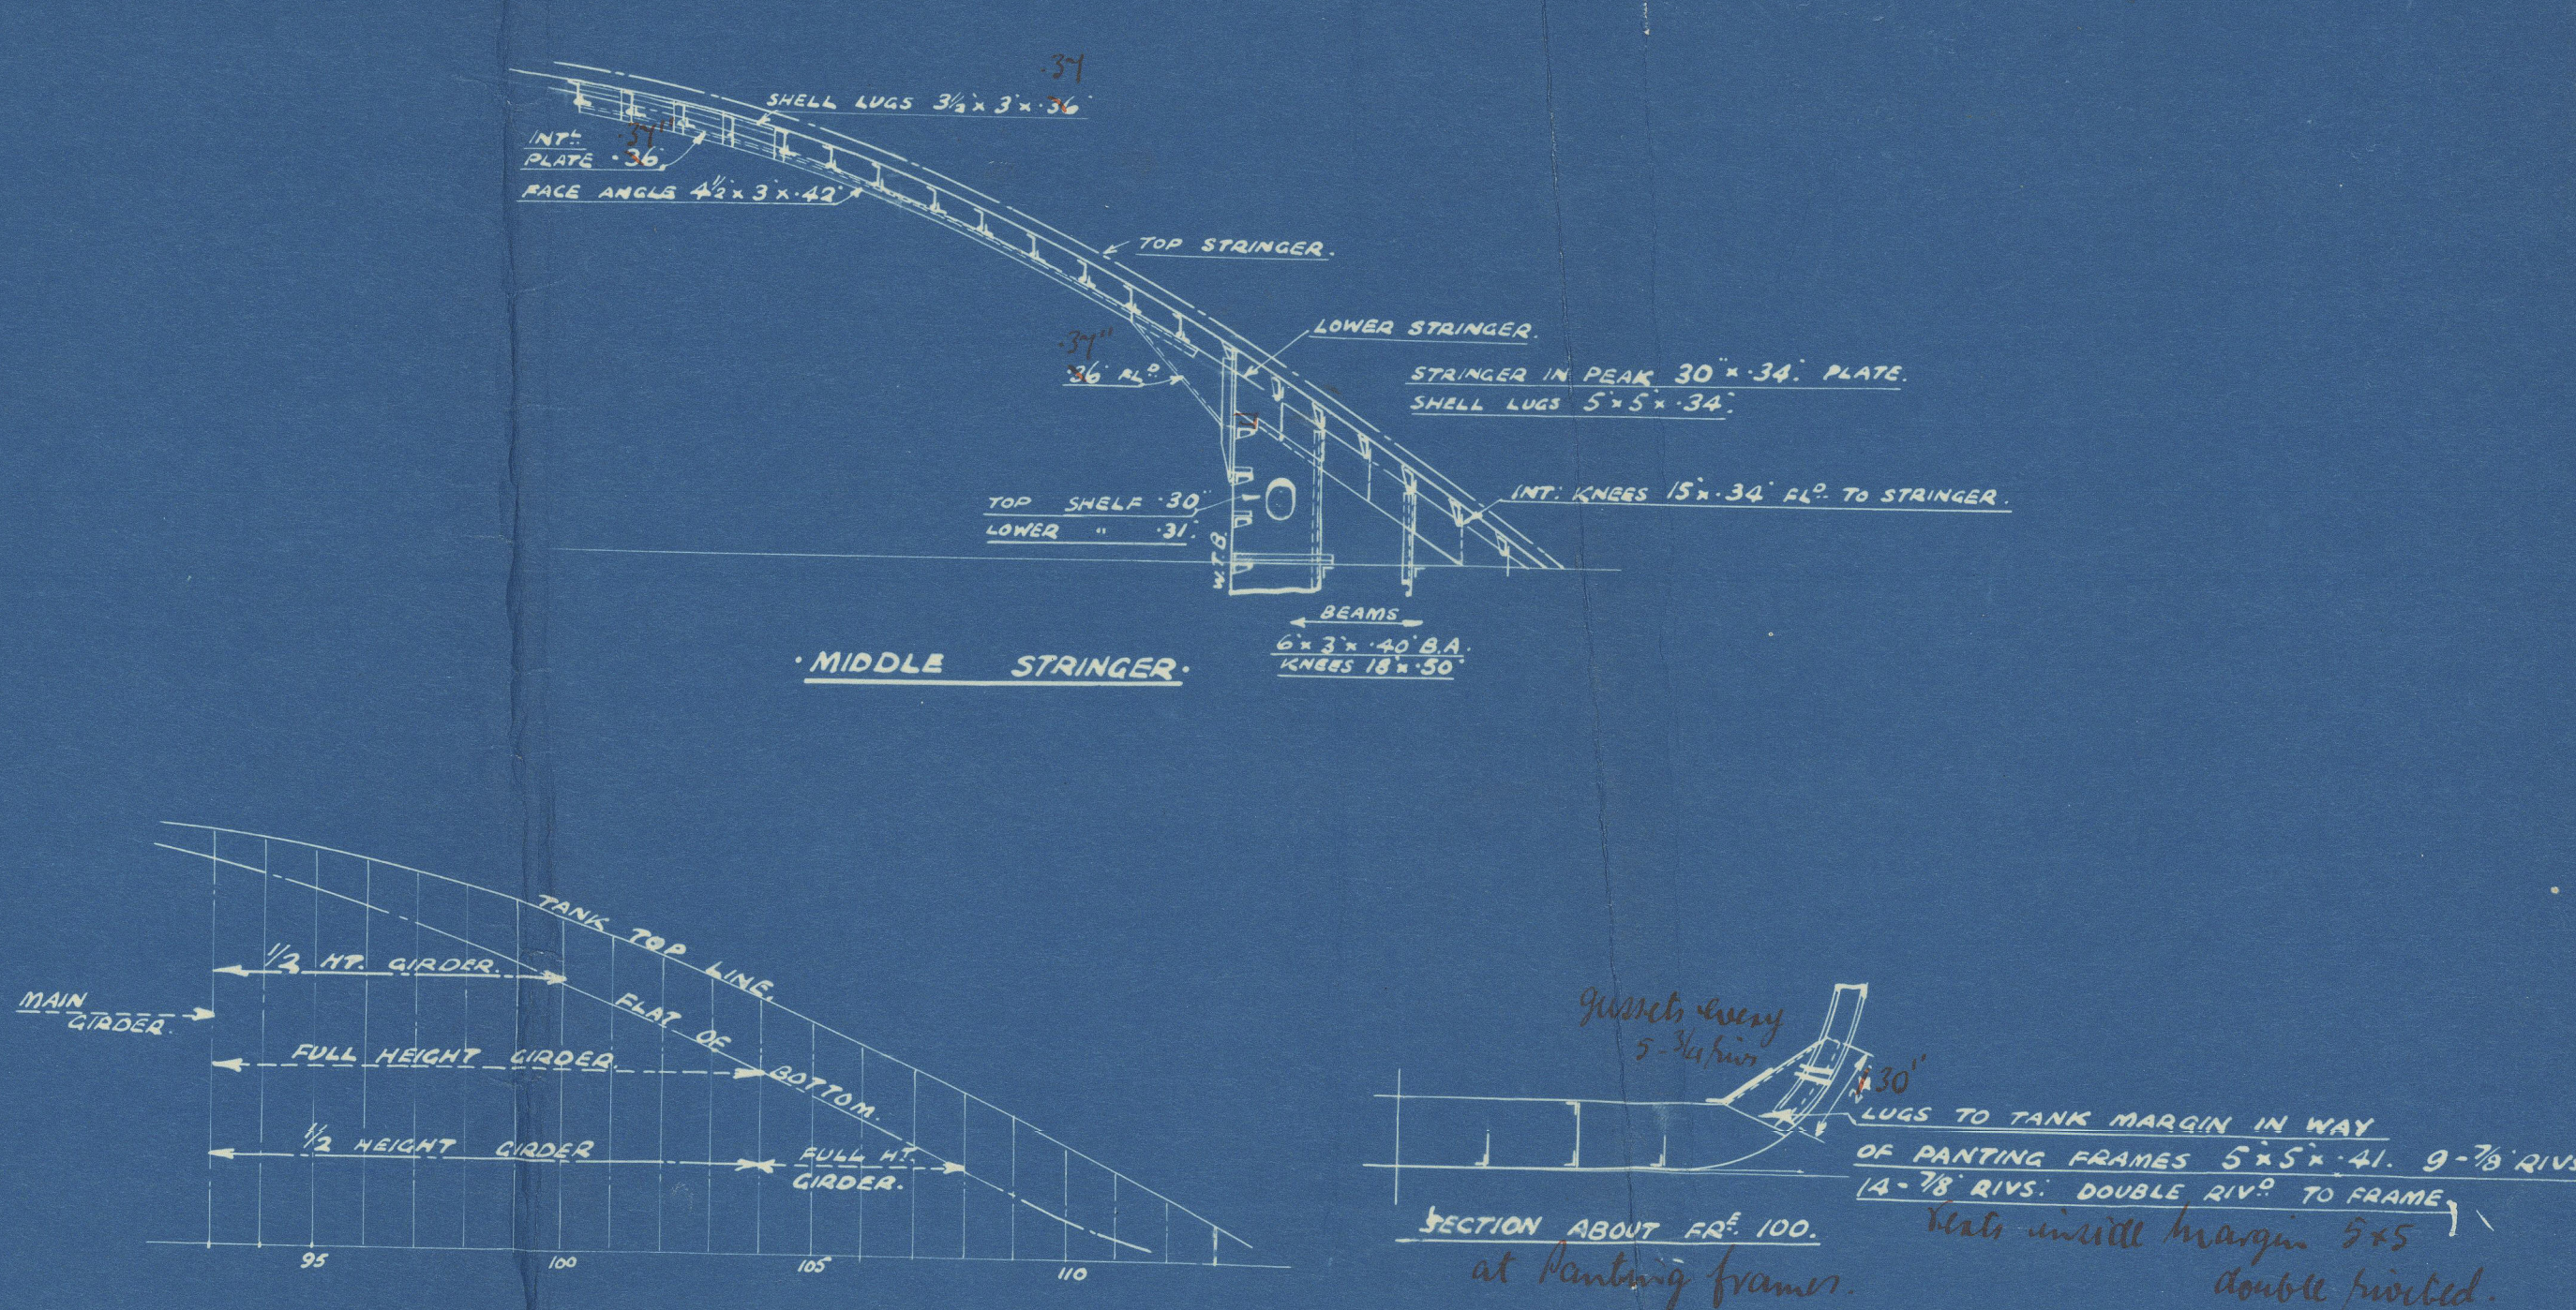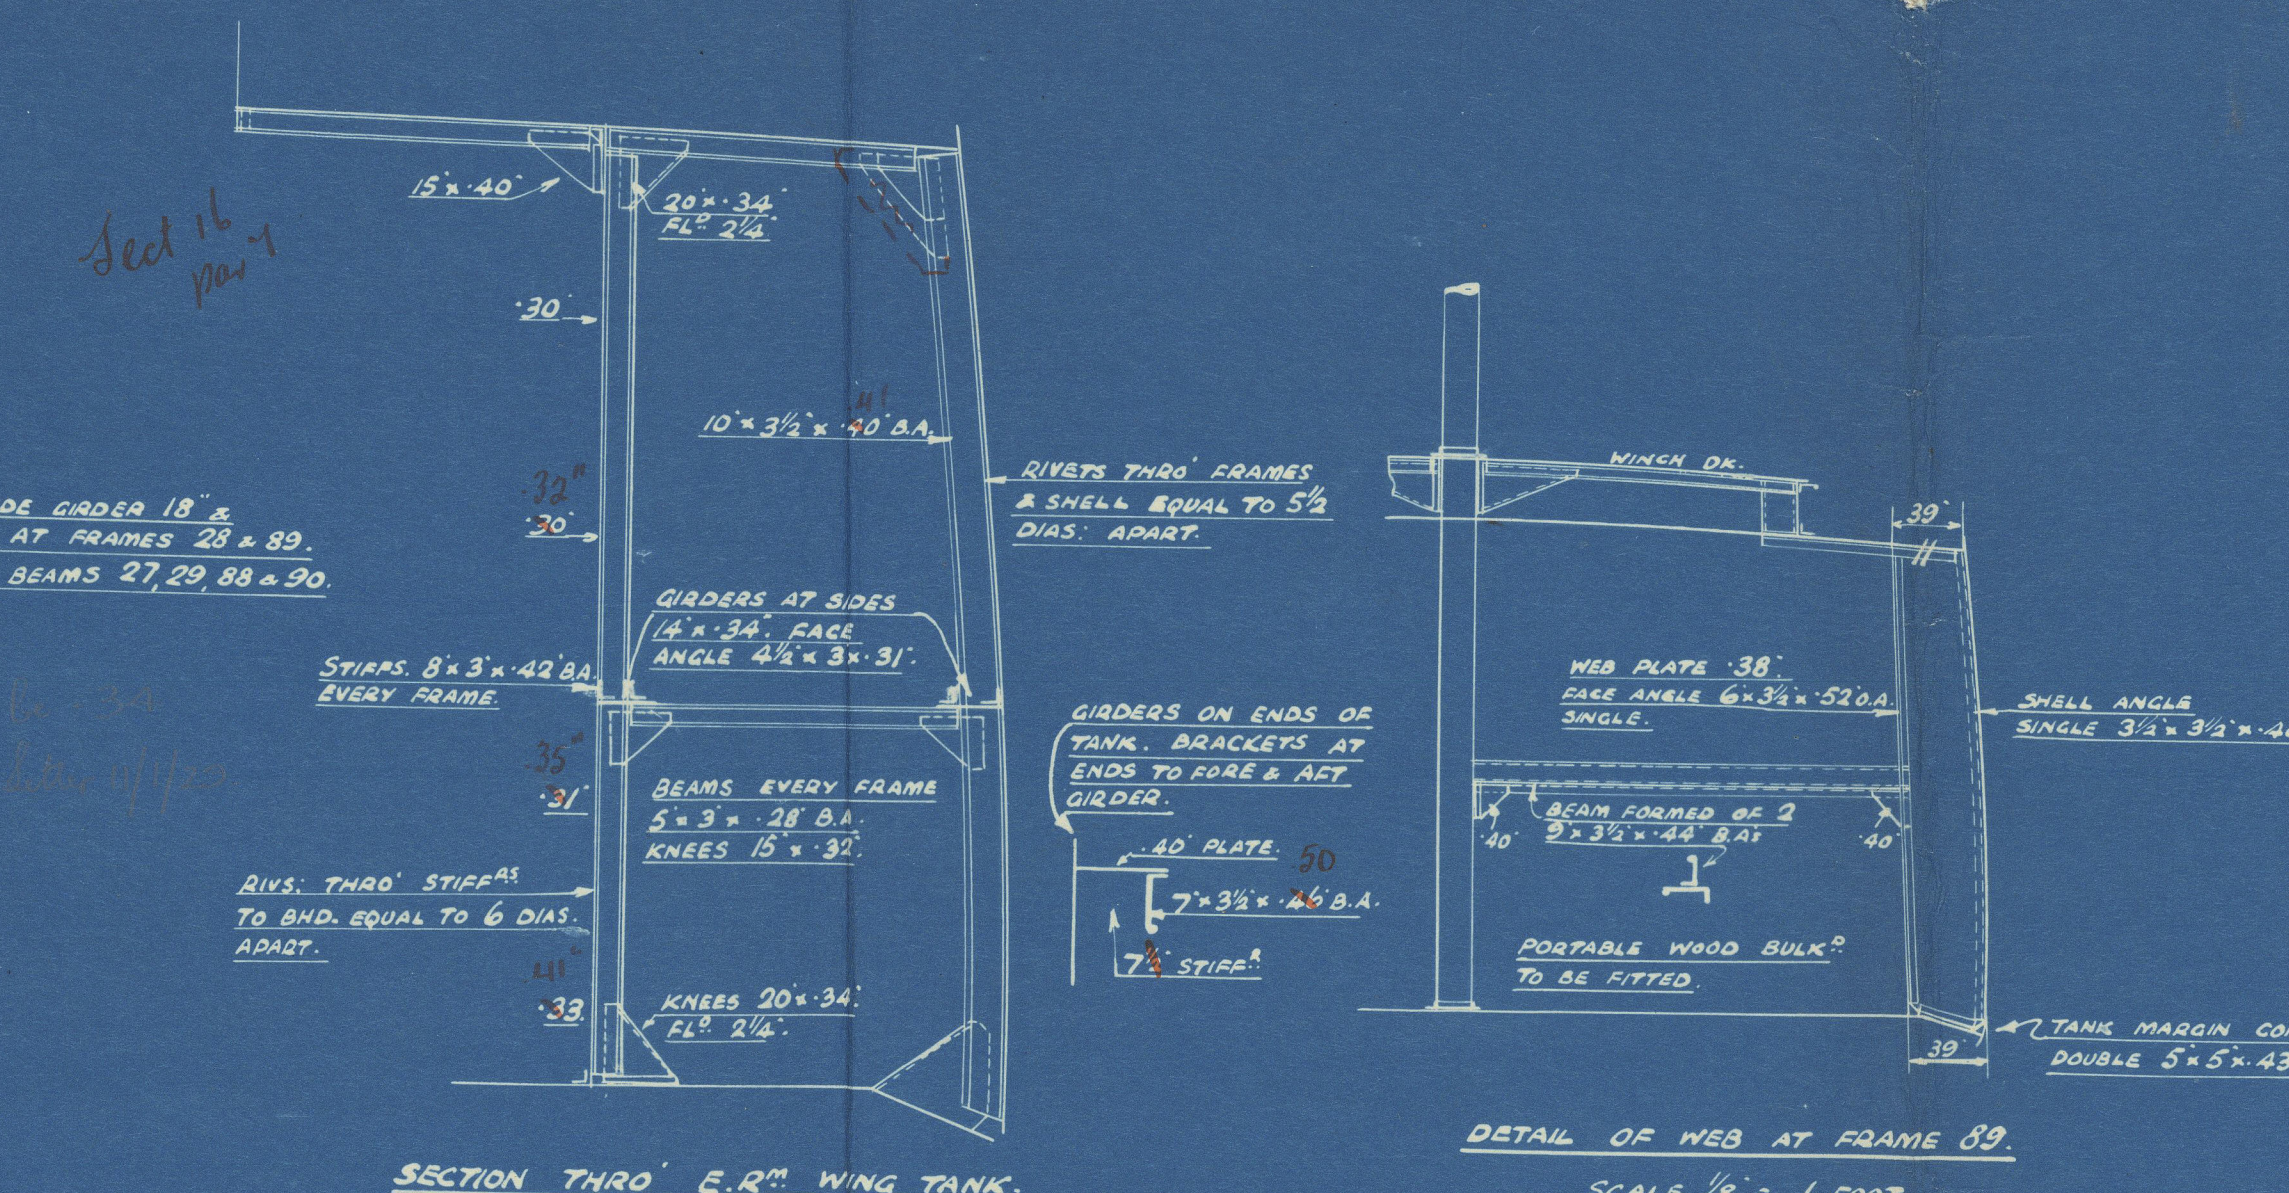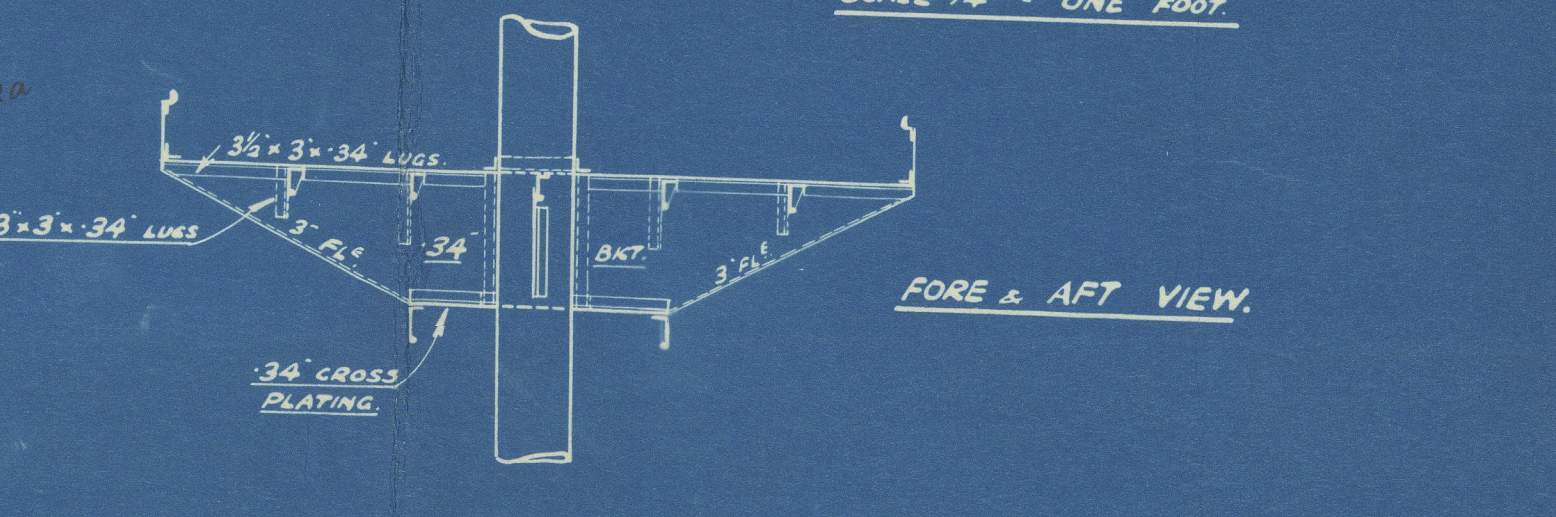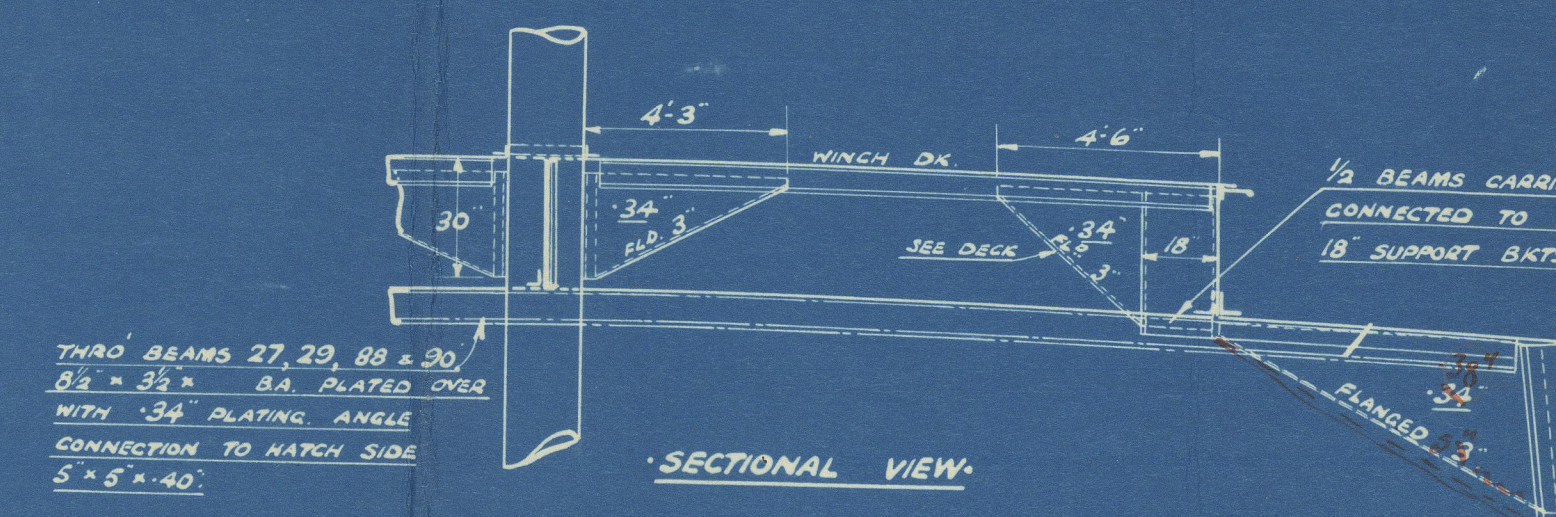

APPROVED
LLOYD'S REGISTER OF SHIPPING
Signature
DATE 10-11-18

Burntisland S.B.C^o
N^o 154

Profile & Decks

Sarastone

Lth. 17632.



© 2019

Lloyd's Register
Foundation

W215-0071