
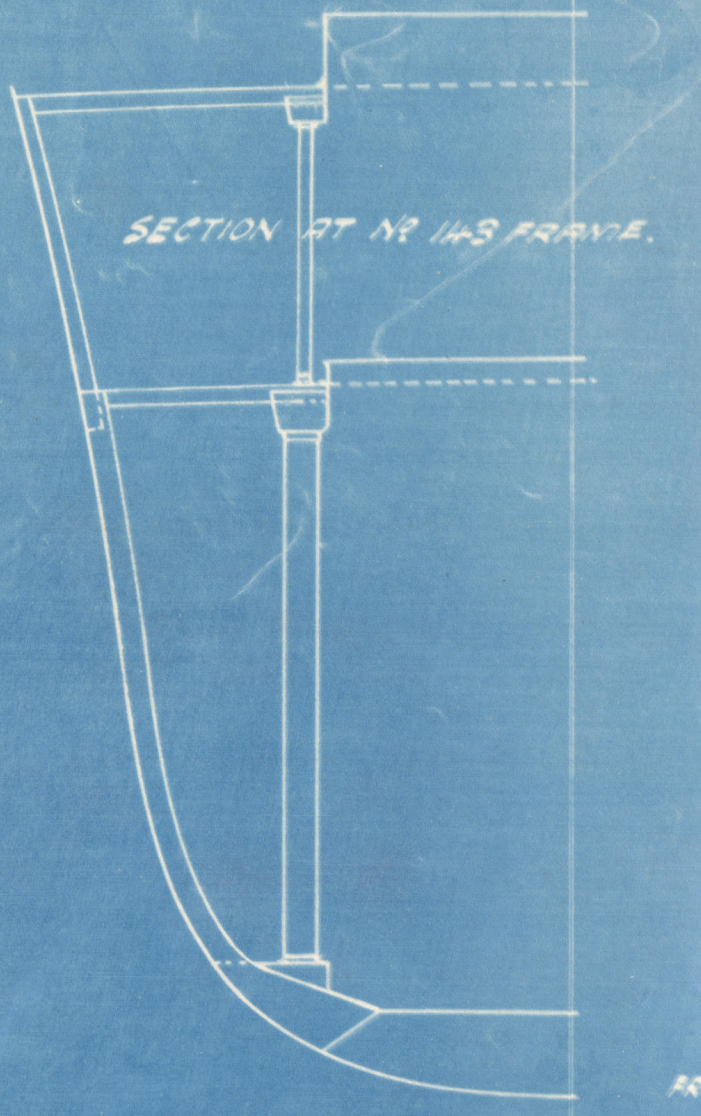


— SINGLE SCREW MOTOR VESSEL —
"SILVERAY."
LLOYDS 100A.I. CLASS.
COMPLETE SUPERSTRUCTURE TYPE,
WITH POOP BRIDGE & TOP GALLANT FORECASTLE.
SCALE 1/8" = 1 FOOT.

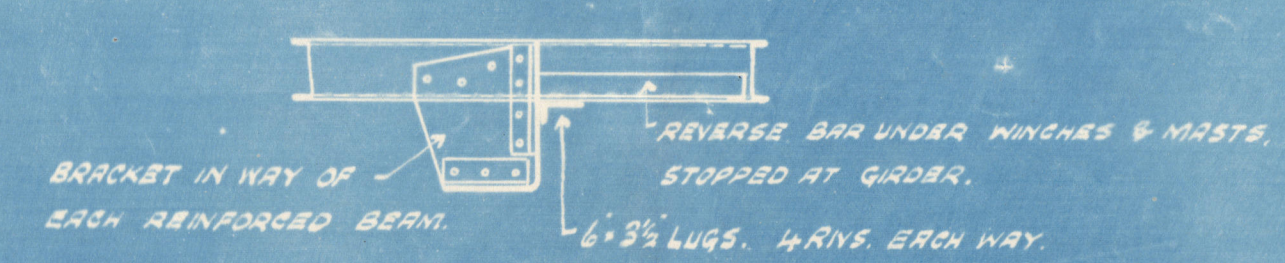

See notes on change
to be done for this intent

See approved for alteration only

10/20/1
3534
19/1/35

SUNDERLAND.

MESSRS. J. L. THOMPSON & SONS.

M. V. "SILVERAY."

PROFILE

\H 217-0032



© 2019

Lloyd's Register
Foundation