


DIMENSIONS:- 252'-10½" B.P. x 37'-0" B.M.L.D. x 24'-²²~~8~~" D.M.L.D. TO UPPER DK

SCALE. - $\frac{1}{8}" = 1 \text{ FOOT.}$

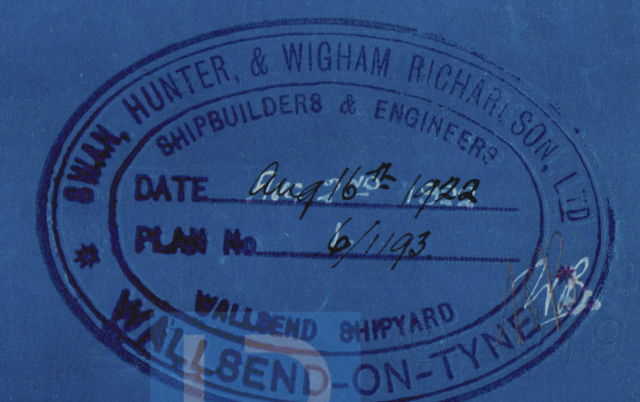

5.

Swan Hunter & W. Richardson

S.S. 1193

Profile & Decks
(Amended).


Stanlake
~~ex~~

S.S. Margorie S.

NEWCASTLE C. LINE.

Report No. 76570

Stanlake

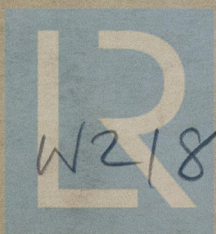

© 2019

W218

Lloyd's Register
Foundation