


LOYD'S REGISTER
LONDON
1847-1850

9.4.14
12.5.14
29.5.14

S.S. 184 F/185. PROFILE AND DECKS

DIMENSIONS:- 240 BP x 36'6" EXT 15'4" MLD.
CLASS 100A.1.

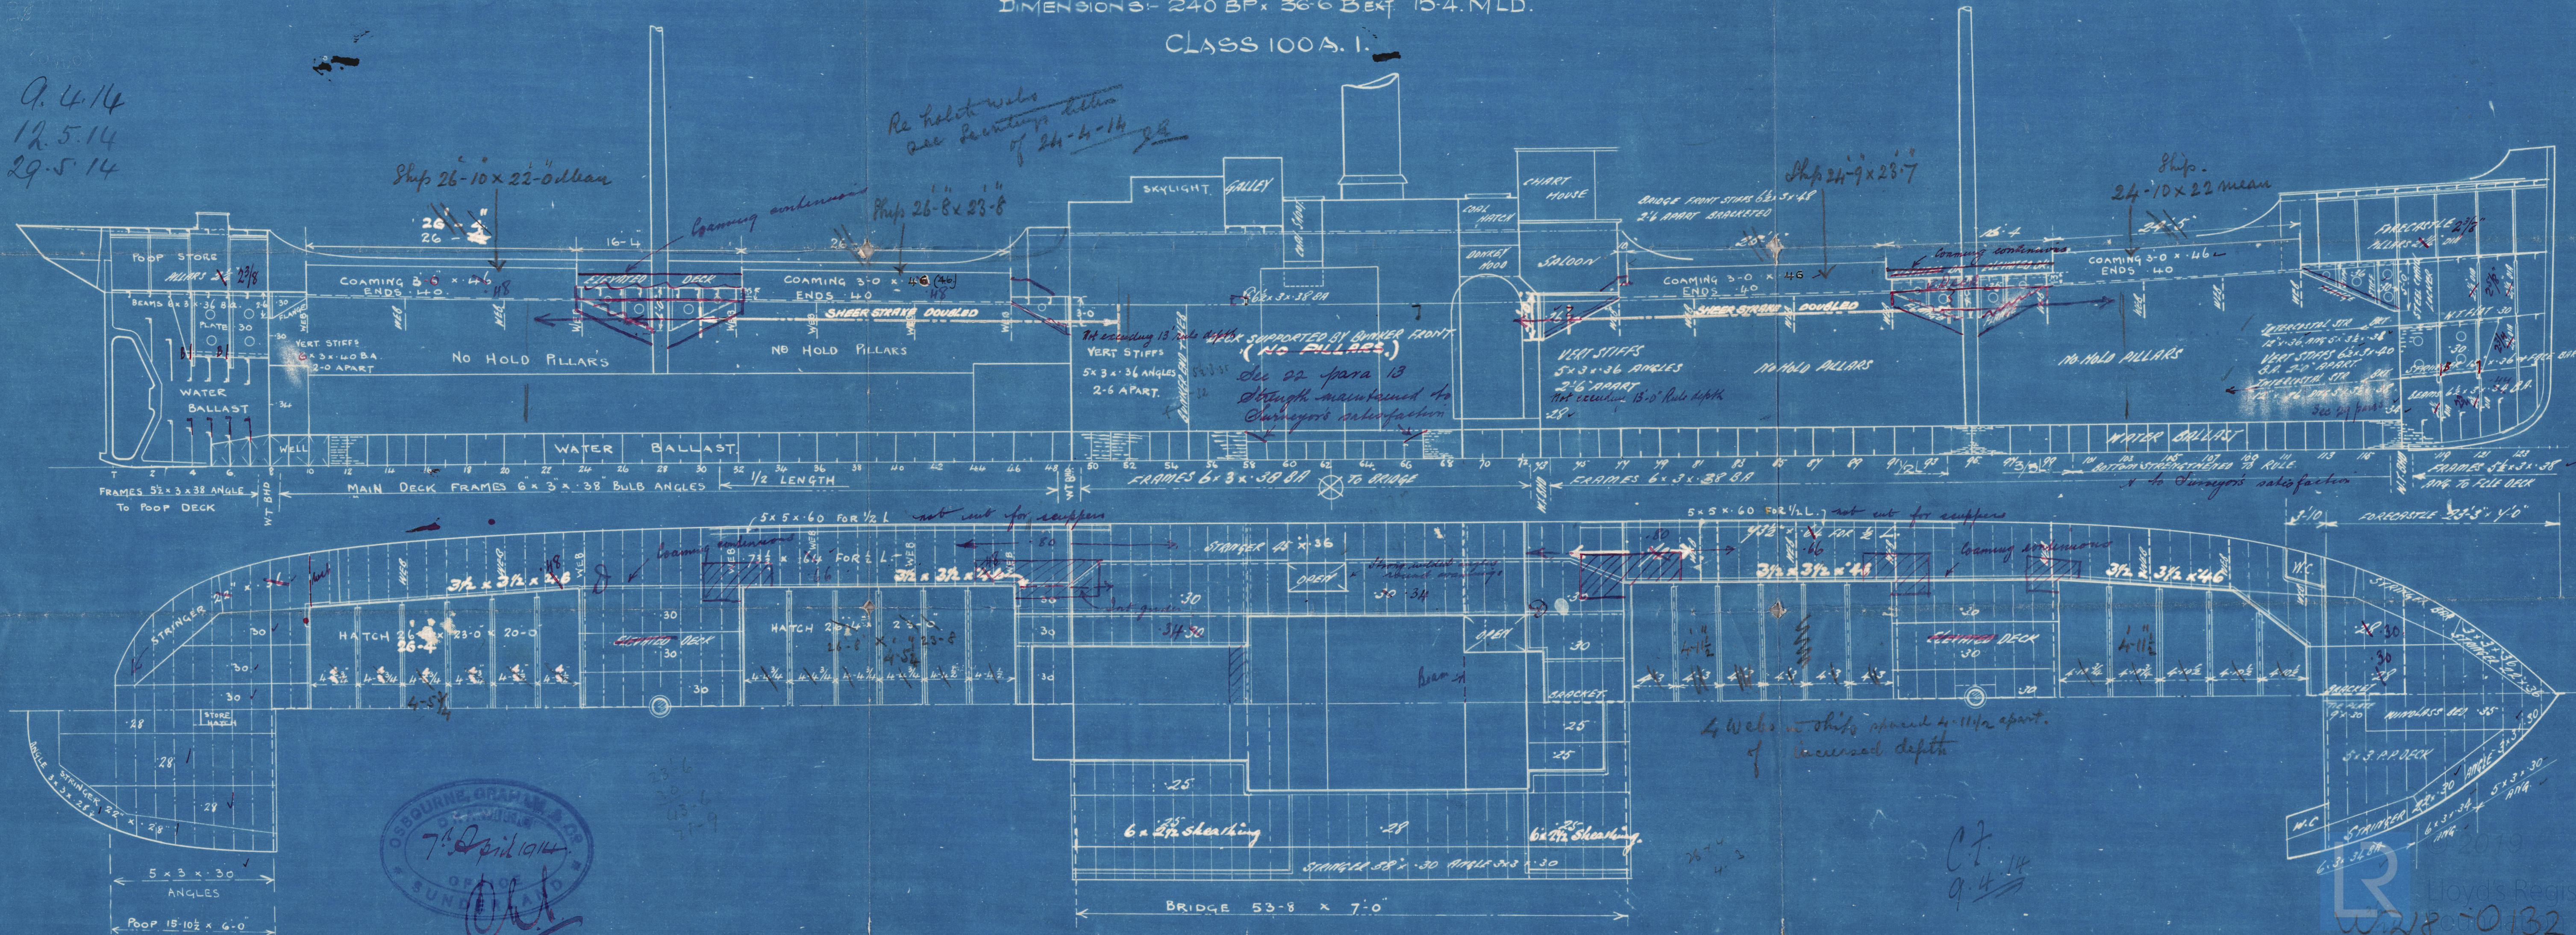

7th April 1914
C.7.
9.4.14


Lloyd's Register
W.2.8.10.132




185 Plate
188 Kiel land. p. p. p.
189 " " "
186 Omaha float

OSBOURNE, GRAHAM & CO.
SHIPBUILDERS,
HYLTON,
SUNDERLAND

184 1/2 Belge
N.N. Swynfleet
SUNDERLAND RPT. NO. 26323

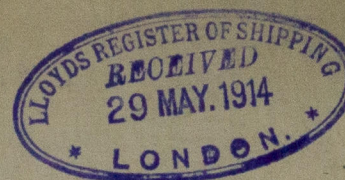


OSBOURNE, GRAHAM & CO.,
SHIPBUILDERS,
HYLTON,
SUNDERLAND

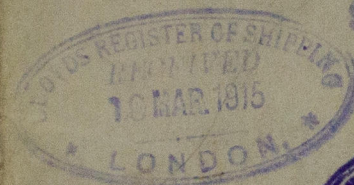

W 218 - 0132

PROFILE

Nos 184 & 185

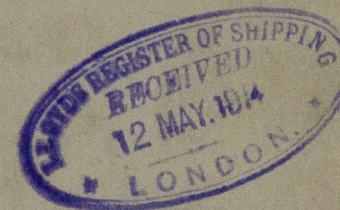

185 "Francia"

SUNDERLAND RPT. NO. 26392
Foundation