


N° 709 M.  
PROFILE & DECK PLANS.

SCALE  $\frac{1}{8}$  = ONE FOOT.

DIMENSIONS 402-6 x 52-0 MLD x 29-10 MLD TO UPPER DECK.

500  
700  
20/12/24

Supports under hulls, keelsons, masts & to davings, ballast tank.

 

APPRO  
LLOYD'S REGISTER OF SHIPPING  
Monte Carlo  
20/12/24



Profile & Decks

Penderoons


70917

Star of Suez  
ex

Martharia

GLASGOW REPORT No 45350

538  
269  
807

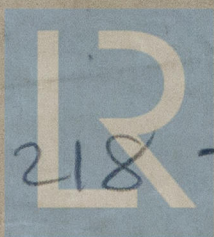

© 2019

W218 - Lloyd's Register  
Foundation