


26/5/24

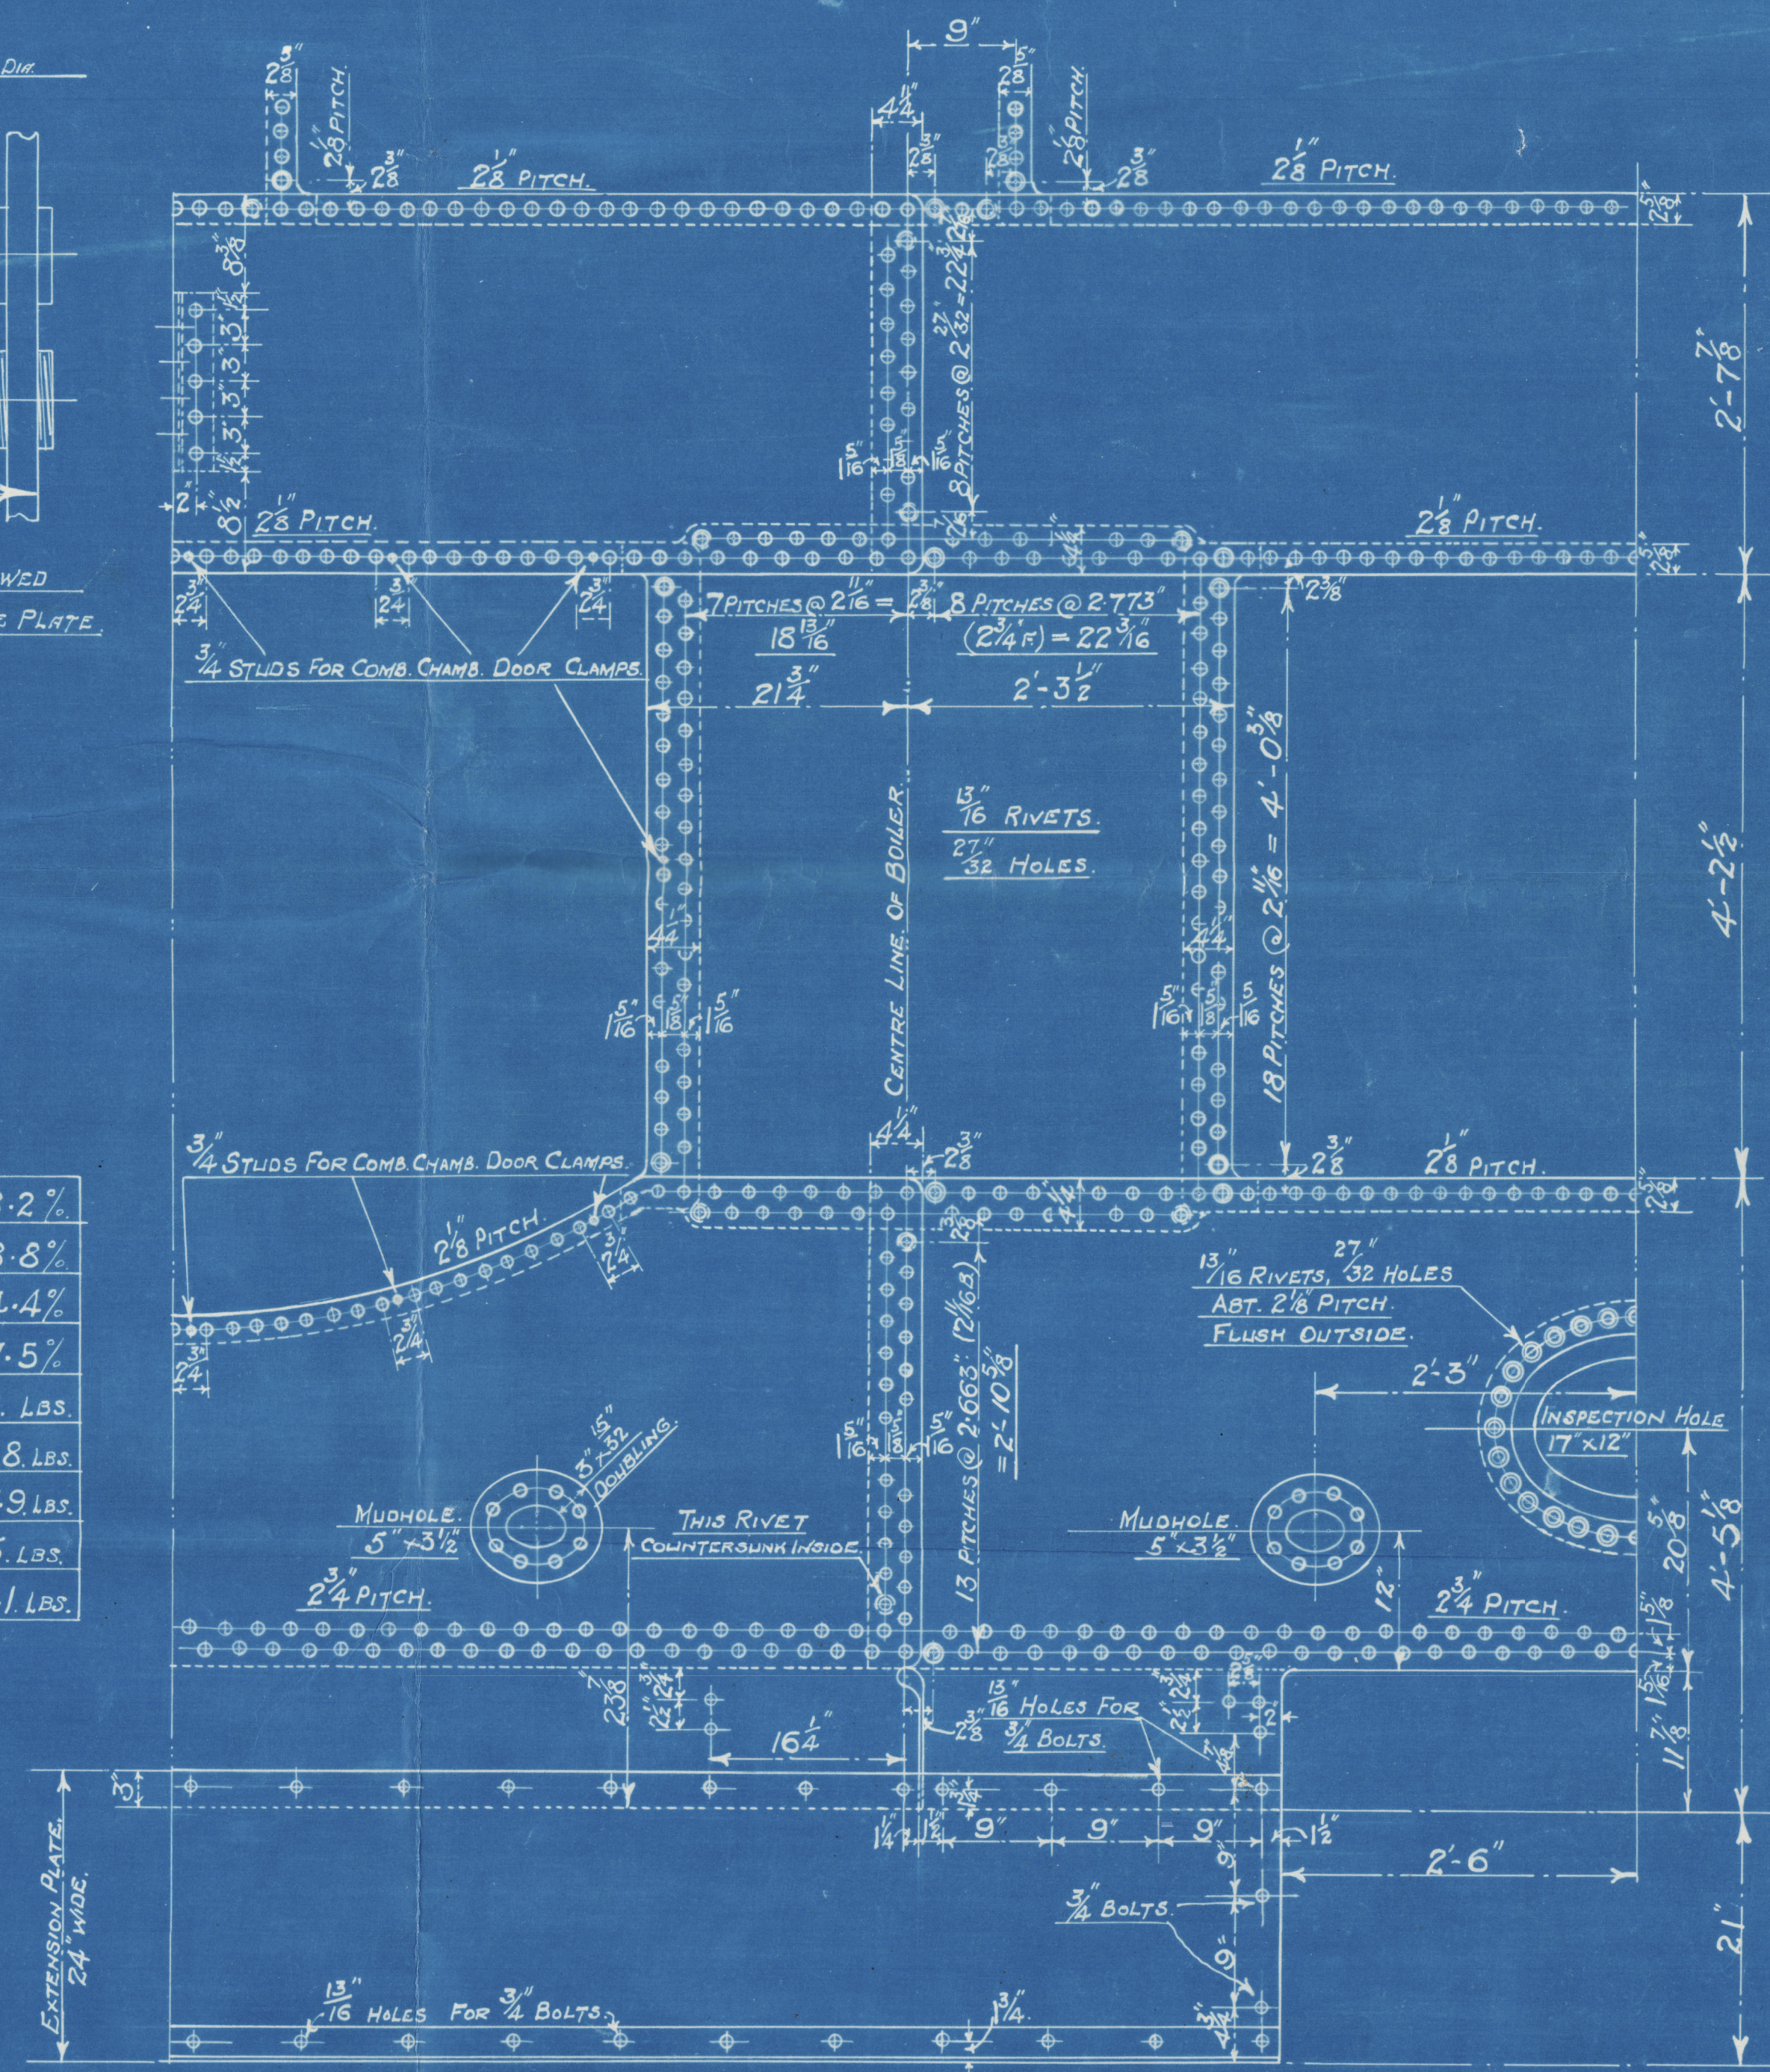

For Approval 104  
10/23/24  
23/5/24

# N.R.

9-0163

**COCHRAN & CO ANNAN LTD.**  
**ENGINEERS & BOILERMAKERS**  
**ANNAN, SCOTLAND**



Cochran & Co. Cunan Ltd.

Boiler N° 9105-

W.P. 100 lbs/sq. in.


GLASGOW REPORT No. 43796.

City of Stockholm

Attached to

GLASGOW REPORT No. 44971

(Boiler subsequently  
fitted on M.V. "Storsten".  
Report attached to  
Glas. rpt. No. 48013)

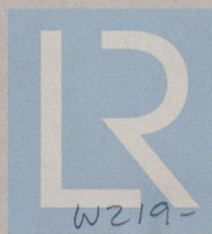

© 2019

Lloyd's Register  
Foundation

W219-0163