



4/2/28

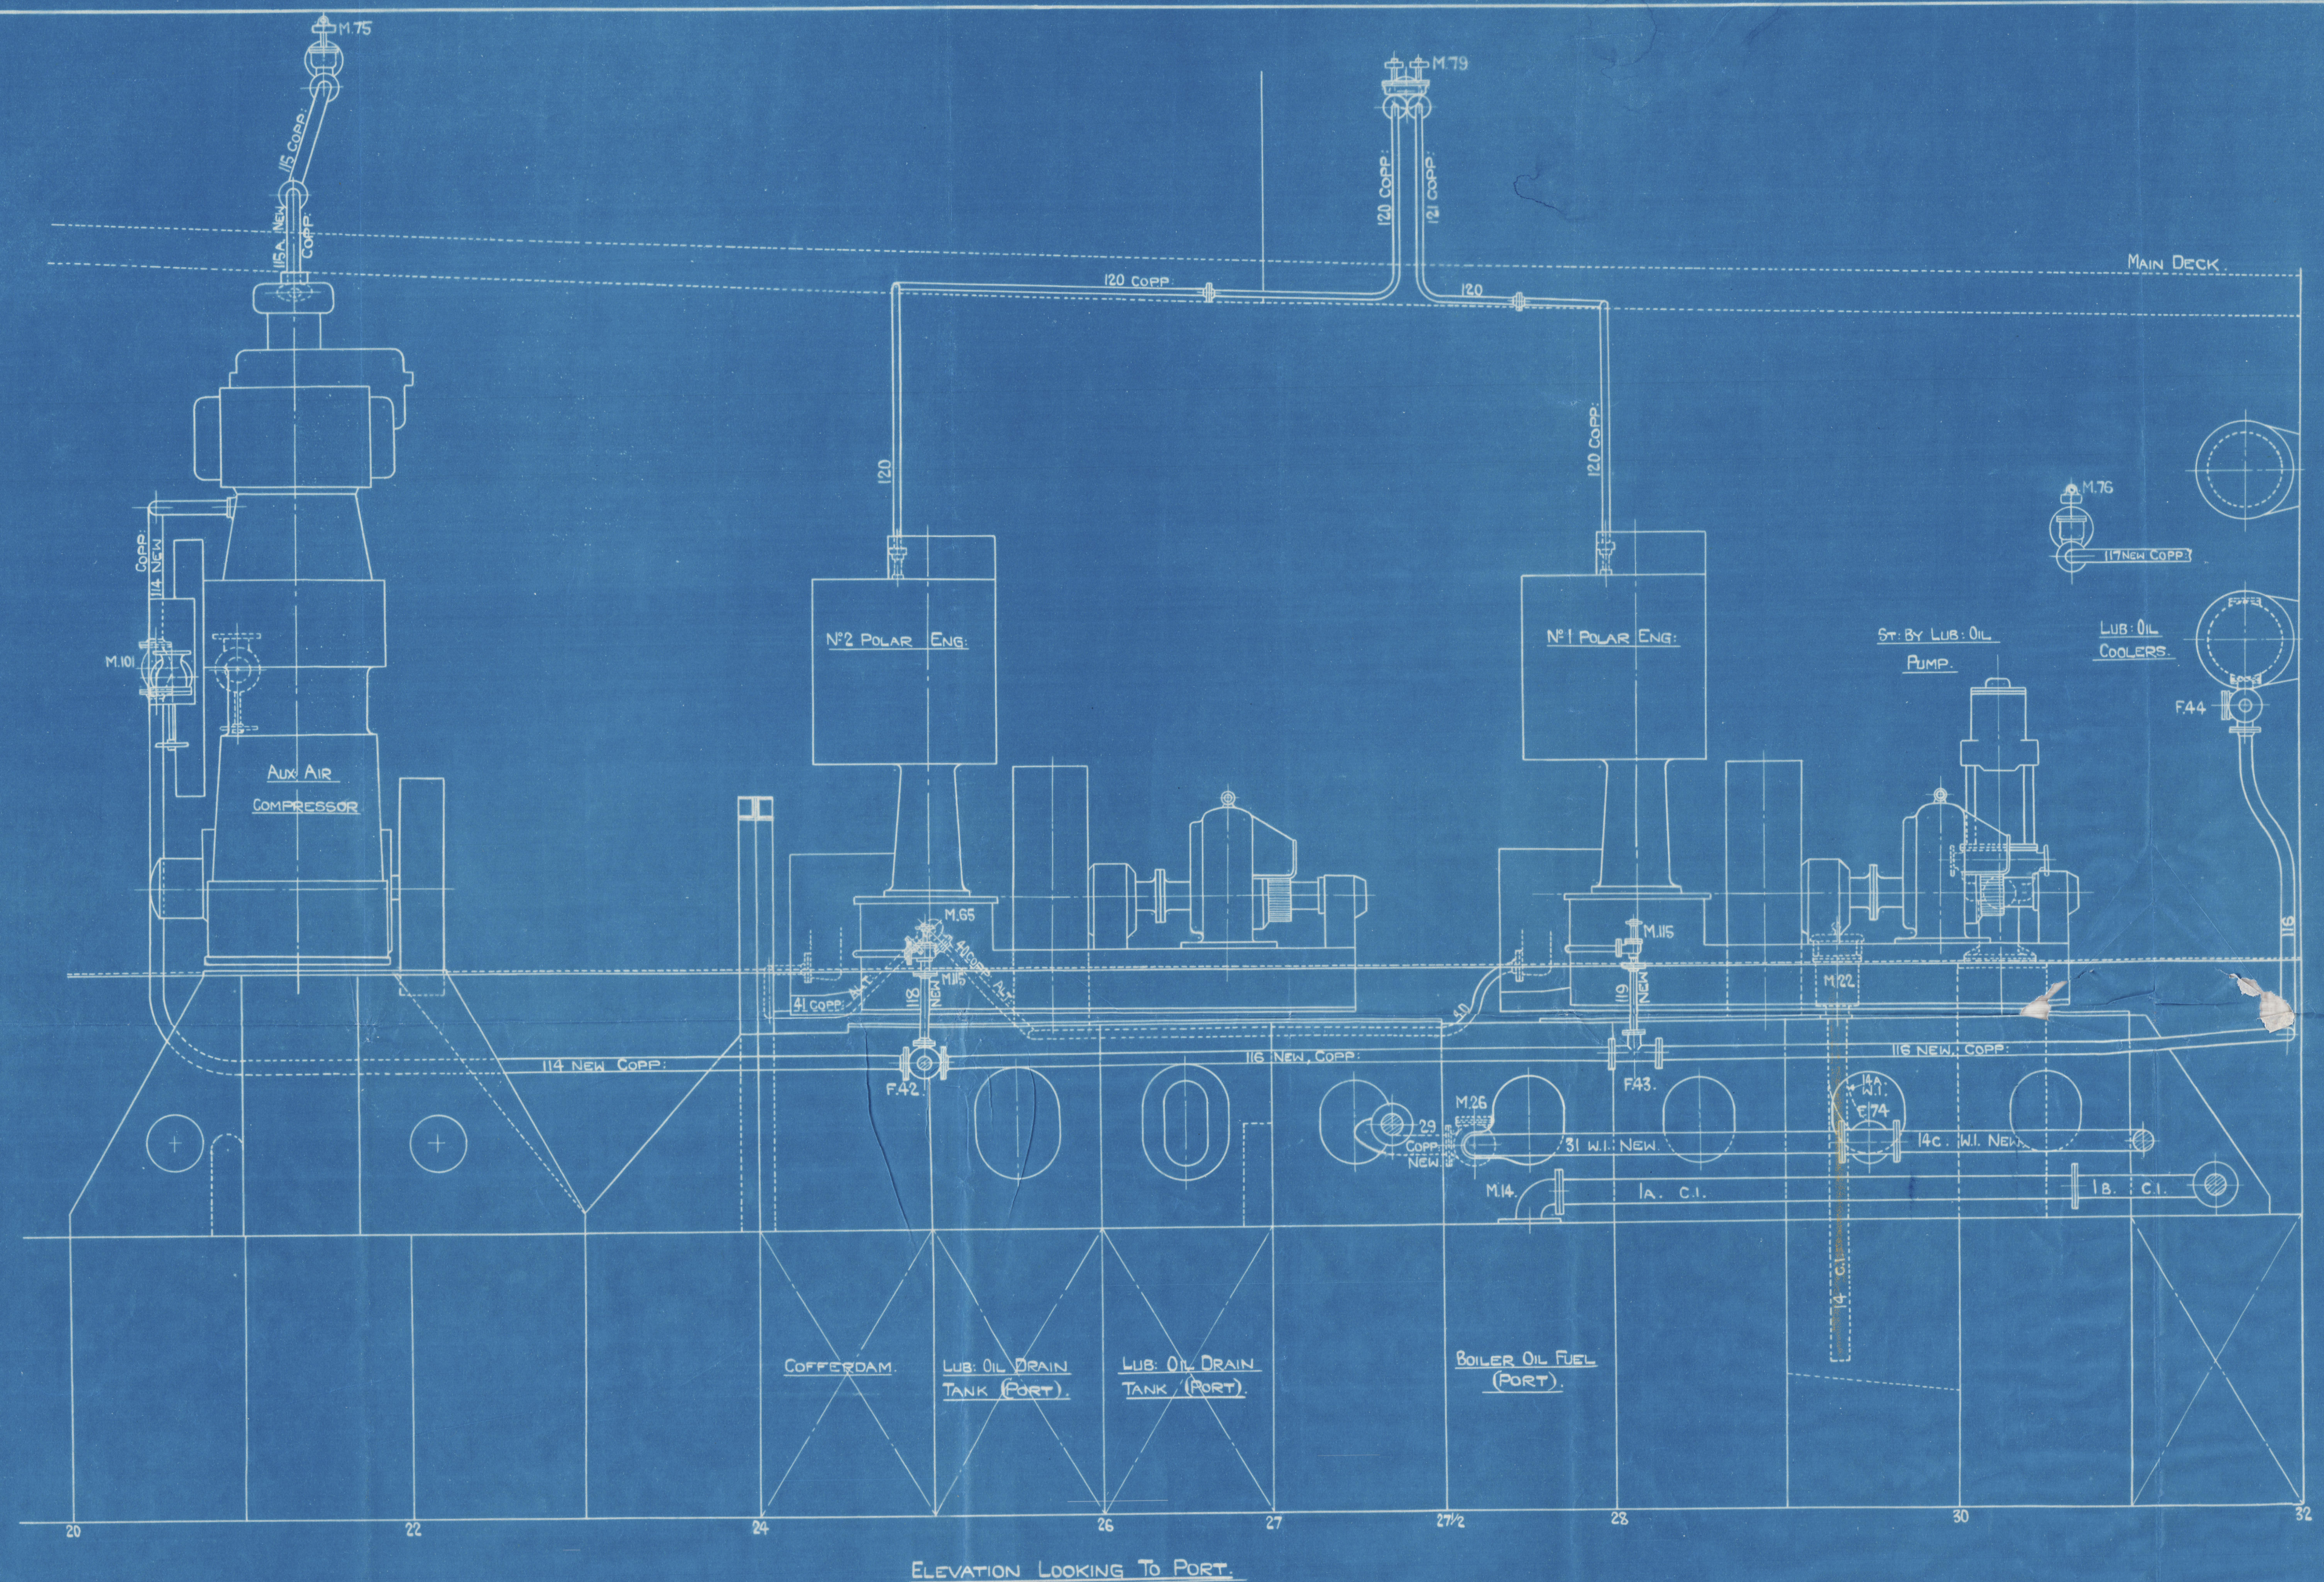

ELEVATION LOOKING TO PORT.

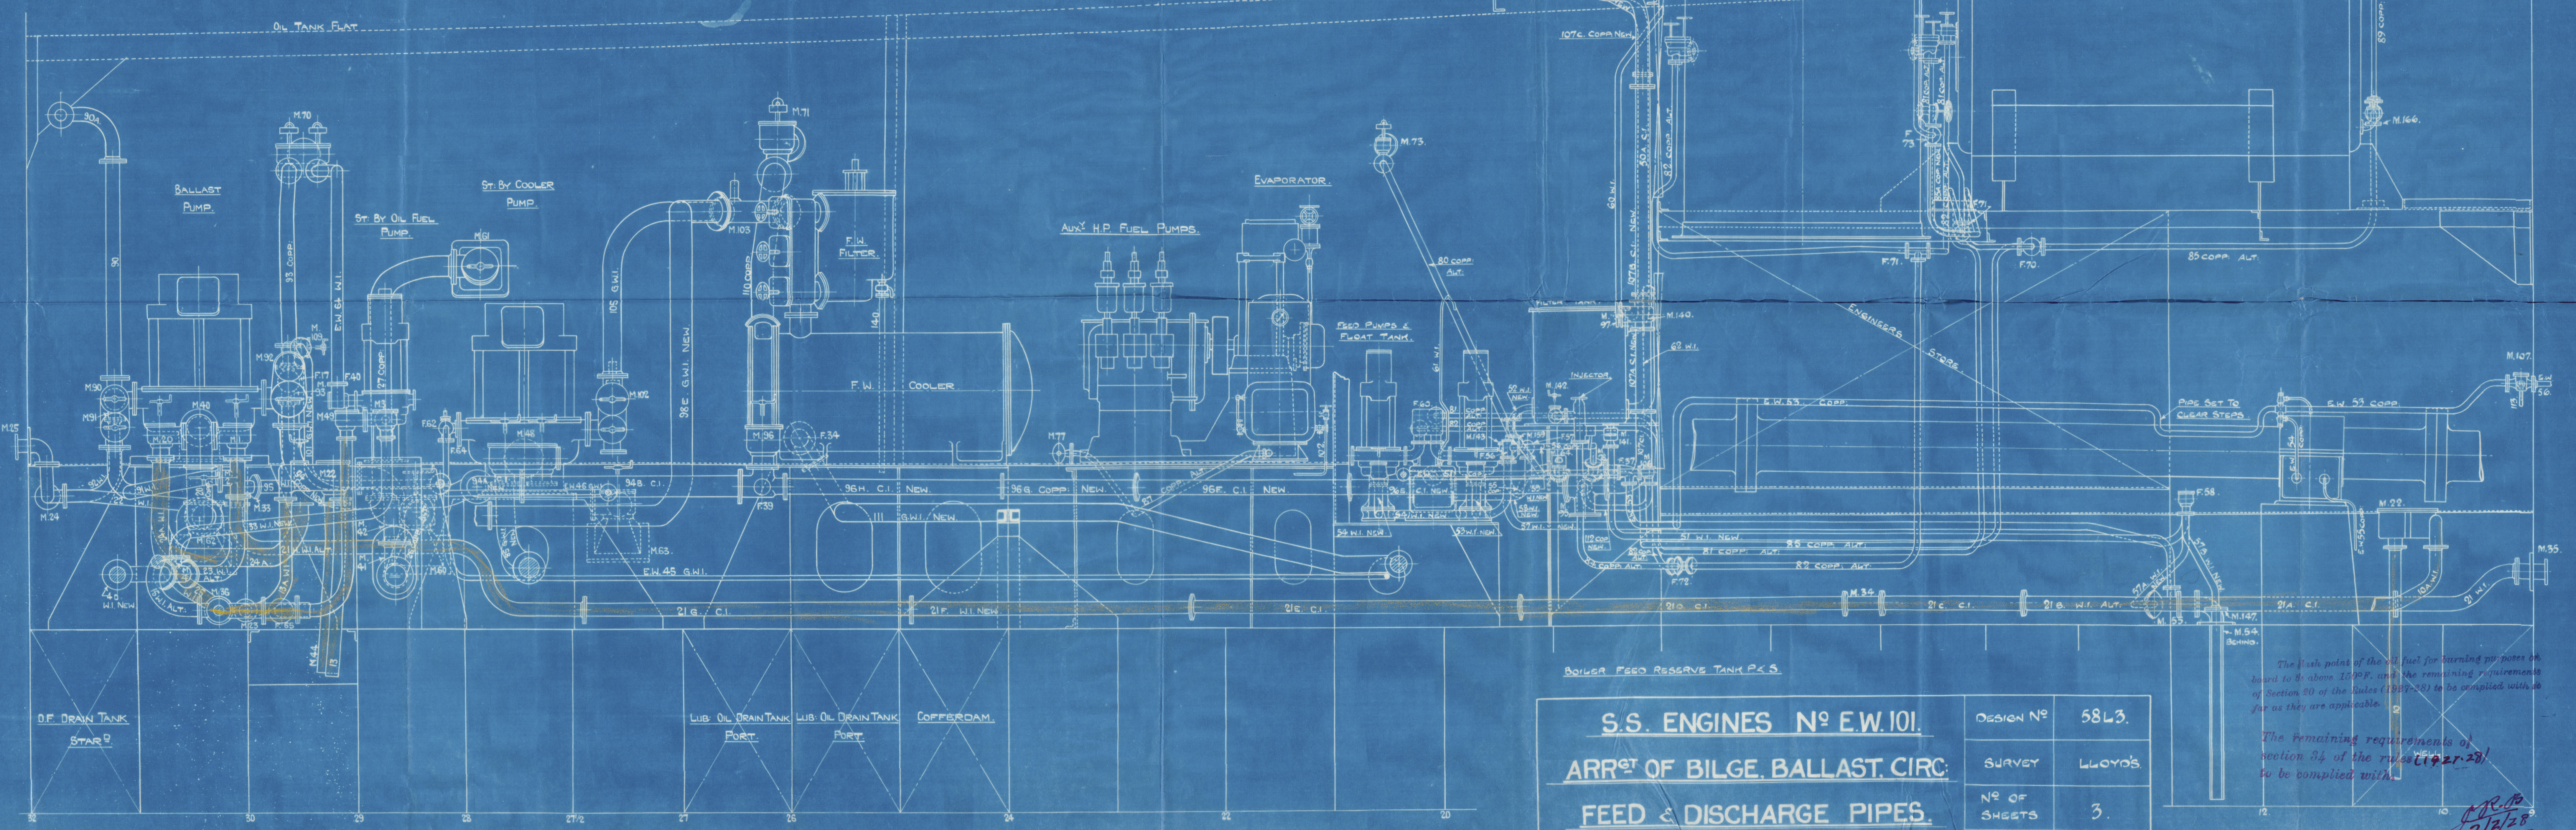

ELEVATION LOOKING TO STARBOARD.

S.S. ENGINES N° E.W.101.				DESIGN N°	58L3.
ARR' OF BILGE BALLAST CIRC.				SURVEY	LOYD'S
FEED & DISCHARGE PIPES.				N° OF SHEETS	3.
SCALE: 1/2" = 1 FOOT.				SHEET N°	2.
DATE	DRAWN BY	TRACED BY	CHECKED BY	ISSUE TO	DRAWING N°
					29.

The fresh point of the oil fuel for burning purposes on board to be above 100°F. and the remaining requirements of Section 20 of the Rules (1927-28) to be complied with as far as they are applicable.

The remaining requirements of section 34 of the Rules (1927-28) to be complied with.

4/2/28
Lloyd's Register Foundation

x

Amended
Bilge & Ballast Pumping Arrangements

M.J. STORSTEN.

Barclay Furlis. No. EW 101

GLASGOW REPORT No 48013



© 2019

Lloyd's Register
Foundation

WZ19-0224