



9526 A.

S.S. SUSANA DIAGRAM OF BALLAST & O.F. SUCTION & FILLING PIPES

FOR DIAGRAM OF OIL FUEL DISCH. PIPES SEE
 DRG N° 9548.A



W220-0028

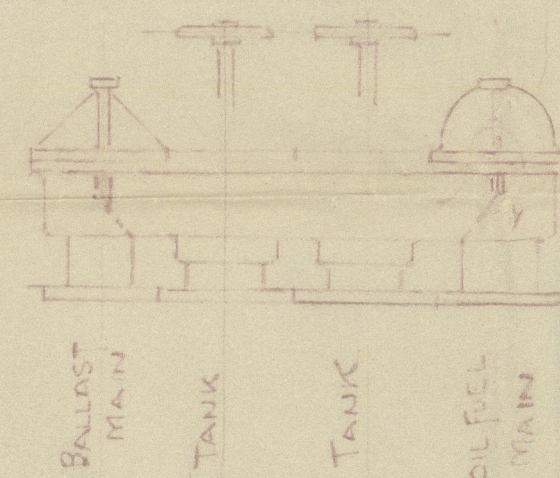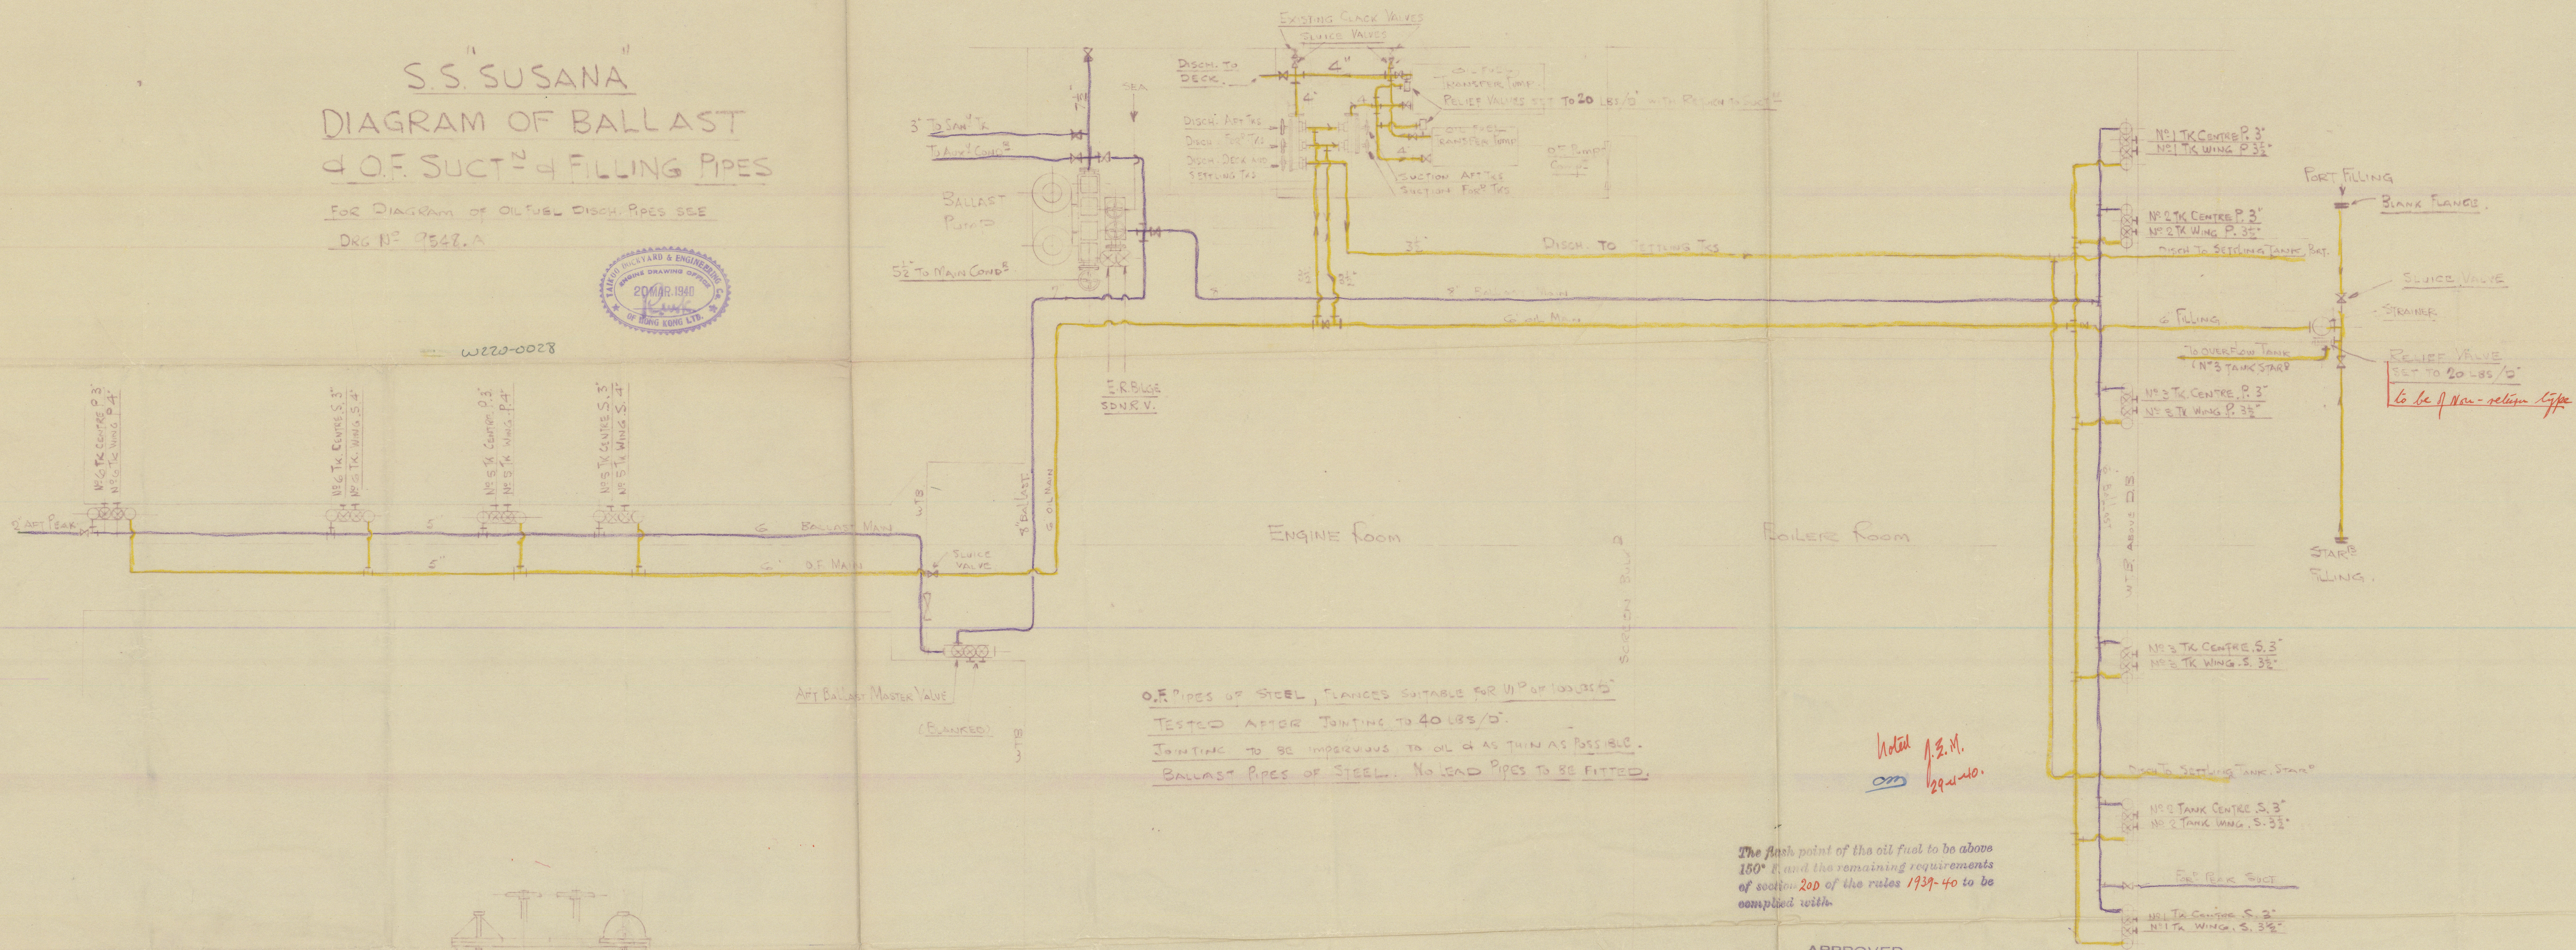


DETAIL OF ISOLATING VALVE CHEST

O.F. PIPES OF STEEL, FLANGES SUITABLE FOR 1/2" OF 100 LBS/SQ. IN.
 TESTED AFTER JOINTING TO 40 LBS/SQ. IN.
 JOINTING TO BE IMPERVIOUS TO OIL & AS THIN AS POSSIBLE.
 BALLAST PIPES OF STEEL. NO LEAD PIPES TO BE FITTED.

Noted J.S.M.
 29-4-40.

The flash point of the oil fuel to be above 150° F. and the remaining requirements of section 200 of the rules 1939-40 to be complied with.

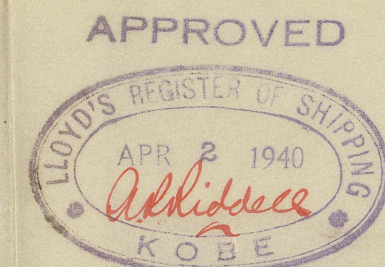

DRAWING N° 9526 A

W220-0028