

2.2.15
23.2.12

S.S. 191/192
PROFILE AND DECK PLANS
1:100.


LENGTH BETWEEN PERP. 421' 10"
BREADTH 56' 0"
DEPTH TO UPPERDECK 32' 5 1/2"

CLASS 100 A 1
TRANSVERSE NUMBER 88° 53'
LONGITUDINAL 373° 15'



HATCHWAY		LENGTH	BREADTH	PERCENTAGE OF SILL CLOSURE	PERCENTAGE OF END CLOSURE	WED	LATE	BEAMS
					$\frac{R}{B}$	$\frac{B}{T}$	INACCESS	ACCESS
I	UPPER DECK	18' 0"	16'	49%	10%	18'	24'	3 2 1/2'
	2 ND DECK	20' 0"	16'	50%	10%	18'	40'	
	UPPER DECK	18' 0"	16'	50%	90%	18'	24'	
	2 ND DECK	20' 0"	16'	50%	90%	18'	40'	
II	BROAD DECK	18' 0"	16'	40%	30%	15'	24'	
	UPPER DECK	22' 0"	16'	40%	40%	16'	36'	
	2 ND DECK	22' 0"	16'	40%	40%	16'	36'	
	UPPER DECK	22' 0"	16'	40%	40%	16'	36'	
III	2 ND DECK	"	"	40%	40%	16'	40'	
	POOP DECK	18' 0"	"	40%	36%	18'	36'	
	UPPER DECK	"	18'	40%	36%	18'	40'	
	2 ND DECK	"	"	40%	36%	18'	40'	

WEL PLATE BEAMS IN LOWER DECK HATCHWAYS AS PER TABLE

BRITISH STANDARD SECTIONS IN INCHES	GERMAN EQUIVALENT SECTIONS IN MM	BRITISH STANDARD SECTIONS IN INCHES	GERMAN EQUIVALENT SECTIONS IN MM
STEEL RIVETS		SECTIONS IN INCHES	

 


1871/12.
Tidbury

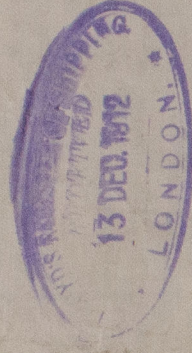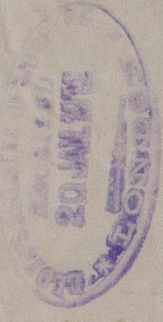

Miss. Art. Gen. Wiss. Nr. 191/92
Prof. a. D. K. pl. n.

* *Tabaristan (ex Frankfeld)*
Bm. 354.

TABARISTAN

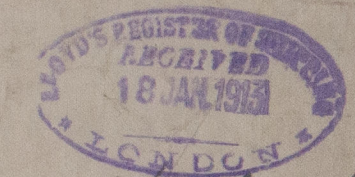

Huberfeld
Bremen 221.
Lanterfeld
Bremen 226

W220-0115

