


S/T. RYLSTON  
PROFILE SHOWING ALTERATIONS TO FORE & AFTER ENDS  
SCALE  $\frac{1}{4}" = 1 \text{ FOOT}$

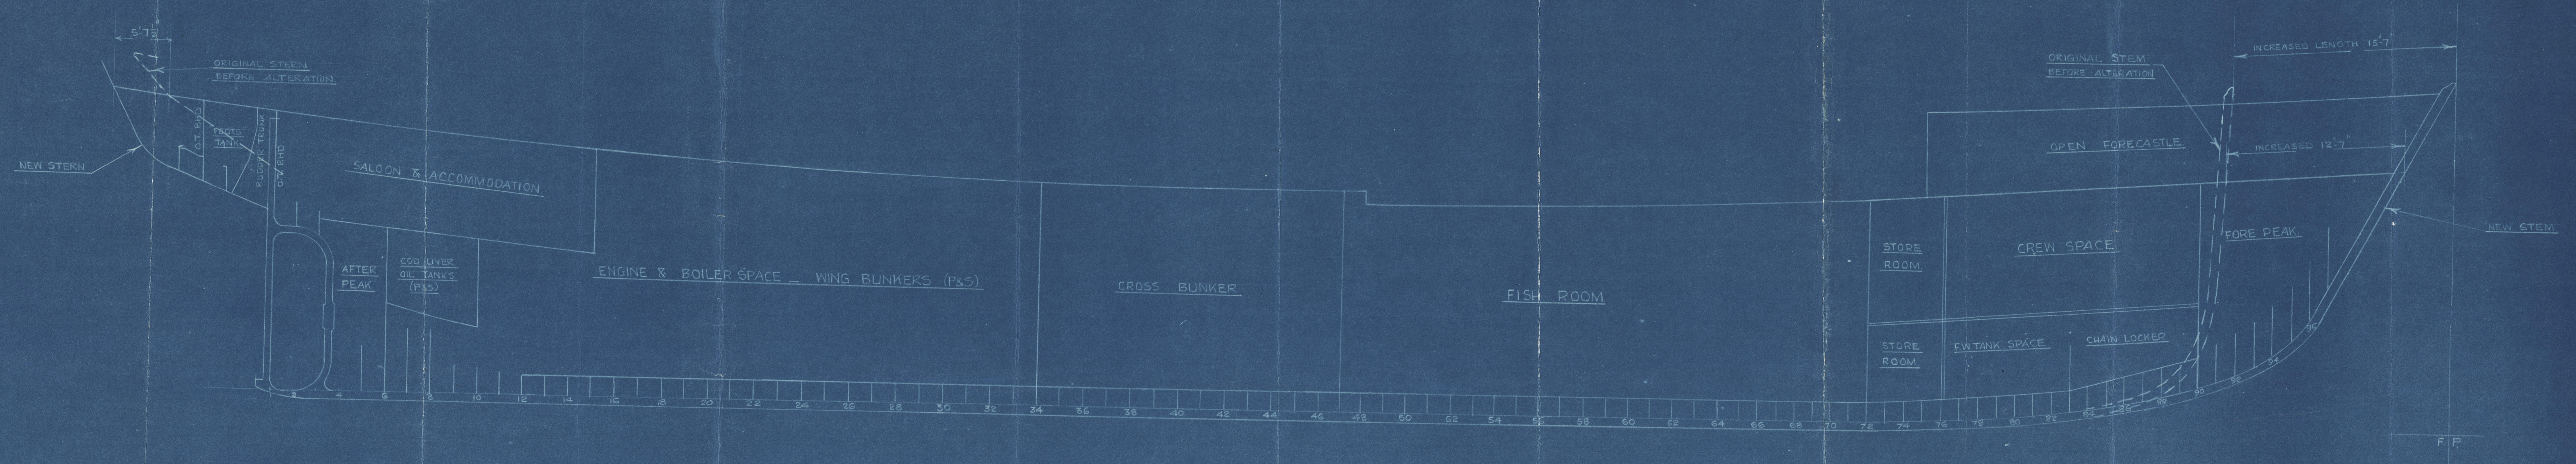

S.T. "RYLSTON"

Profile Plan showing Alterations

to fore & after ends

S.T. "RYLSTON"

MDB. RPT. No. 16530



© 2020

Lloyd's Register  
Foundation

W221-0024