


# PROFILE AND DECKS.

N<sup>o</sup> 556. Lengthened 2.39

DIM<sup>s</sup>. 143'-0" BP x 24'-6" B MLD x 14'-6" D. MLD.  
SCALE 1/4" = 1 FOOT.

Keel Lengthened 2.39  
See Rpt. Mdb. 16530. and cruiser Stern fitted

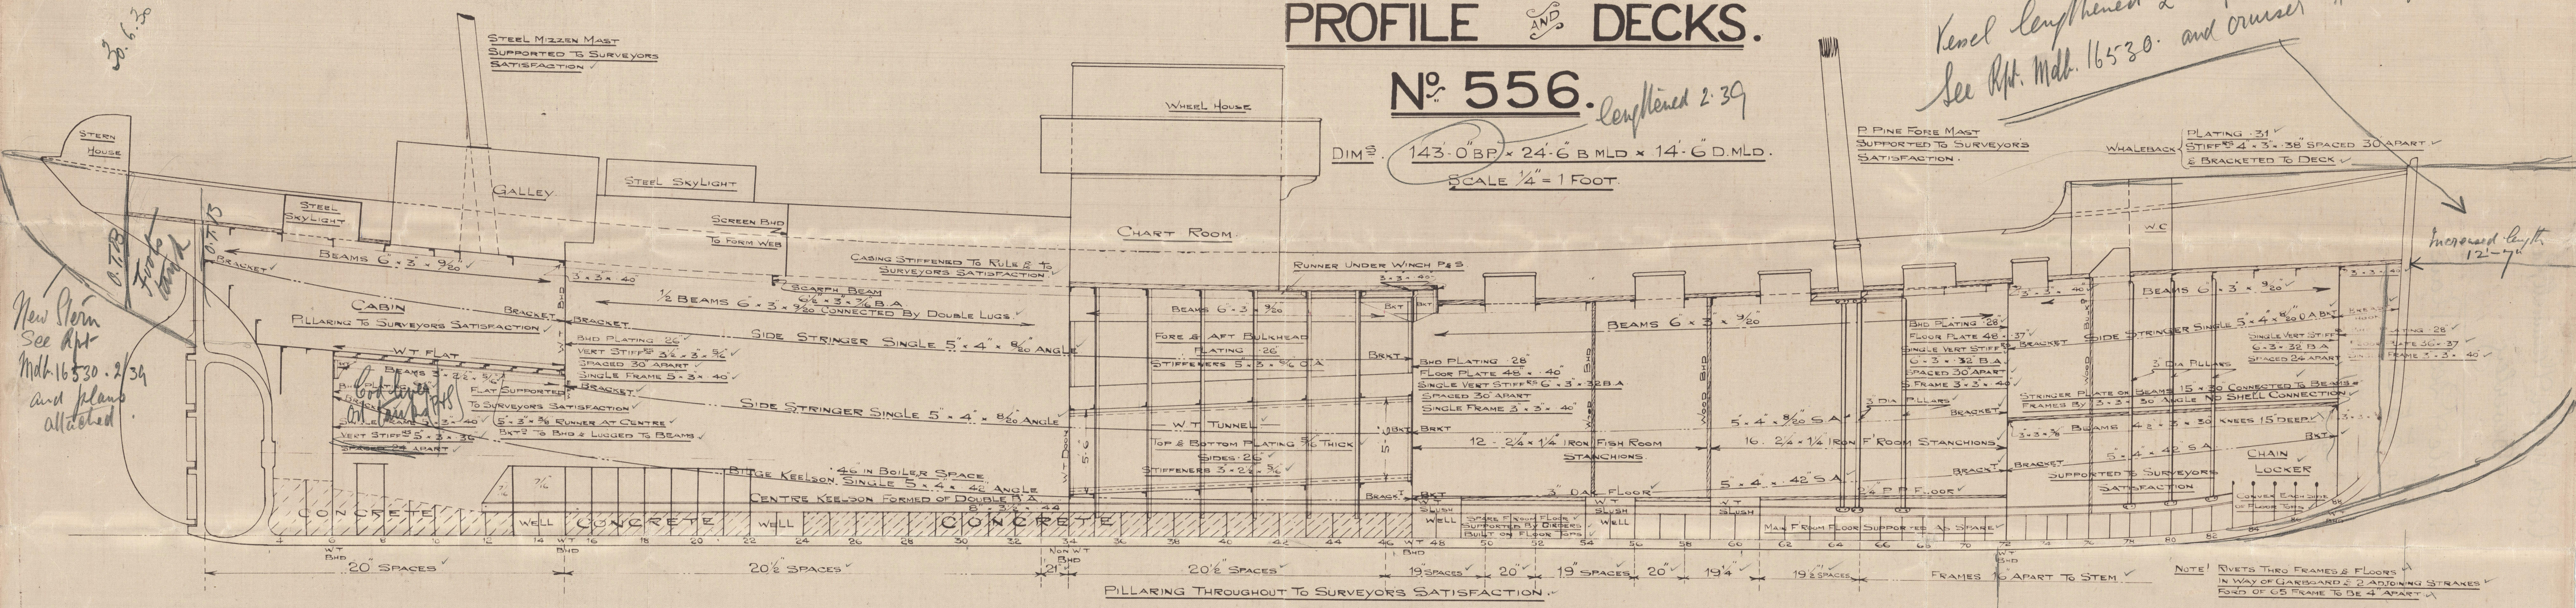

New Stern  
See Rpt.  
Mdb. 16530. 2/39  
and plans  
attached.

Increased length  
12'-7"

APPROVED By LLOYDS: \_\_\_\_\_




Cook, Welton & Gummell, Ltd.  
Beverley

Profile & Deck Plan  
No. 556  
"Jervani" 2x

S.S. "Rylston"

HULL REPORT No. 41353.

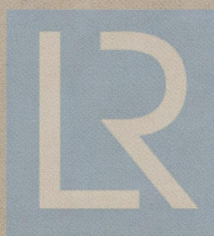

© 2020

Lloyd's Register  
Foundation

W221-0046