

N^o 556.

MIDSHIP SECTION.

SCALE 1/2" = 1 FOOT

DIMENSIONS 143 OBP x 24' 6" MLD x 14' 6" MLD



CLASS 100 A 1 STEEL STEAM TRAWLER

Vessel lengthened 2' 39"
mdh. 16 530

LLOYDS NUMERALS

L x D	2073.5 ✓
L x (B + D)	5577.0 ✓
D	14.50 ✓
B + D	39 ✓
L/D	9.862 ✓

- 135 fms. from 2.39
- EQUIPMENT
- ✓ 1 STOCKLESS ANCHOR 8 1/2 CWTs
 - ✓ 1 " 8
 - ✓ 1 RODGERS " 3 1/2 EX STOCK
 - ✓ 120 FATHOMS 18 STUD LINK CABLE
 - ✓ 60 FATHOMS 6 HAWSER
 - ✓ 60 " 5 WARP

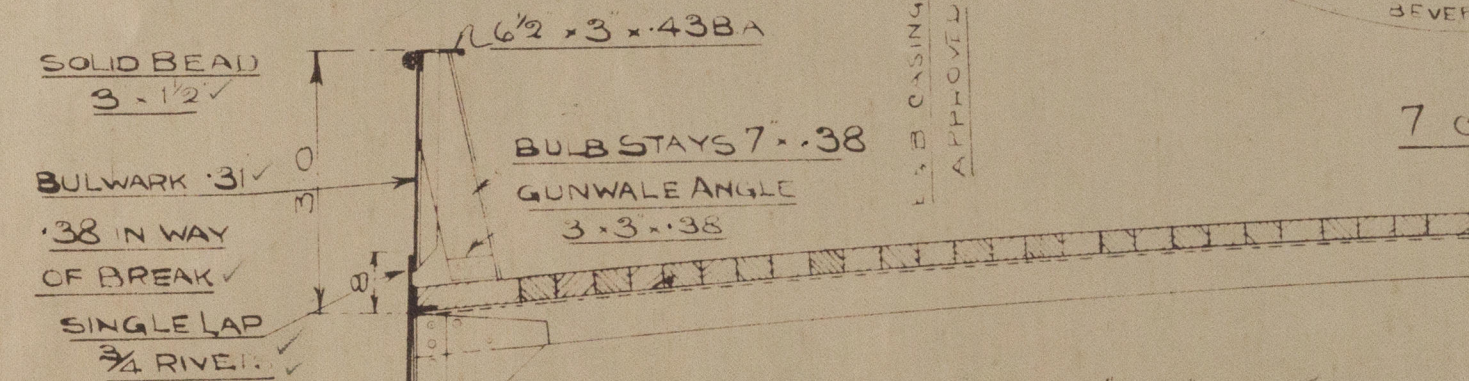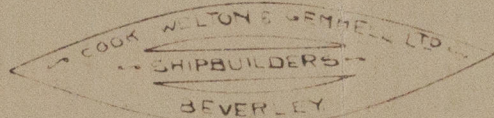

QUARTER DECK 80' 1" x 12' HIGH
SCANTLINGS SAME AS MAIN DECK

DOUBLE LAP
3/4 RIVETS

5 x 4 x 40
IN WAY OF RQRD DK
SINGLE LUG 5 x 3 x 40

DOUBLE LAP
3/4 RIVETS

5 x 4 x 40
SINGLE LUG
5 x 3 x 40

DOUBLE LAP
3/4 RIVETS

45' O ROLLING CHOCK
FORMED OF 3 x 50 BULB 6
6 x 4 x 50 TEE BAR

DOUBLE LAP
3/4 RIVETS

DOUBLE LAP
3/4 RIVETS

DOUBLE LAP
3/4 RIVETS

5 x 4 x 42 BOILER SPACE 46
SINGLE LUG 5 x 3 x 40

CENTRE KEELSON FORMED OF
8 x 3 1/2 x 44 DOUBLE BULB ANGLES
LUGS 3 x 3 x 38

2 DIA

32 x 50
OR BUTTSTRAPS
3/4 x 55 3/4 RIVETS

- ✓ FRAMES 5 x 3 x 40 SPACED AS PER PROFILE
- ✓ REVERSE FRAMES 3 x 3 x 38 ACROSS TOPS OF FLOORS
- ✓ WHERE NO CONCRETE IS FITTED
- ✓ REVERSE FRAMES DOUBLE IN E & B SPACE
- ✓ FLOORS 18 x 38 43 IN E & B SPACE
- ✓ BULKHEADS 30 STIFFENED AS PER PROFILE
- ✓ KEEL & STEM 8 x 2 FLATS
- ✓ STERN FRAME 6 x 34
- ✓ RUDDER HEAD 5 1/2 DIA HELL 4 x 3
- ✓ PINTLES 3 DIA
- ✓ PILLARS AS PER RULE

STRINGER PLATES
30 x 58 TO 21 x 32

DOUBLE LUGS 4 x 3 x 38
3 x 3 x 38
DOUBLE LUGS
14 OAK
WATERWAY

BUTTSTRAPS OF
BULWARK SINGLE
58 RIVETS

42 x 62 x 43
T R BUTTSTRAPS
3/4 RIVETS
144 x 62 x 50

50 ABREAST GALLIES
56 x 40 x 38
TREBLE BUTTLAPS
FOR 1/2 LENGTH
REMAINDER DOUBLE BUTTLAPS
3/4 RIVETS

52 1/2 x 43 x 38
TREBLE BUTTLAPS
FOR 1/2 LENGTH
REMAINDER DOUBLE BUTTLAPS
3/4 RIVETS

50 x 40 x 38
TREBLE BUTTLAPS
FOR 1/2 LENGTH
3/4 RIVETS

50 1/2 x 43 x 38
TREBLE BUTTLAPS
FOR 1/2 LENGTH
3/4 RIVETS

52 x 40 x 38
TREBLE BUTTLAPS
FOR 1/2 LENGTH
3/4 RIVETS

APPROVED BY LLOYDS

30.6.30

Cook, Welton & Gammell, Ltd.
Beverley

Midship Section
No. 556
Tervani "2"

S.S. "Rylston"

MULL REPORT No. 41353.



© 2020

Lloyd's Register
Foundation

W221-0047