



S.S. VALENCIA

MIDSHIP SECTION

LENGTH BETWEEN PERPENDICULARS	363'-6"
BREADTH MOULDED	50'-10"
DEPTH TO UPPER DECK	32'-4"
MAIN	24'-4"

SCALE 1/2"=1'00"

All scantlings taken off ship

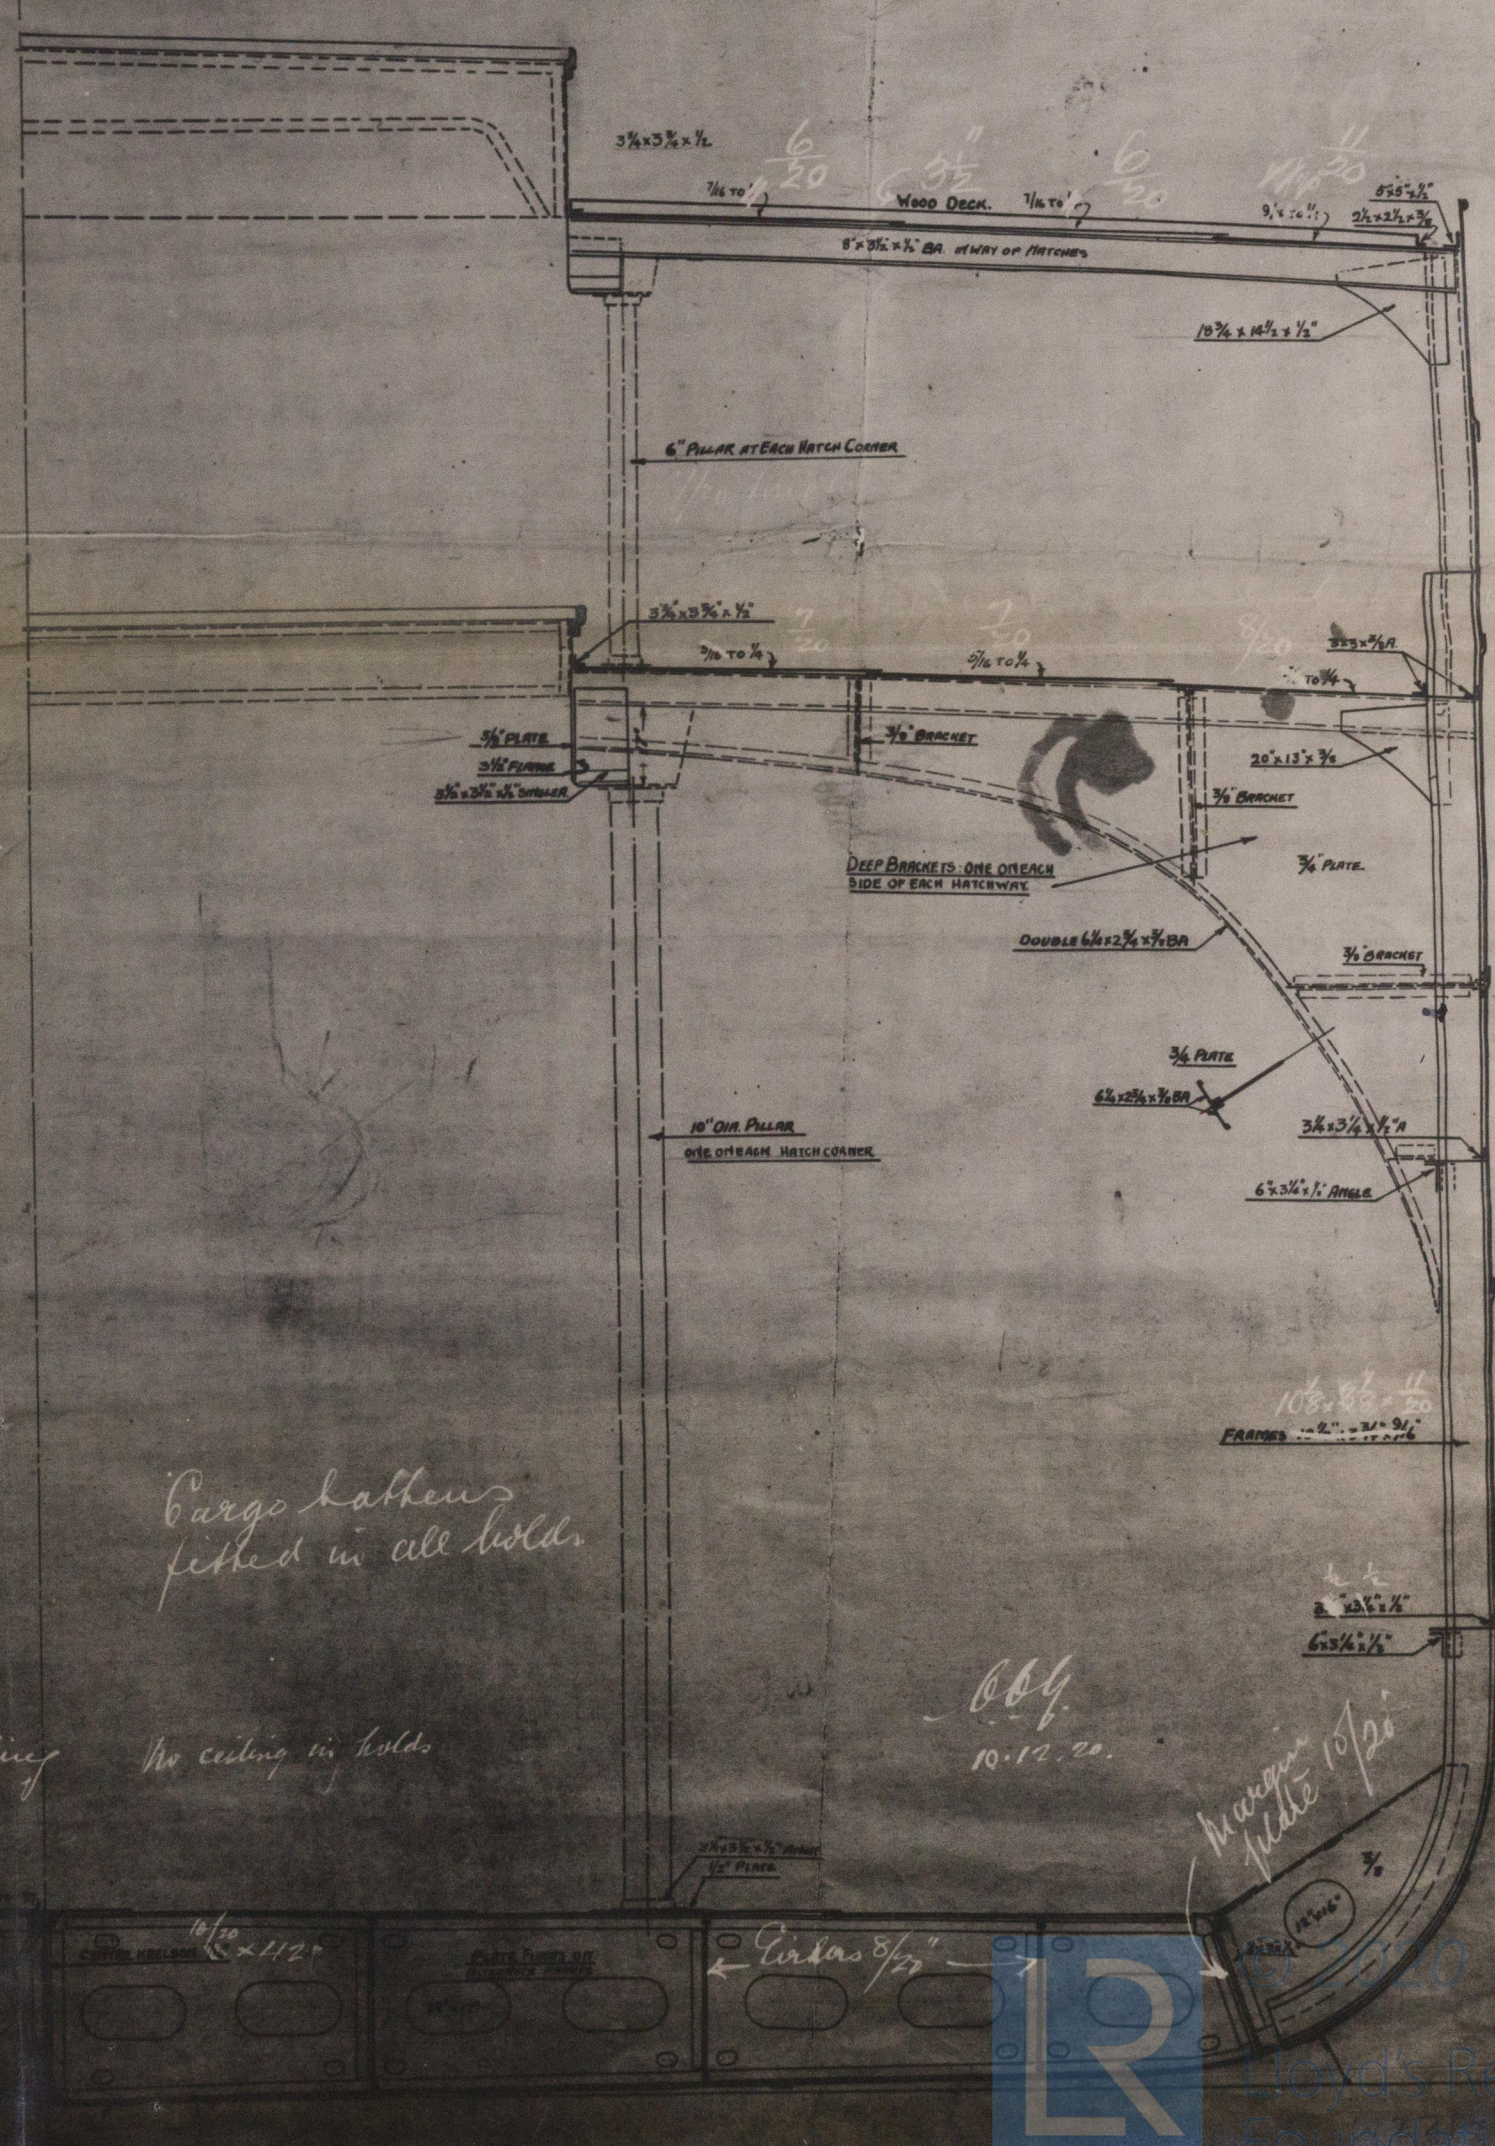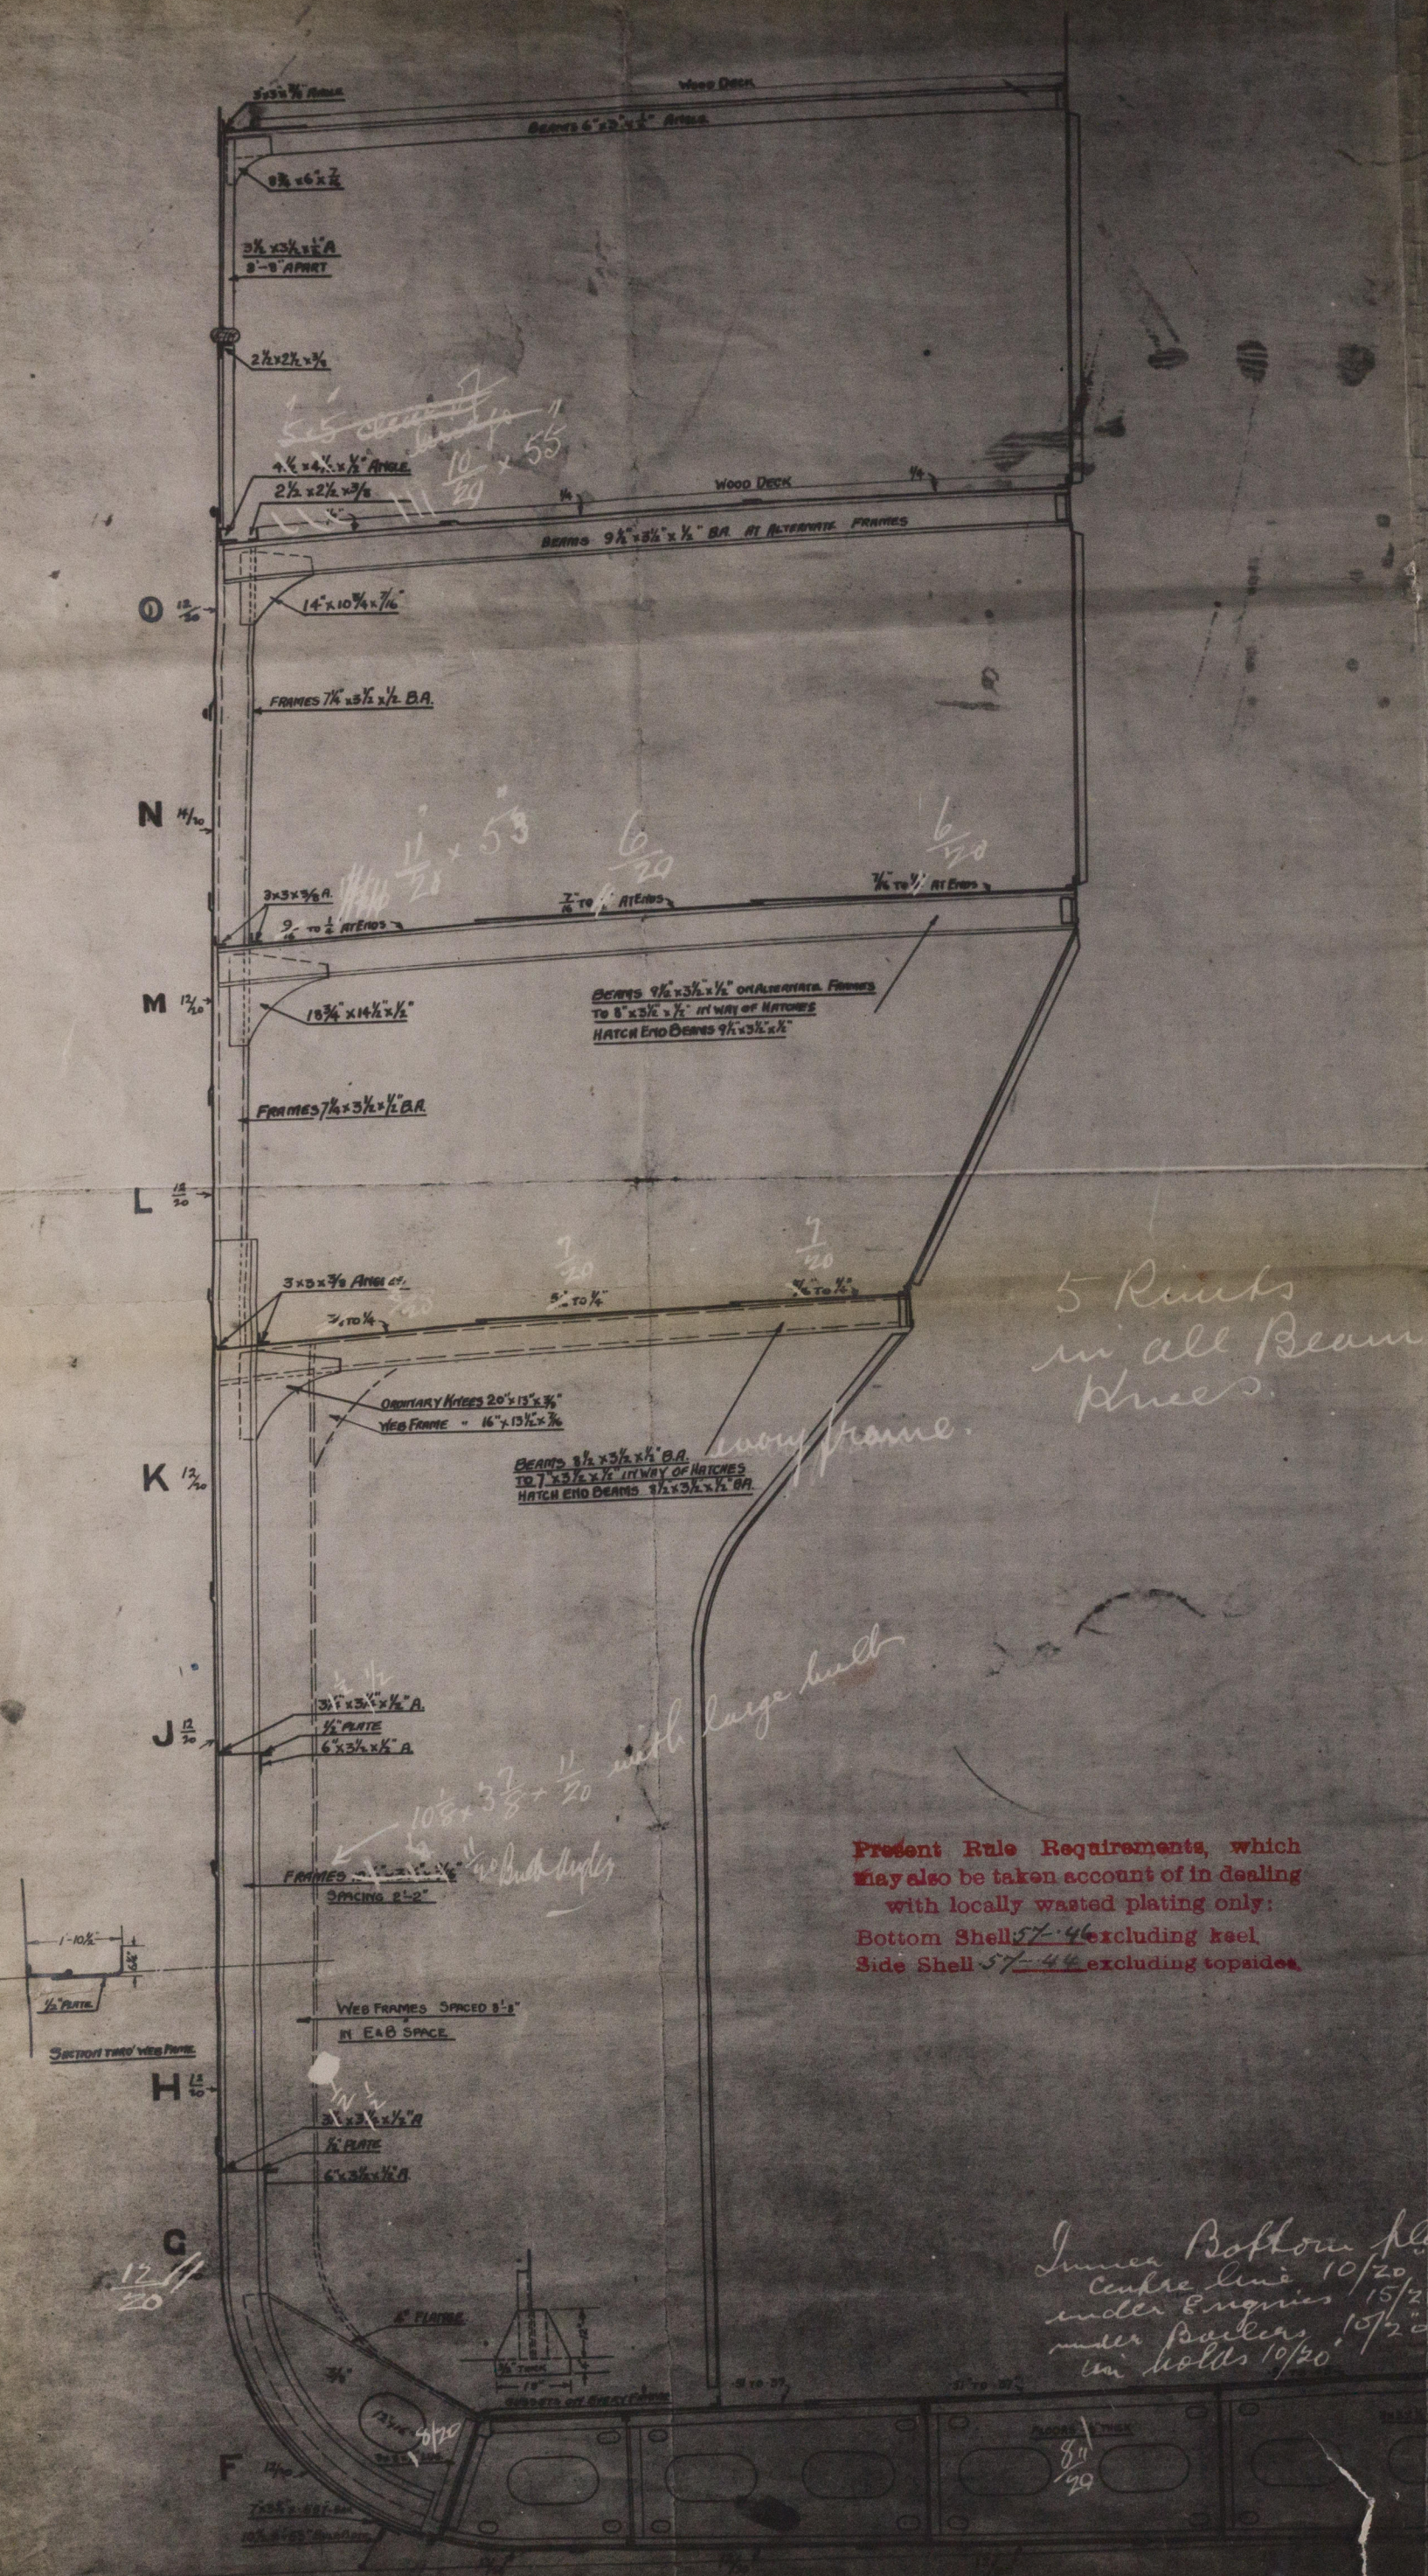

TINHOW

Adv. Hong Kong.

Midship Section

"TINHOW"



© 2020

Lloyd's Register
Foundation

W221-0109