

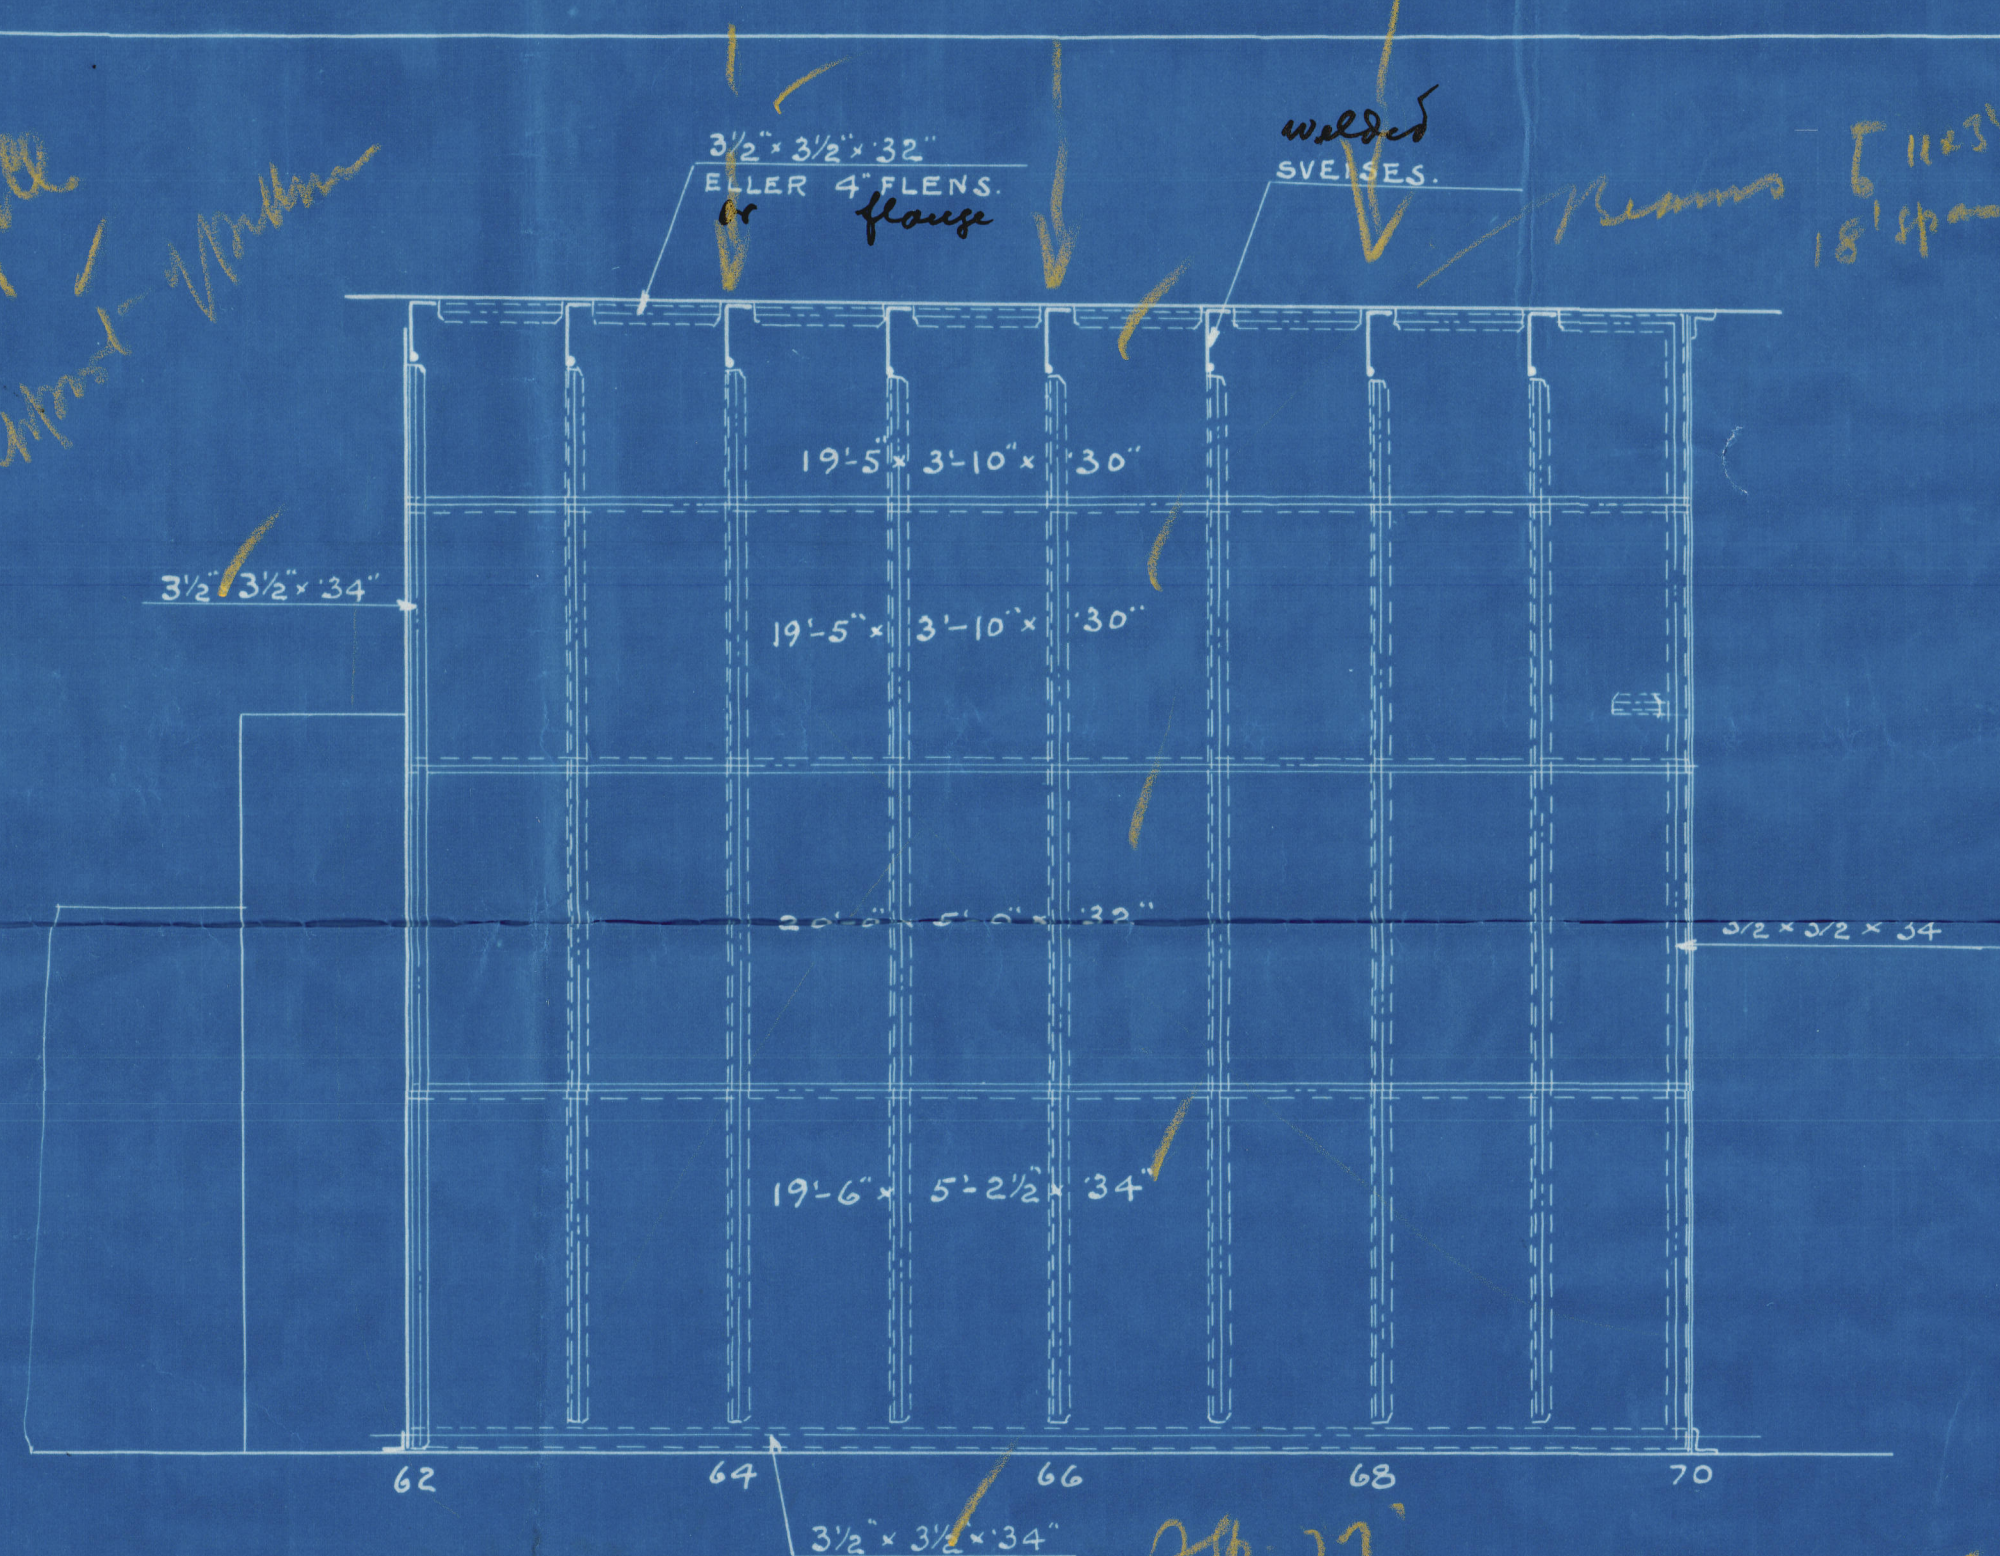



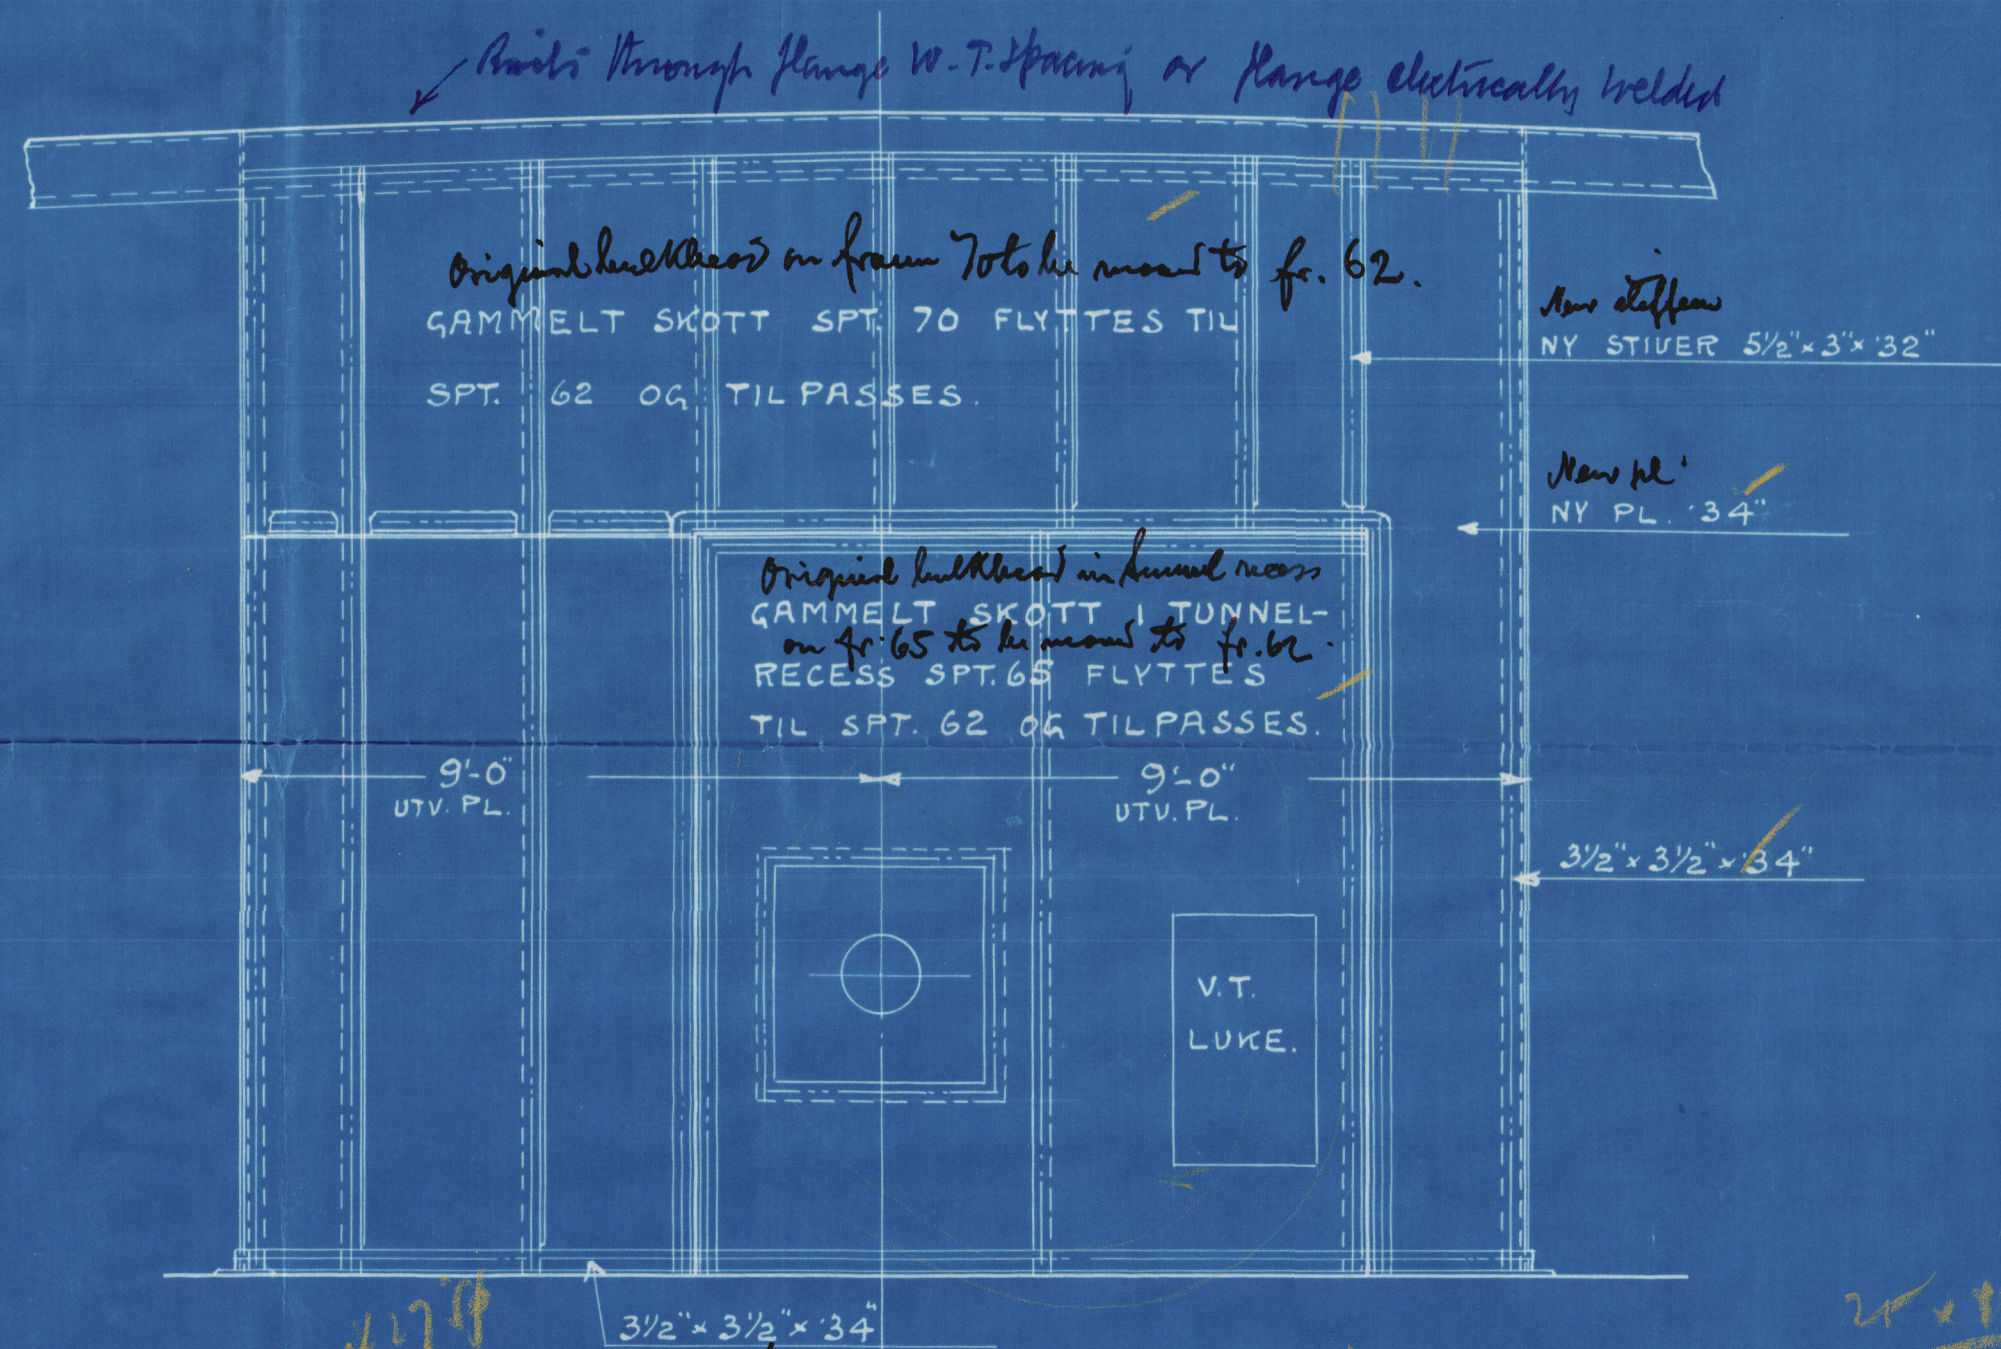


B.B. LANGSKIBSVEGG.
Longitudinal hull keel

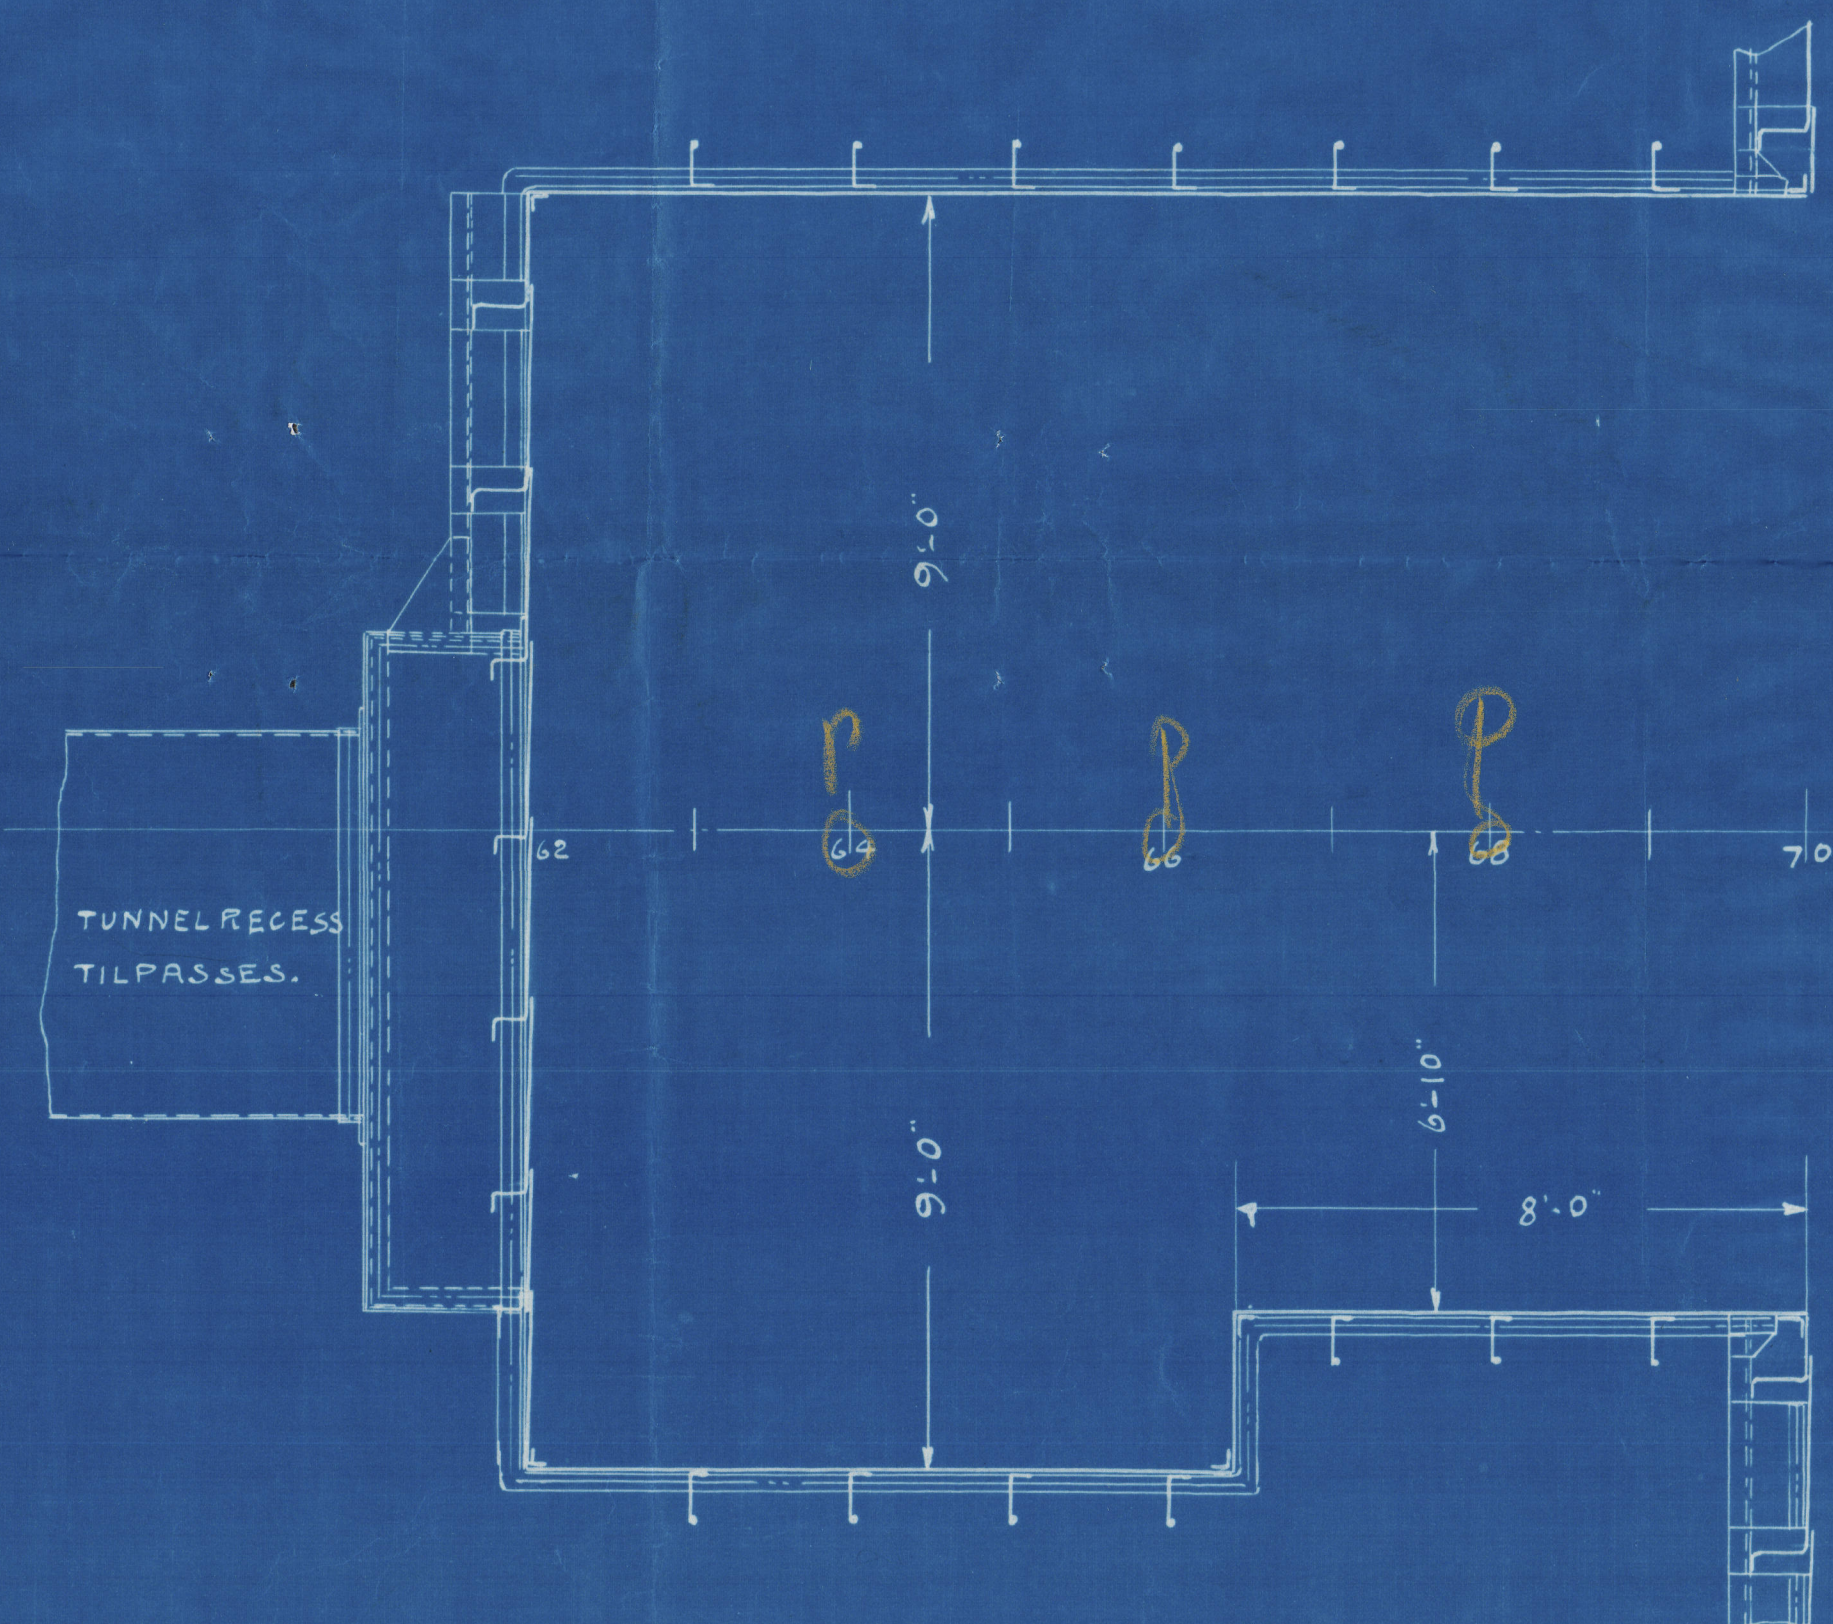

Built for
SKOTT SPT. 62.

16 - 8.5 -
12.20 - 16.75 -
16.75 - 4.4 - 16.1
5.45 - 17.36 - 30
= 15.13 + 17.4
8.14

24 + 12.45 = 36.45
50
KM = 68 x 27 x 1.5 = 730
18 x 9 x 5.5 = 90
50
36.45
12.20
16.75
16.1
4.4
17.36
30
15.13
17.4
8.14

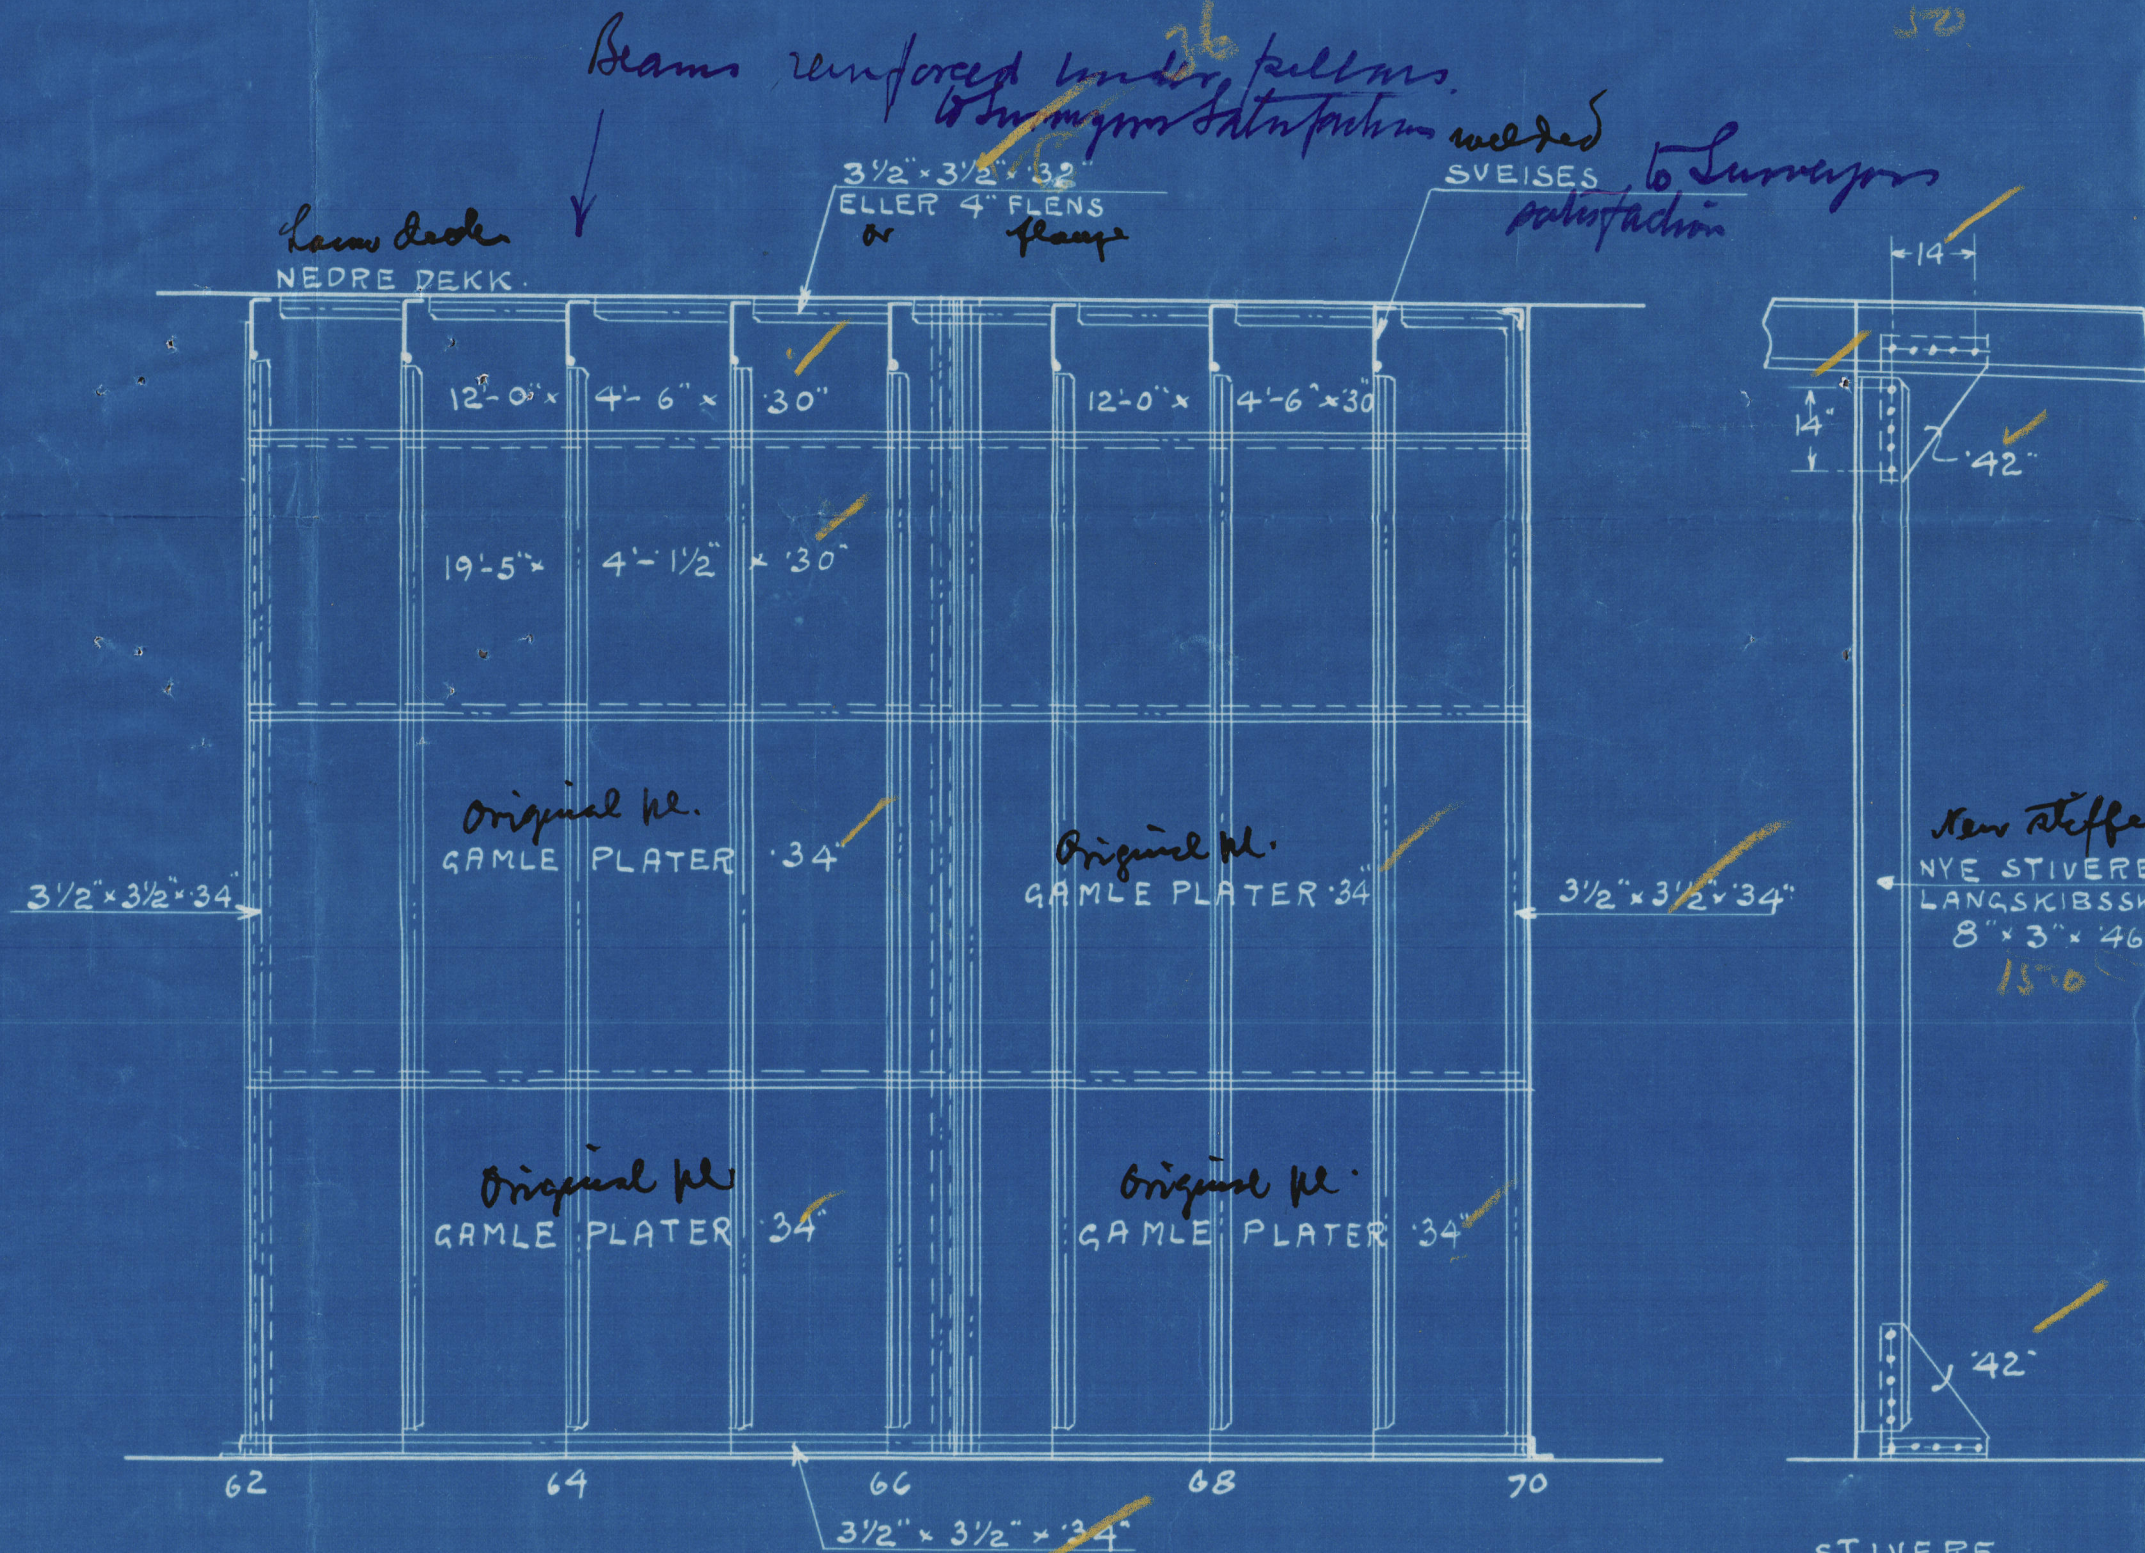

New stiffeners on both longitudinal hull keel
NYE STIVER PÅ BEGGE
LANGSKIBSSKOTT. 7" x 3" x 40" ELLER
8" x 3" x 46" FRA LAGER
15.10 from stock

NYLANDS VERKSTED
P. THODE FAGELUND
Alteration of existing hull keel
FORANDRING AV MASKINSKOTT
SKALA: 3/8" = 1'-0"

ST. B. LANGSKIBSVEGG
Longitudinal hull keel

STIVERE
Stiffeners
p. 3. 38

NYLANDS VERKSTED
OSLO 28/2-35

10967
SK. 372
T. 9210
28-2-35

W222-0157

S. J. Thode Fagelund

Orl Refl. No. 4454,

Aft Engin Room Buckhart - Reused

Thode Fagelund



© 2020

Lloyd's Register
Foundation

S.S. Thode Fagelund

OSL Ref. No 4454.

W222-0157



© 2020

Lloyd's Register
Foundation