


STYKLISTE				
ANTAL GÆLDER				
POS:	STK:	GENSTAND	MODEL:	MATRL:
A.	1.	TRYKAKSEL		STÅL.

20/6/27

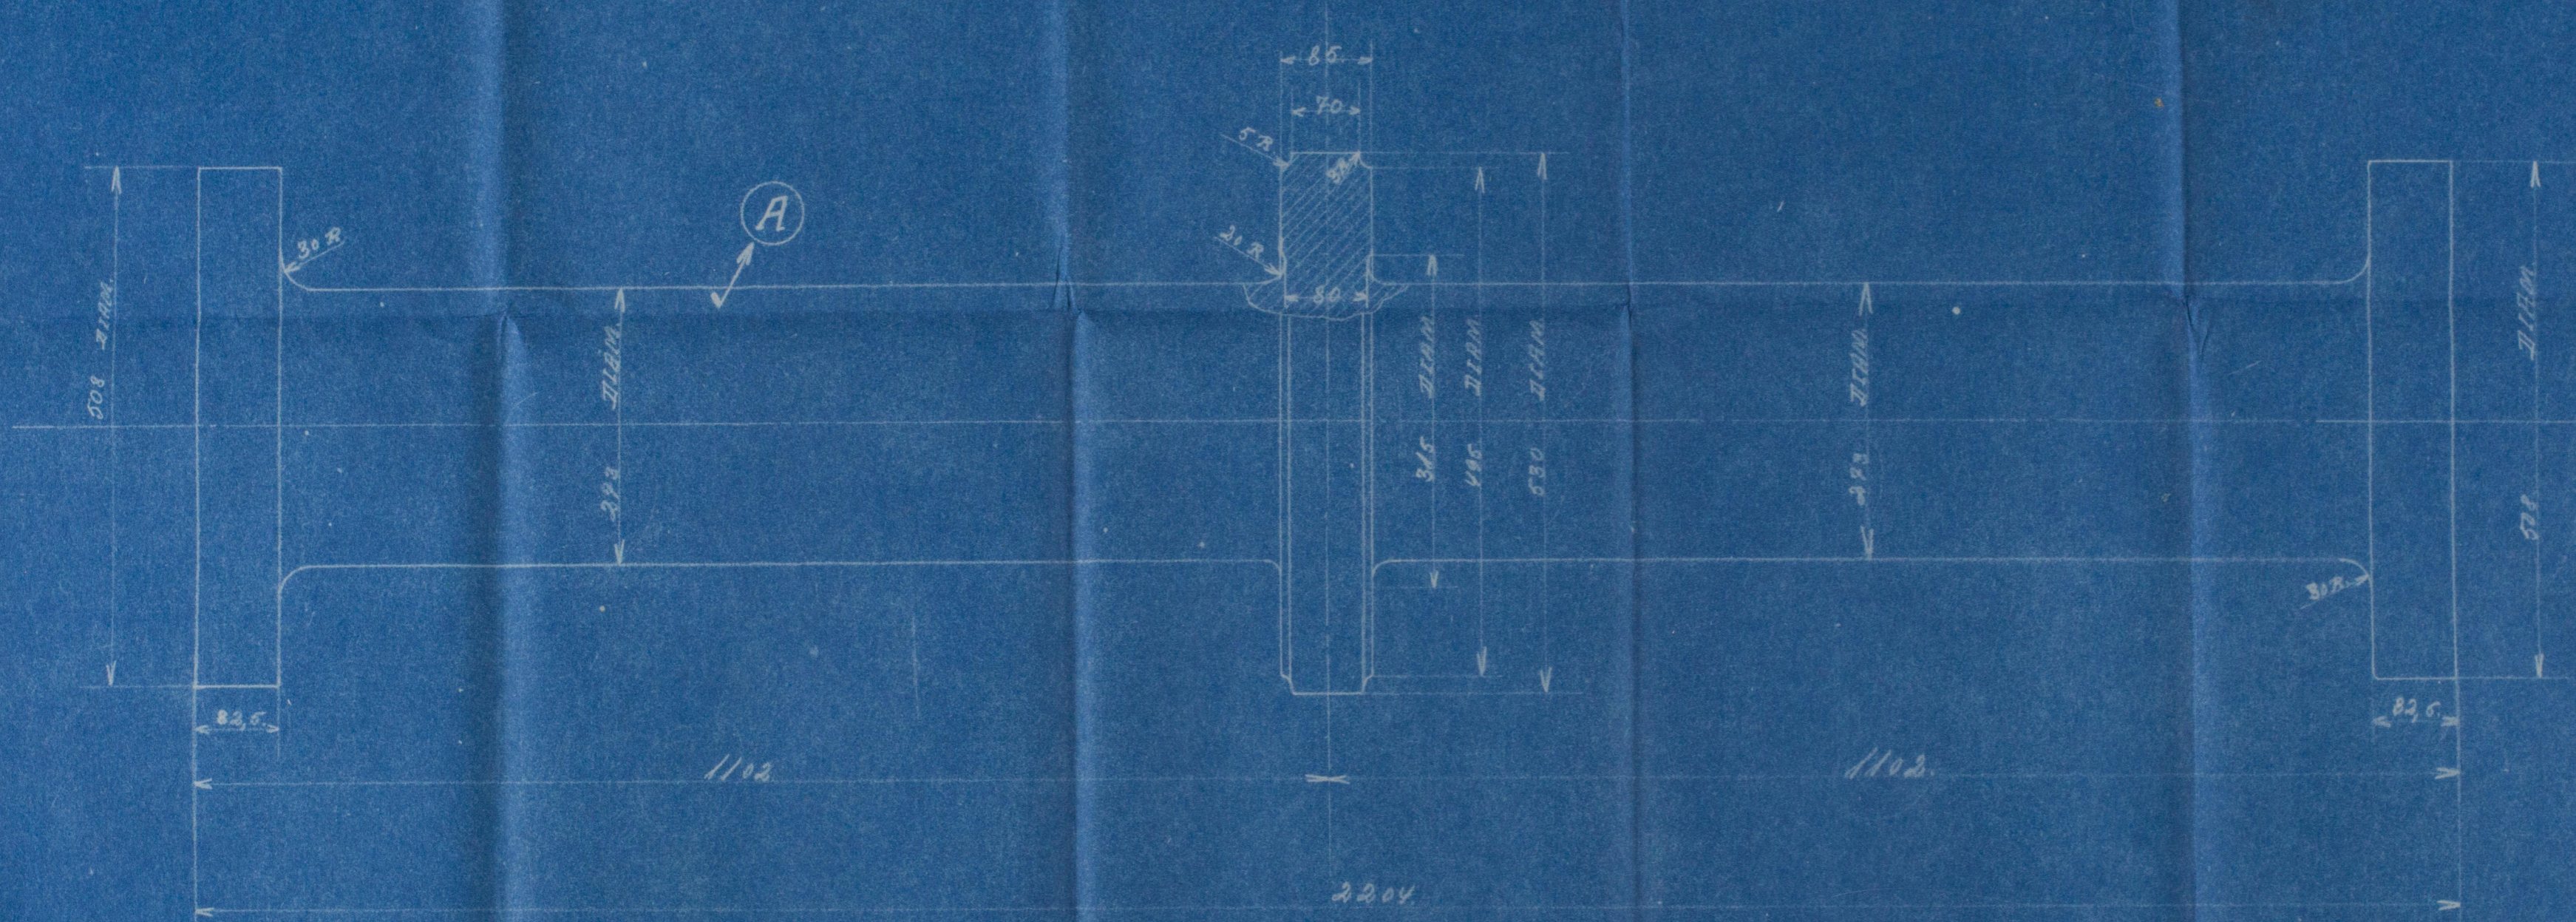

TRYKAKSEL.

SKALA 1:5

MILLIMETERMÅL

A/S HELSINGØRS JERNSKIBS- OG MASKINBYGGERI			
Tegn. Nr.	9381.		
Datum	9-6-27	Kontol.	L.W.
Klasse	151.	Kontol.	

TRIPLE EXPANSION ENGINE WITH THREE CYLINDERS AND THREE CRANKS AT 120° BOILER PRESSURE 200 LBS. PER SQ. IN.
CYLINDER DIAMETERS 20"-32"-53". PISTON STROKE 36"


W223-0037

LR

UDFØRER	ANTAL	BEMÆRKNINGER	TEGNING I VERKT
FORARB. NO:			
254 M	1.		9-6-27.

Thrust shaft

for a new engine being constructed
by Messrs P. Helsingors
Jernskibs- og Maskinbyggeri
for the S. "Fredensbro" of
Copenhagen

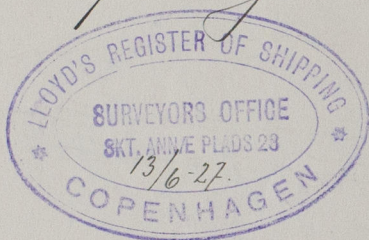

Copenhagen Report No 7535.



© 2019

Lloyd's Register
Foundation

W223-0037