
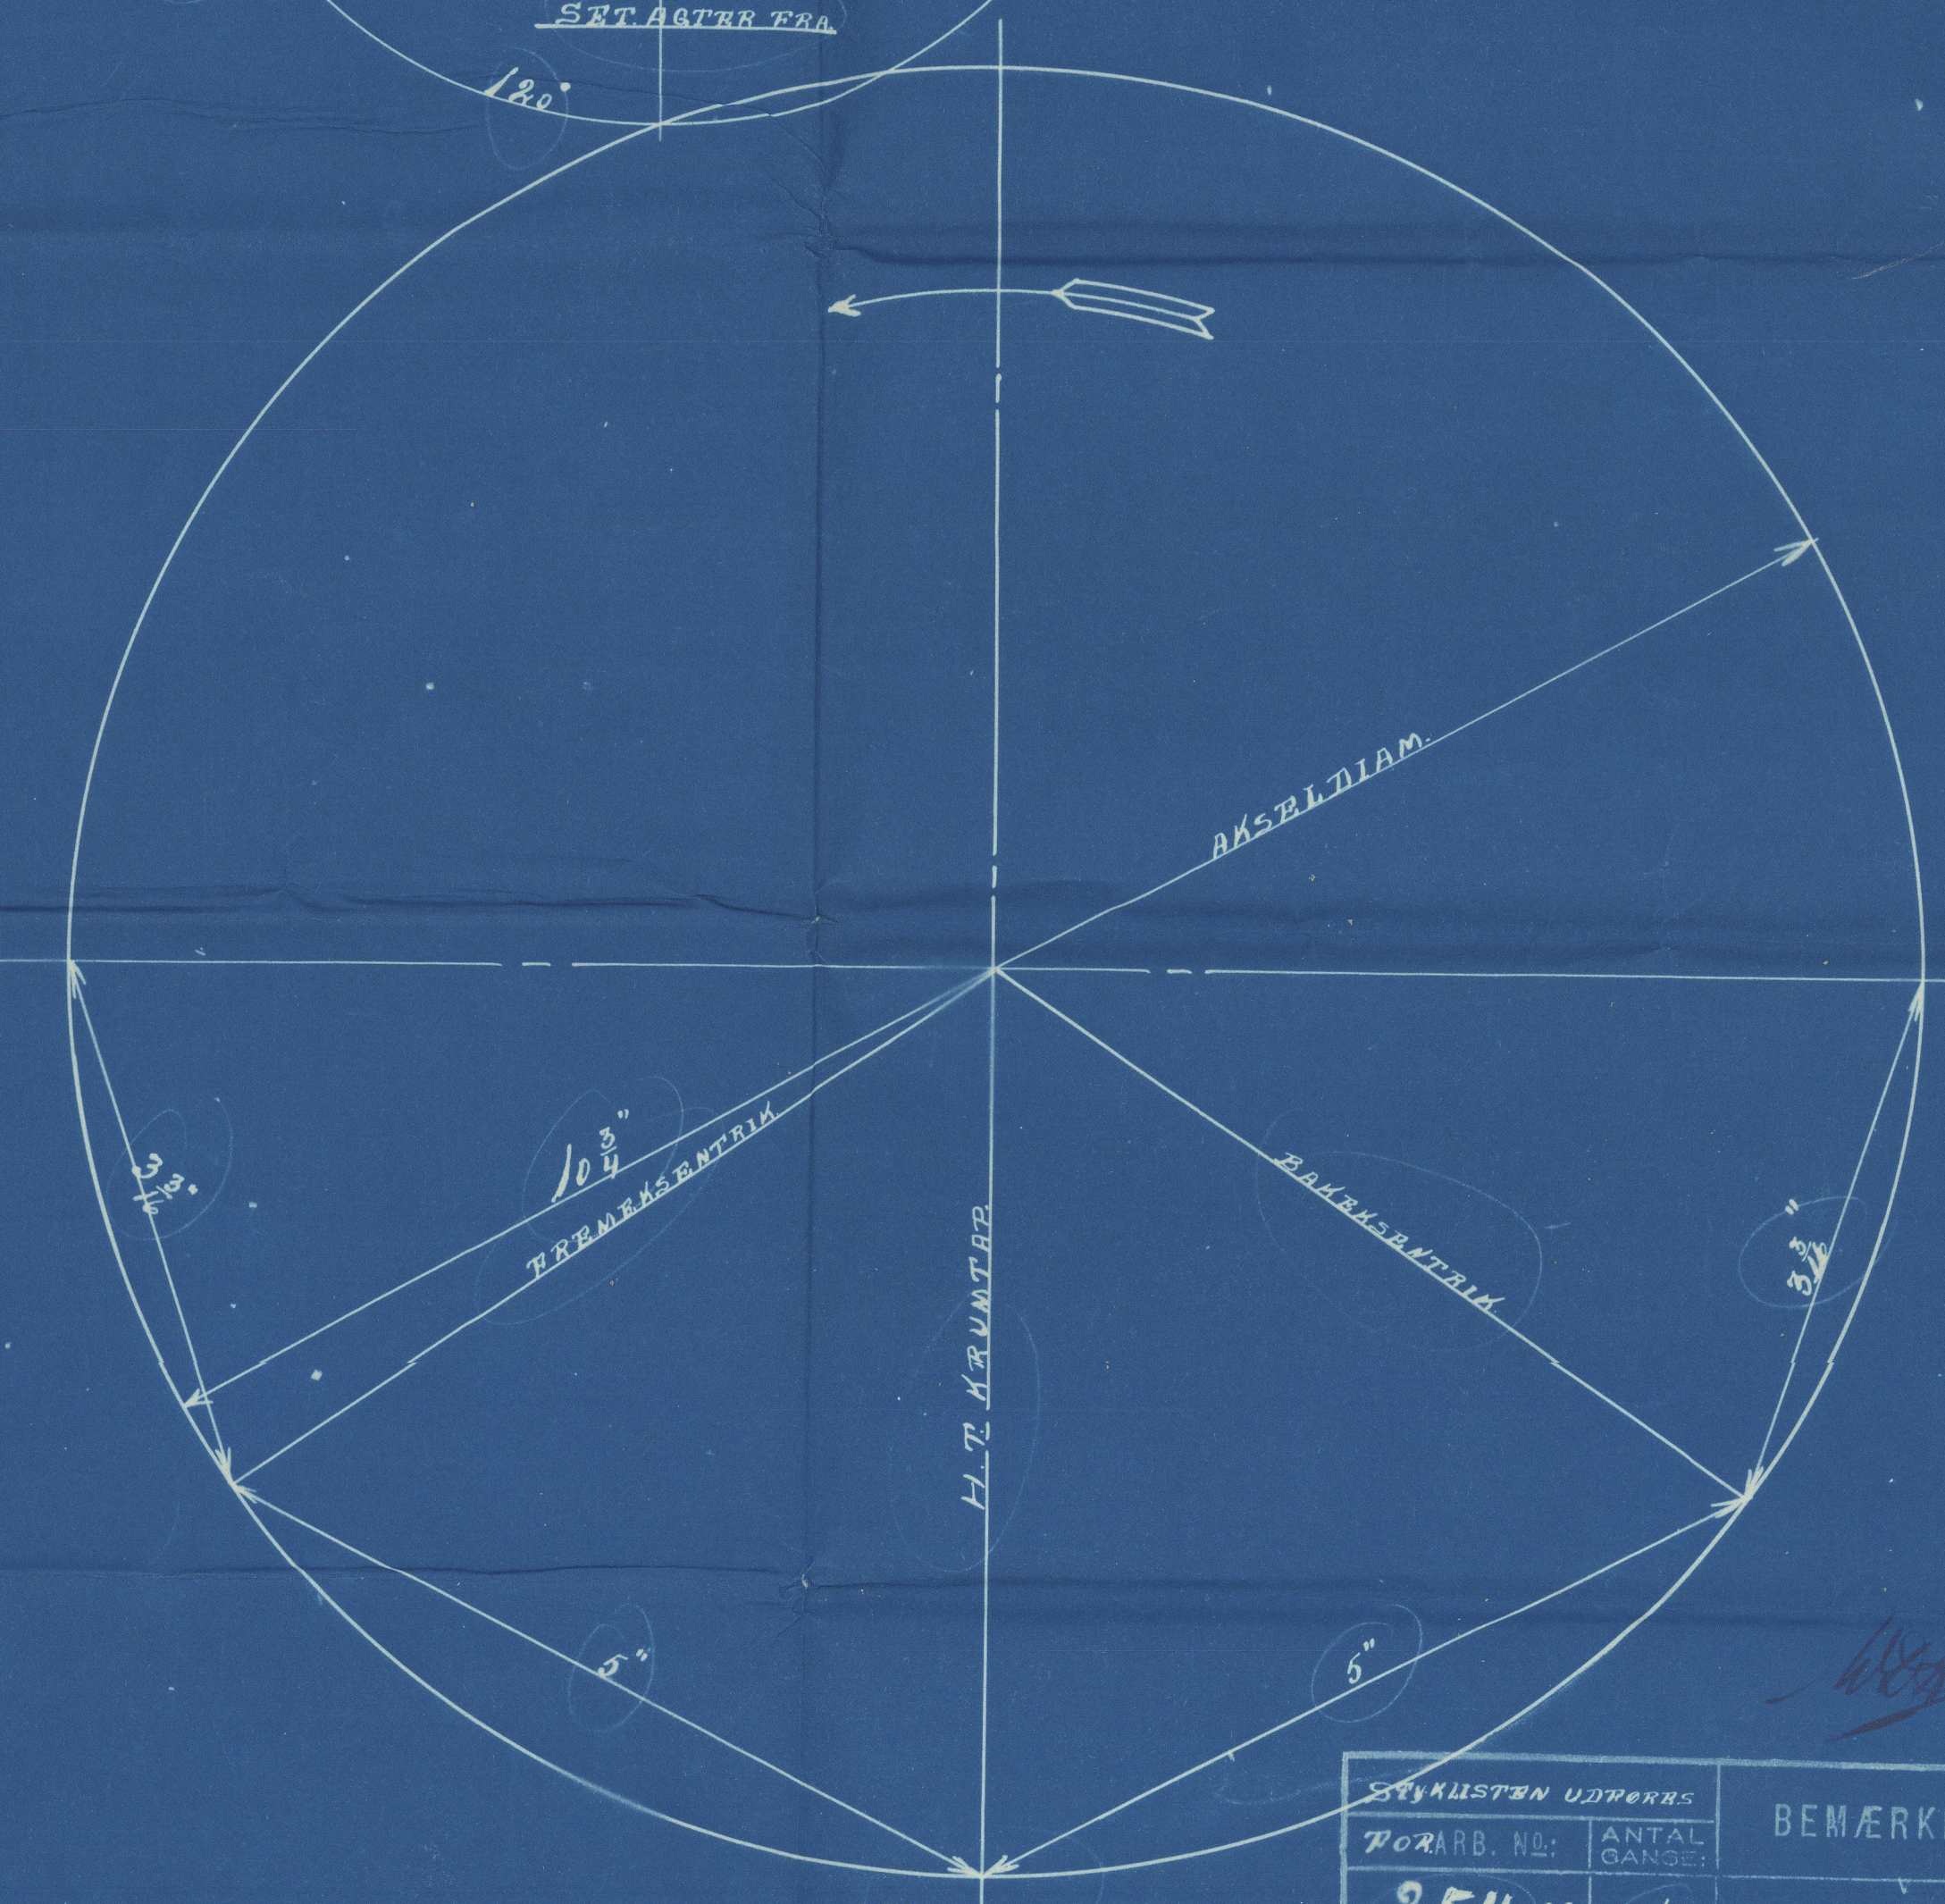
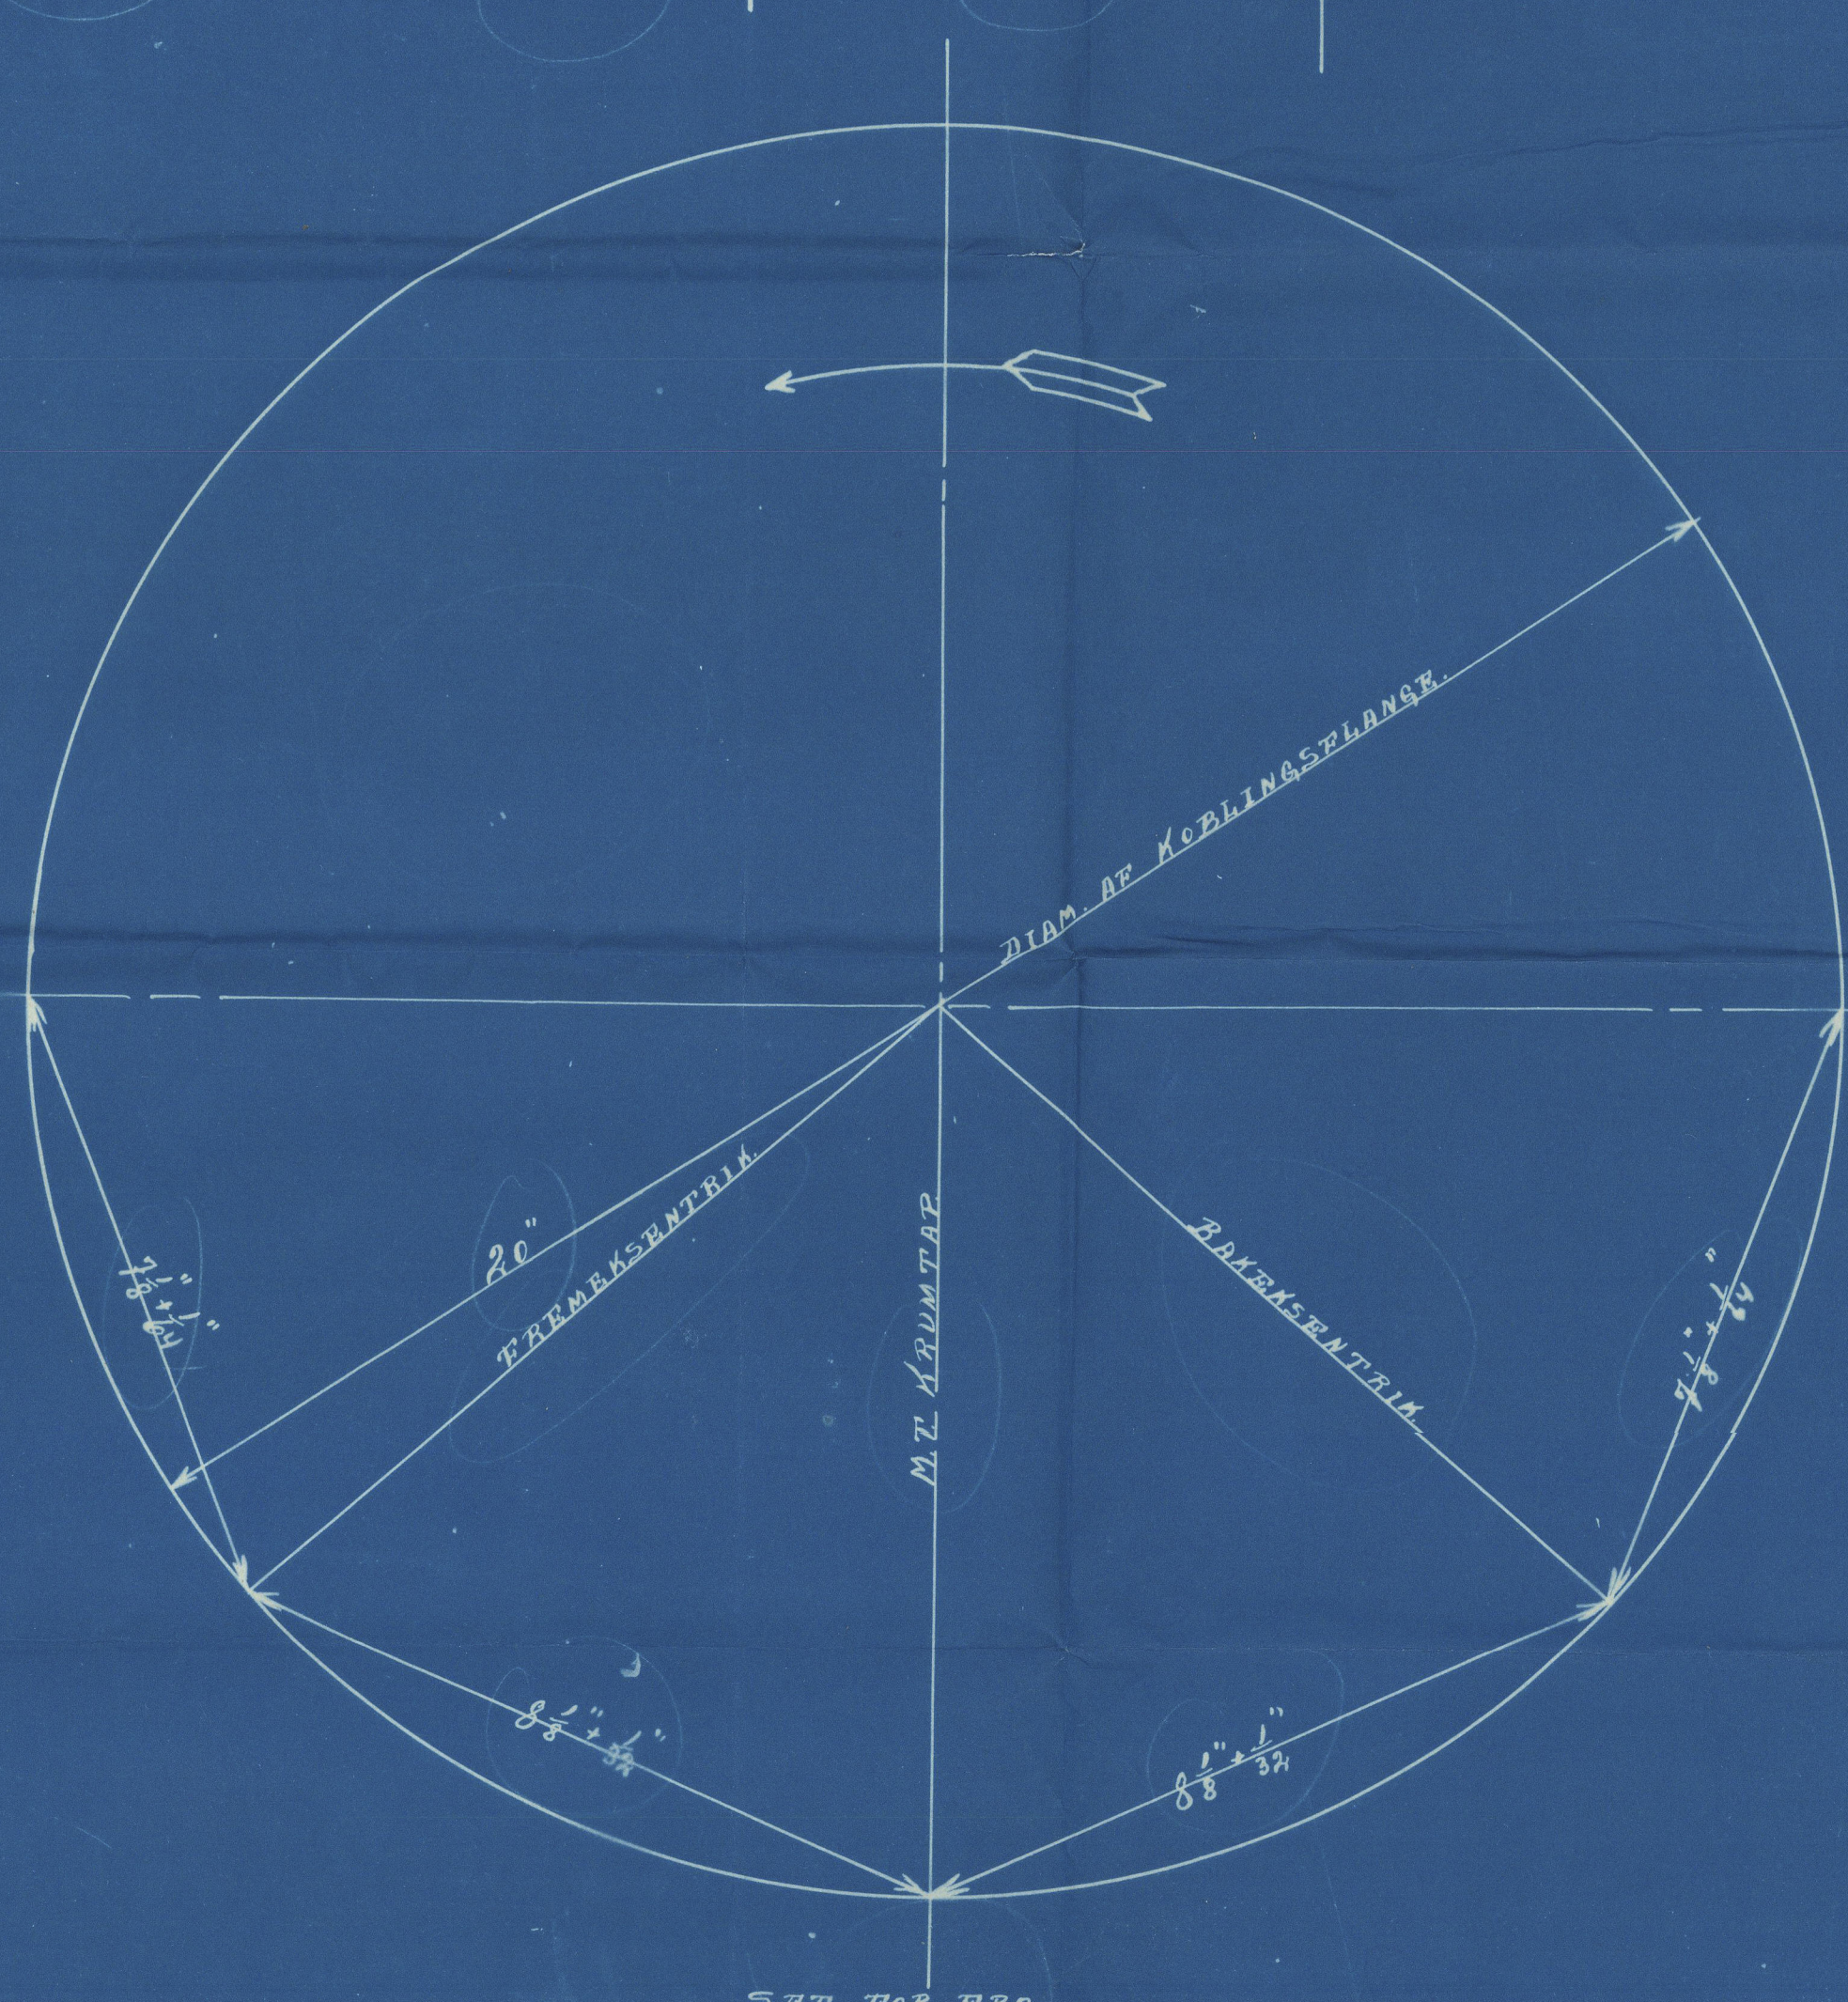


STYKLISTE				
ANTAL GÆLDER				
POS.	STK.	GJENSTAND	MODEL	MATRIAL
1	3	AKSELSTYKKE (SMEDERS UDRE)		STAAL
2	3	AKSELSTYKKE (SMEDERS UDRE)		STAAL
3	3	KRUMTAPPINER (SMEDERS UDRE)		STAAL
4	6	KRUMTAPSLAG		STAAL
5	6	KILDEPINER		STAAL

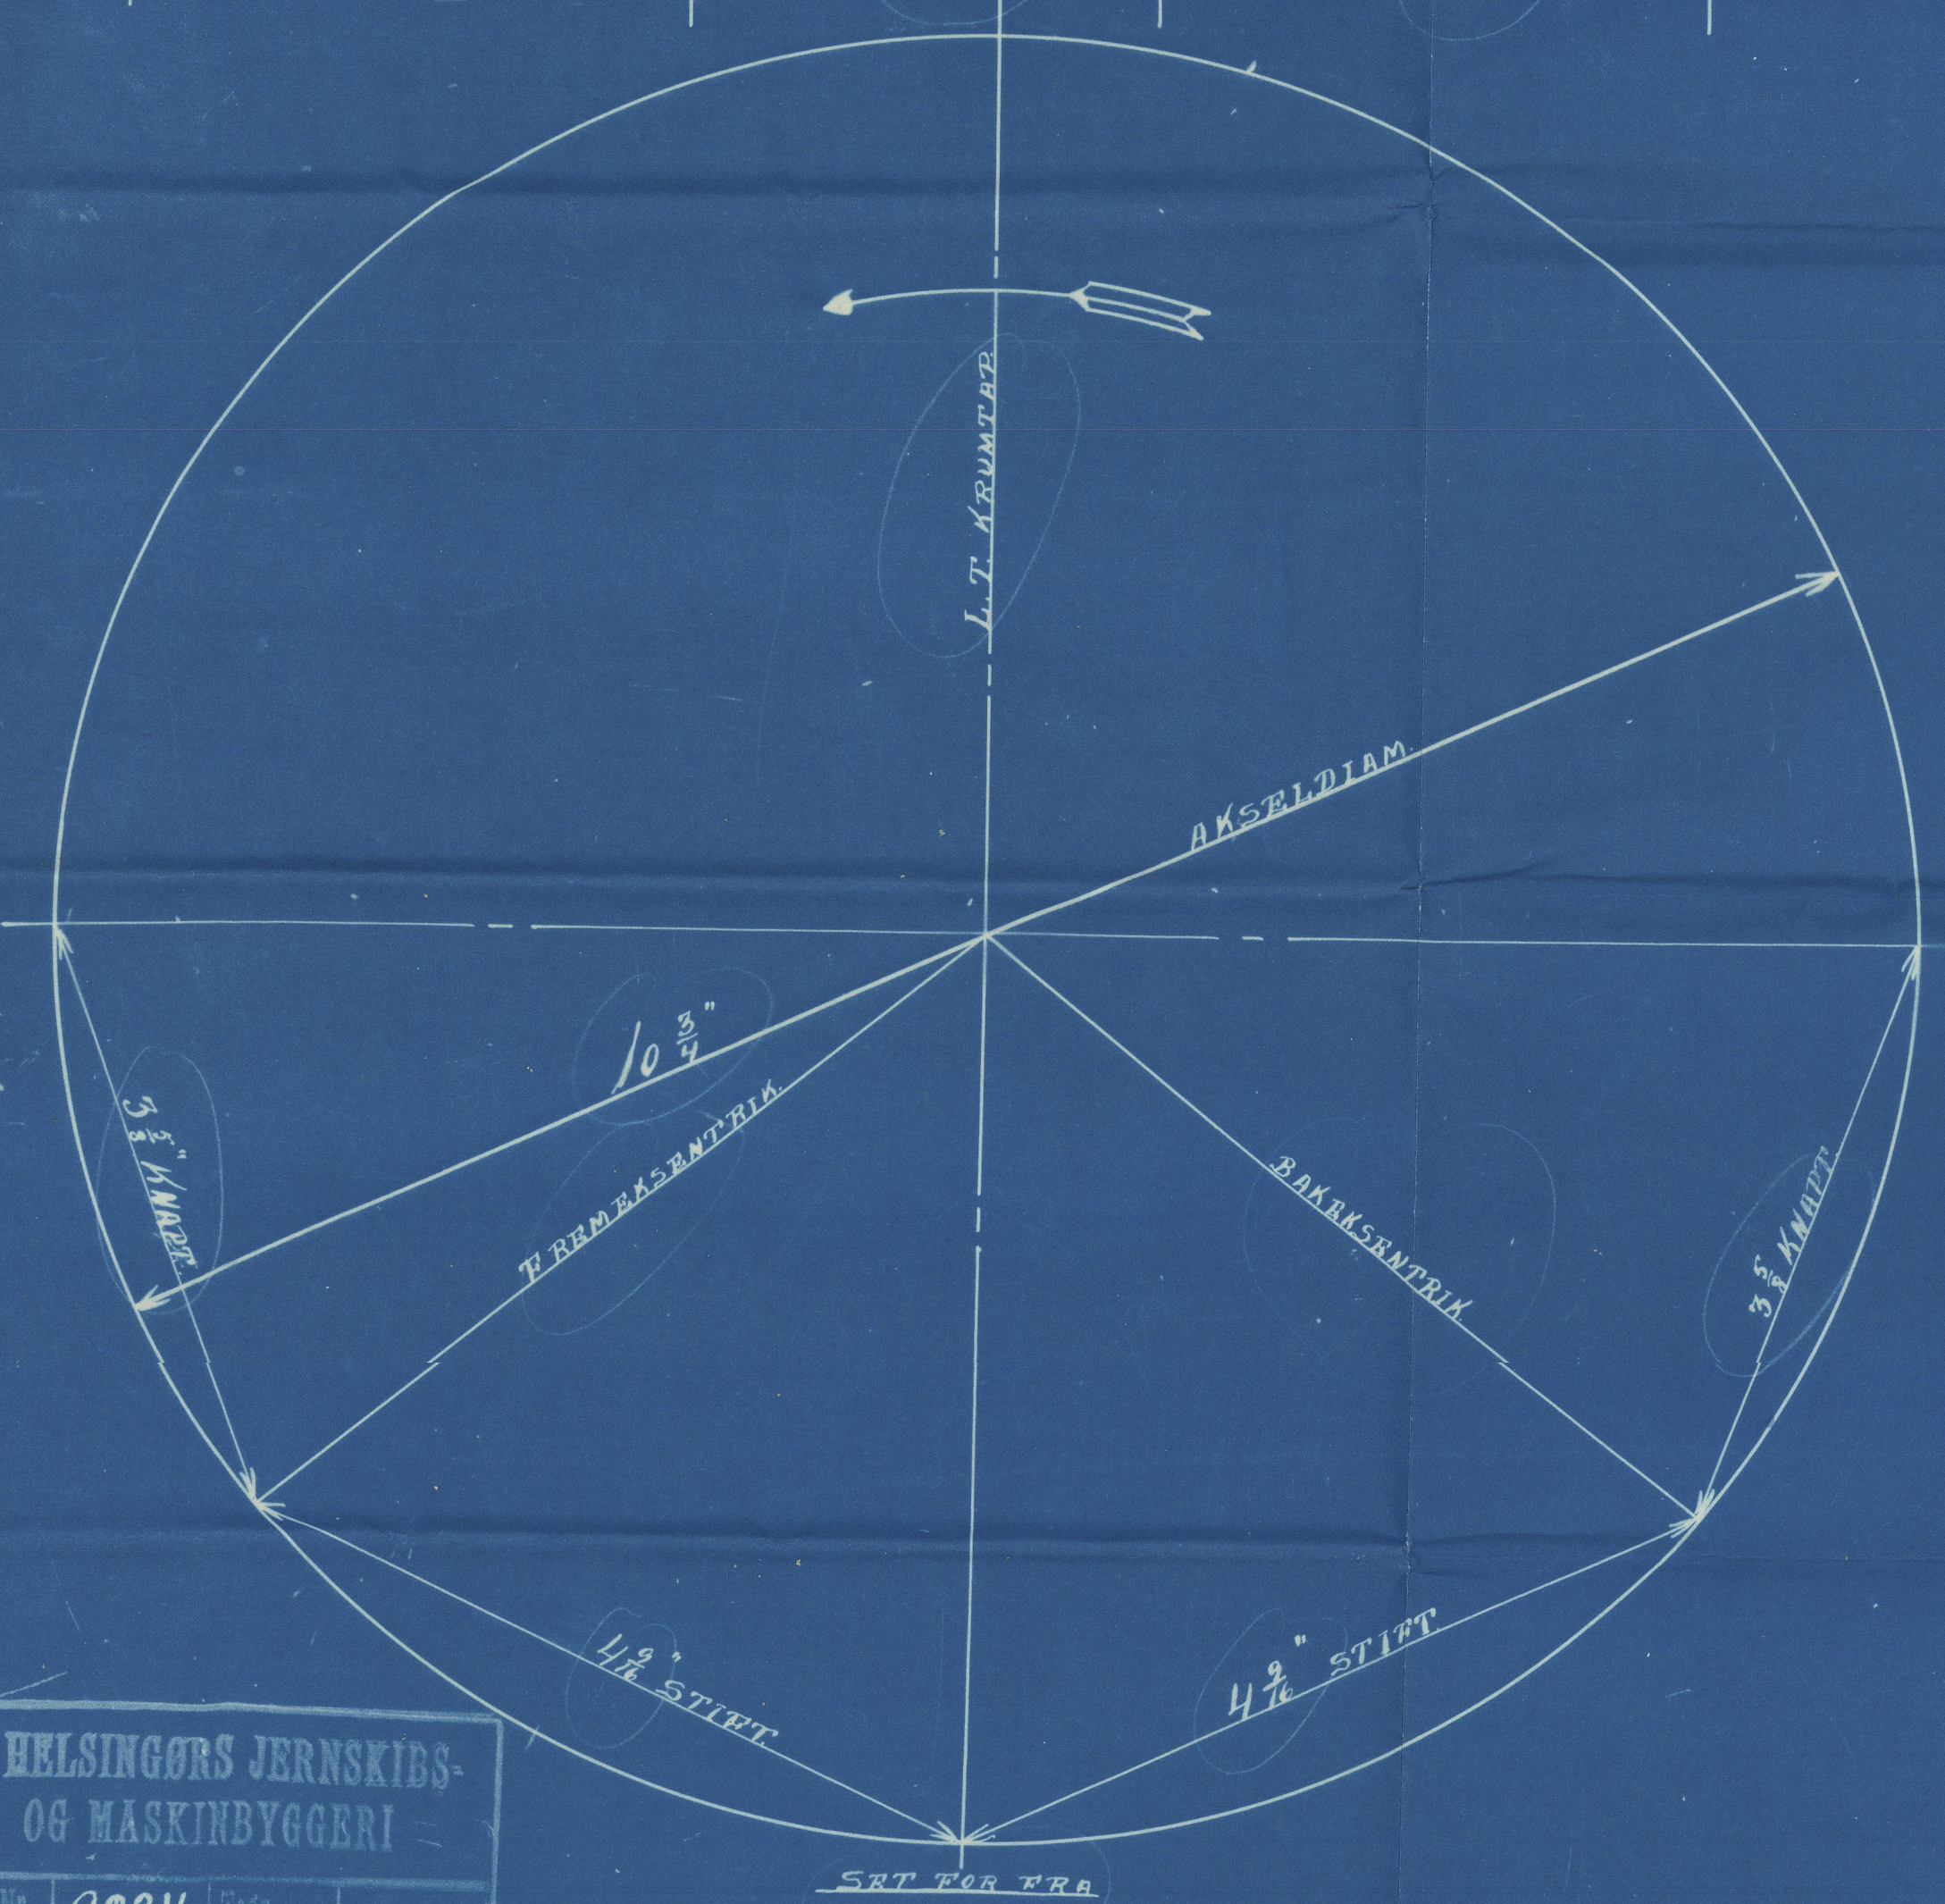

H. HELSINGØRS JERNSKIDS- OG MASKINBYGGERI			
Tegn. Nr.	9234	Tegn.	
Dato	15-3-27	Kalk.	L.W.
Klasse	267	Kontrol	M.P.

# KRUMTAPAKSEL OG EKSENTRIKVINKLER


STYKLISTEN UDREKS		BEMÆRKNINGER	TEGNING I VERKSTED
FORARB. NR.	ANTAL GÆLDER		
254 M	1		15-3-27


W223-0030



Crank shaft

for a new engine being con-  
structed by Messrs.

% Helsingør's Jernskibs- og  
Maskinbyggeri for  
the % "Fredensborg"  
of Copenhagen.

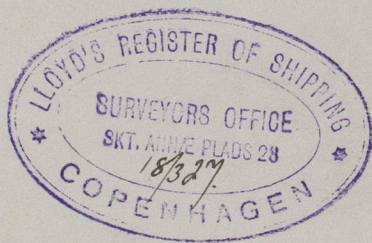

Copenhagen Report No. 7535



© 2019

Lloyd's Register  
Foundation  
W223-0040