


W223-0181.1

Doorsnede over machinekamer.

S. S. Guleboel.

Sketch showing position
of Man Rats and
D.M. in Engine room.

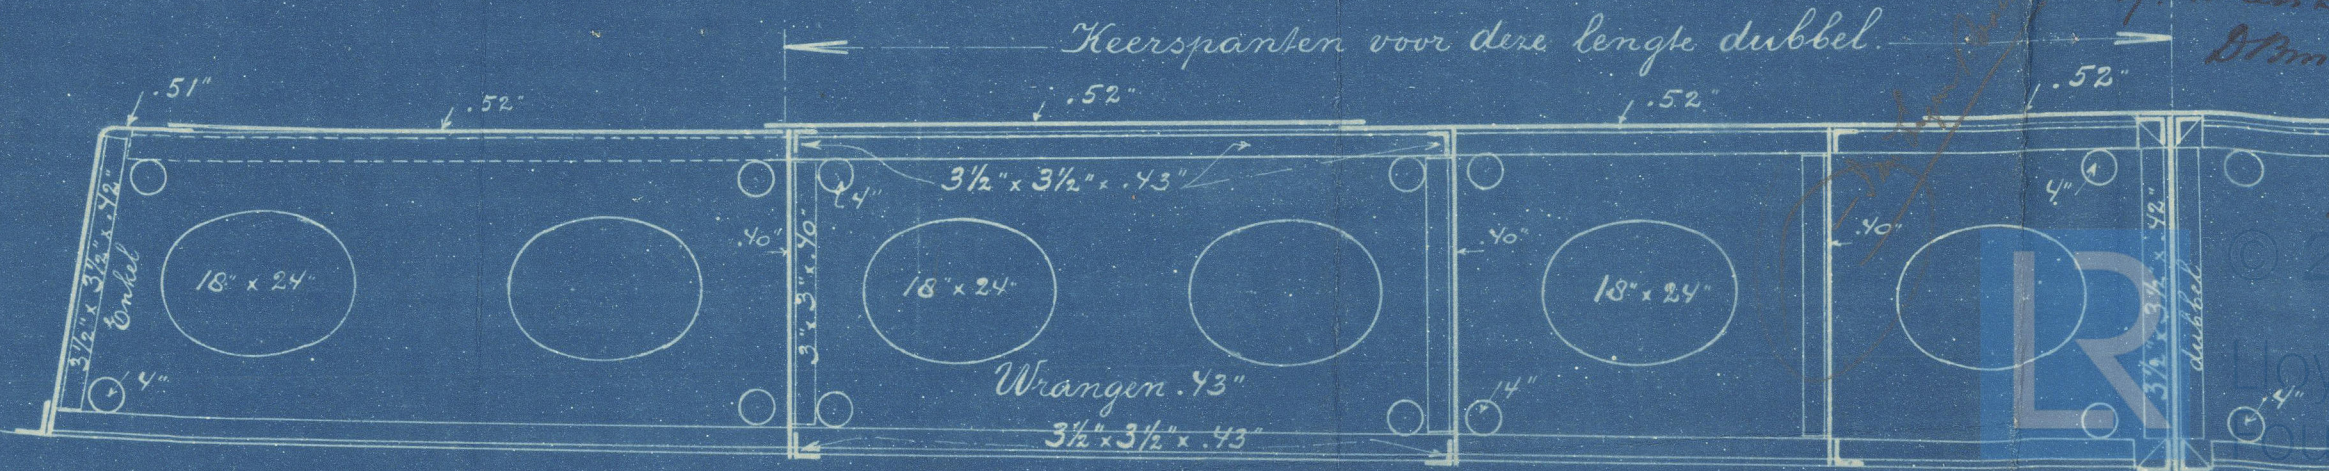

See London
Letter 27/10/18
and my reply.

2/11/18
D. H. H. H.

Lloyd's Register
Foundation