

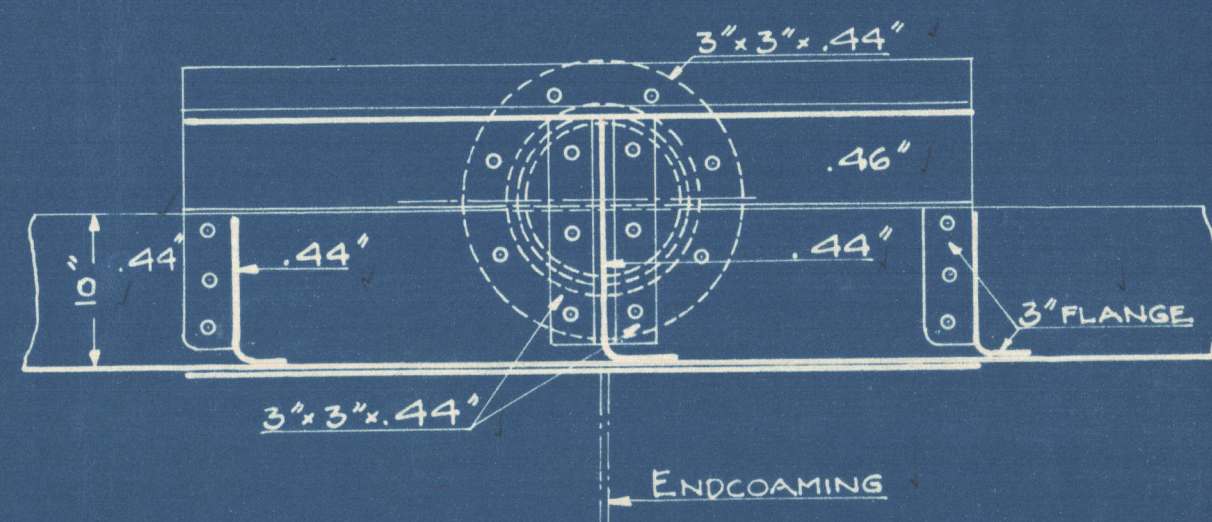


HATCHCORNERS  
SCALE 1/12

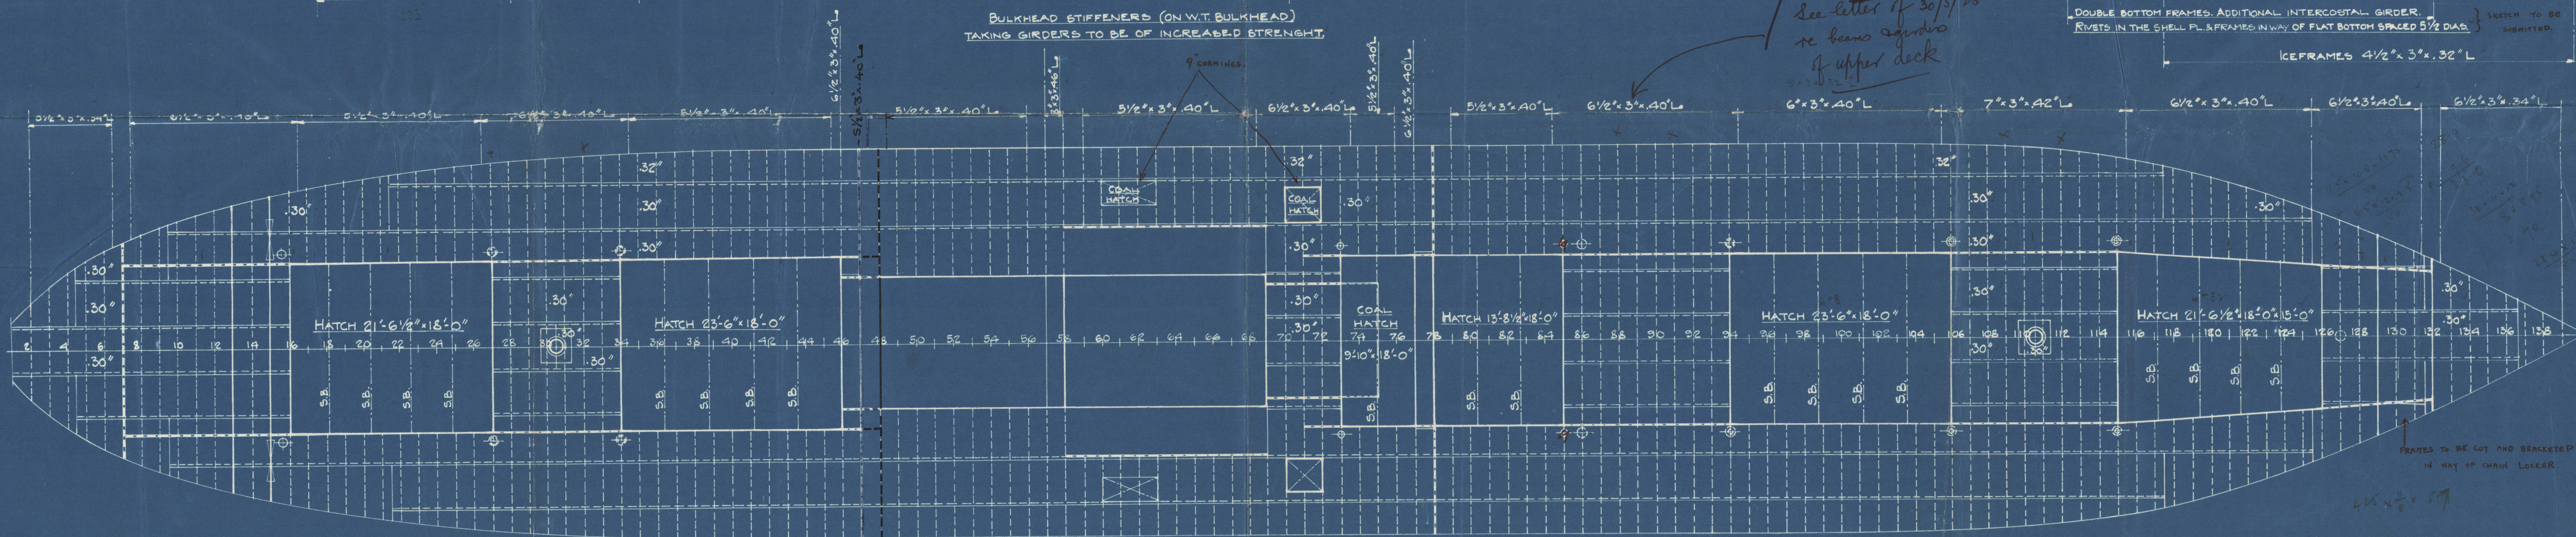

SHEER AT STEM 7'-3"  
" " 1/8 FROM STEM 4'-5"  
" " " STERN 1'-4"  
" " STERN 2'-9"


BLOCK COEFFICIENT 0.735

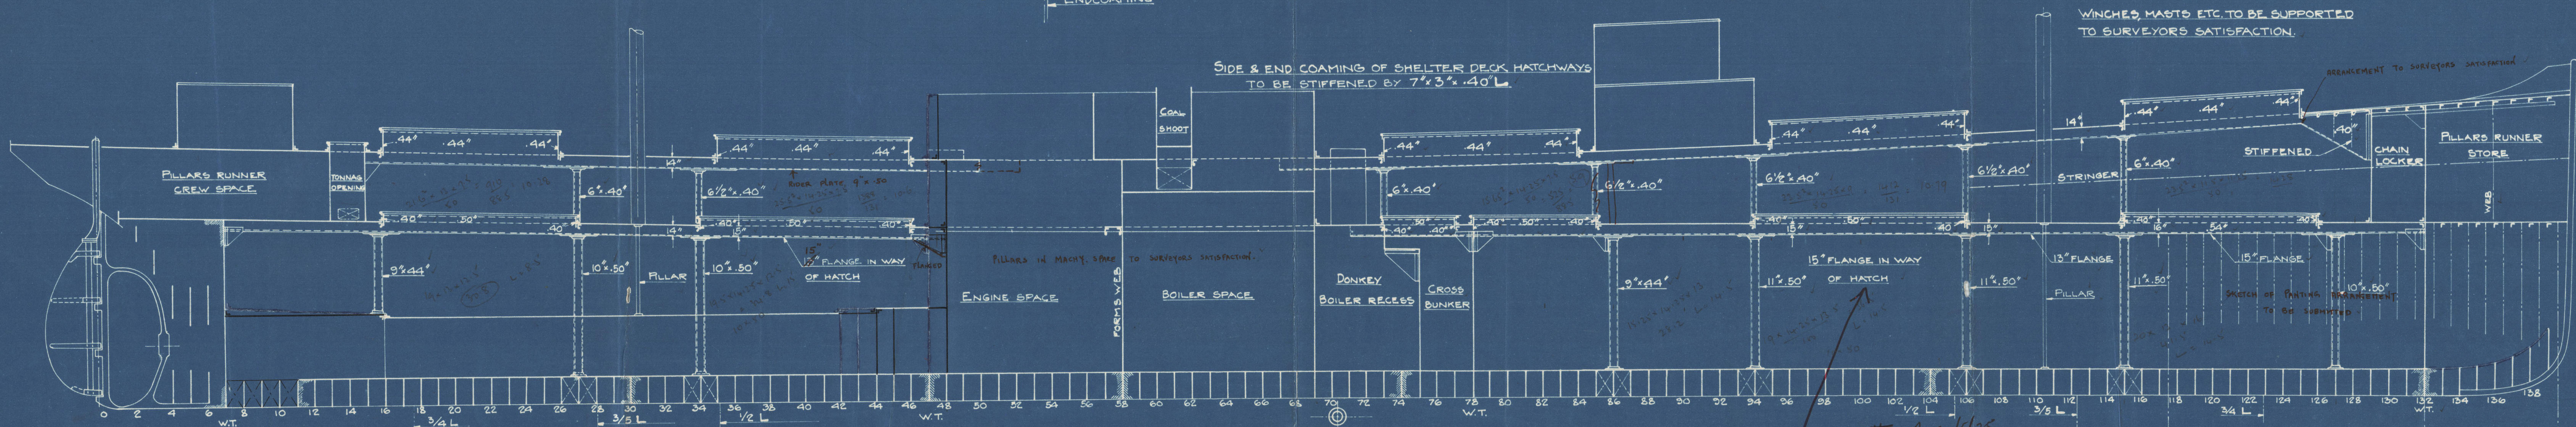

PLAN OF UPPER DECK

DECK UNDER WINCHES TO BE SUPPORTED TO SURVEYORS SATISFACTION.

NOTE- THE BREDTH OF THE DECKS ARE AT SCALE

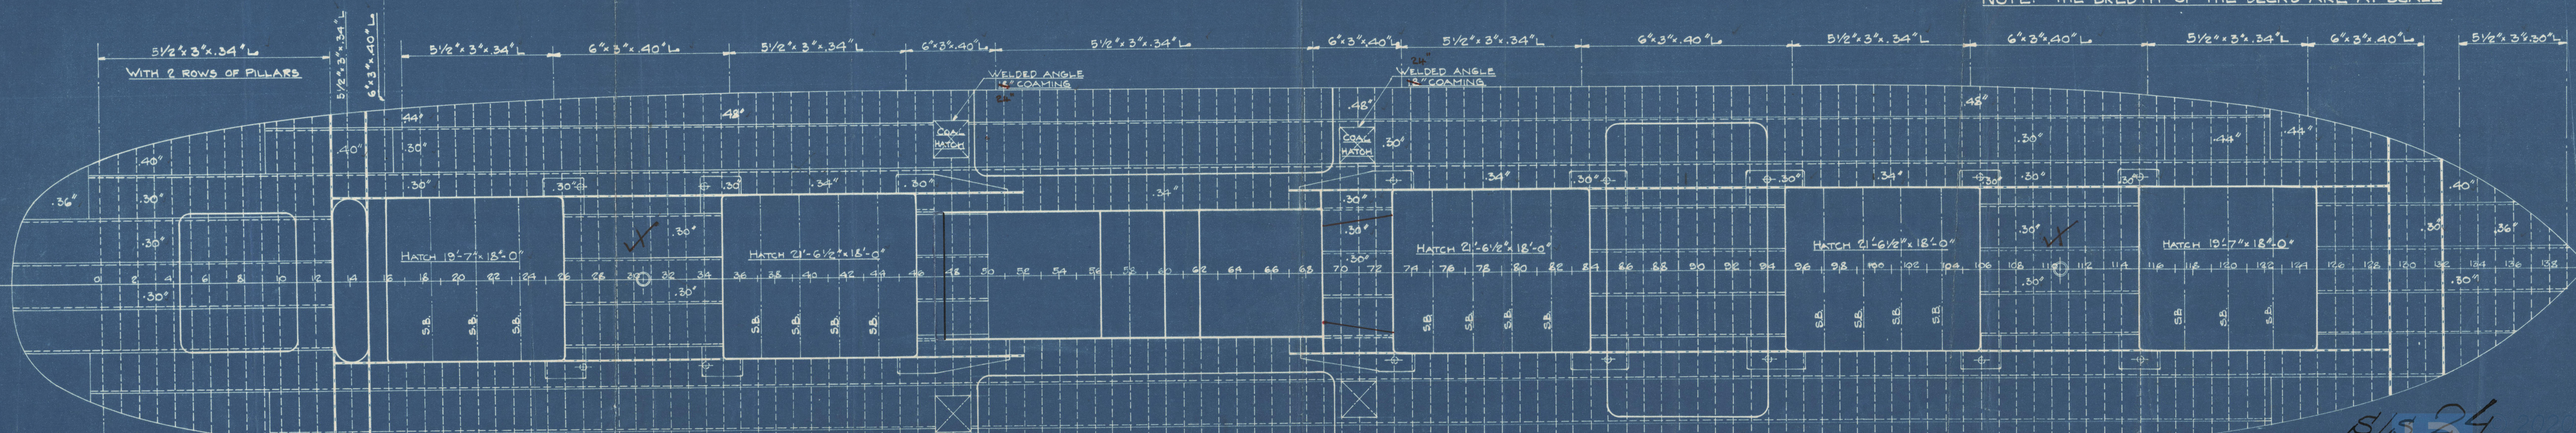

PLAN OF SHELTER DECK

N/A VARYSA-3 ÖRESUND  
LANDSMÖRÖN.  
14-3-25.

PROFILE AND PLANS  
SCALE 1:96

F6399

W226-0084



Profile & Plans.


S/S N: 24

Nya Varos AB. Öresund,  
Landskrona.

~~Item 583.~~

S.S. "Valencia"

Hög. 53.

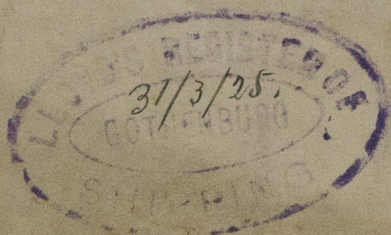

© 2020

Lloyd's Register  
Foundation

W226 0084