

Butt strap connection
"Veerhaven"

Ant 20368







W226-0140

© 2019

Lloyd's Register
Foundation

SS "VEERHAVEN"

CENTRE BOILER.
UPPER BUTTSTRAP CONNECTION
OF BOILERSHELL.

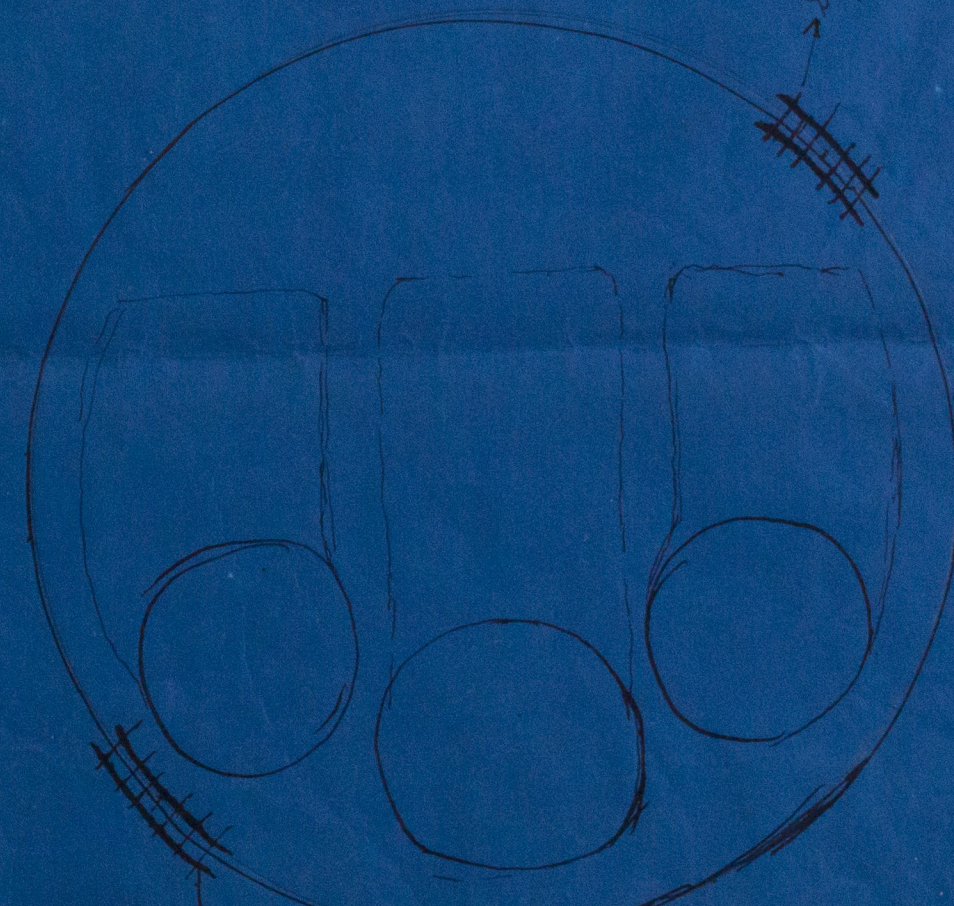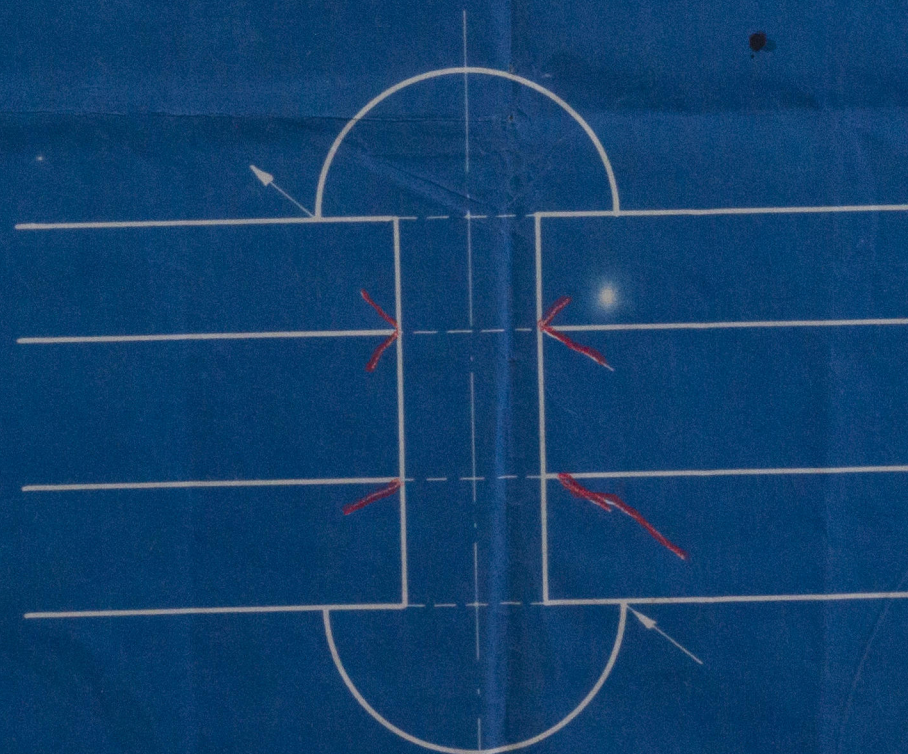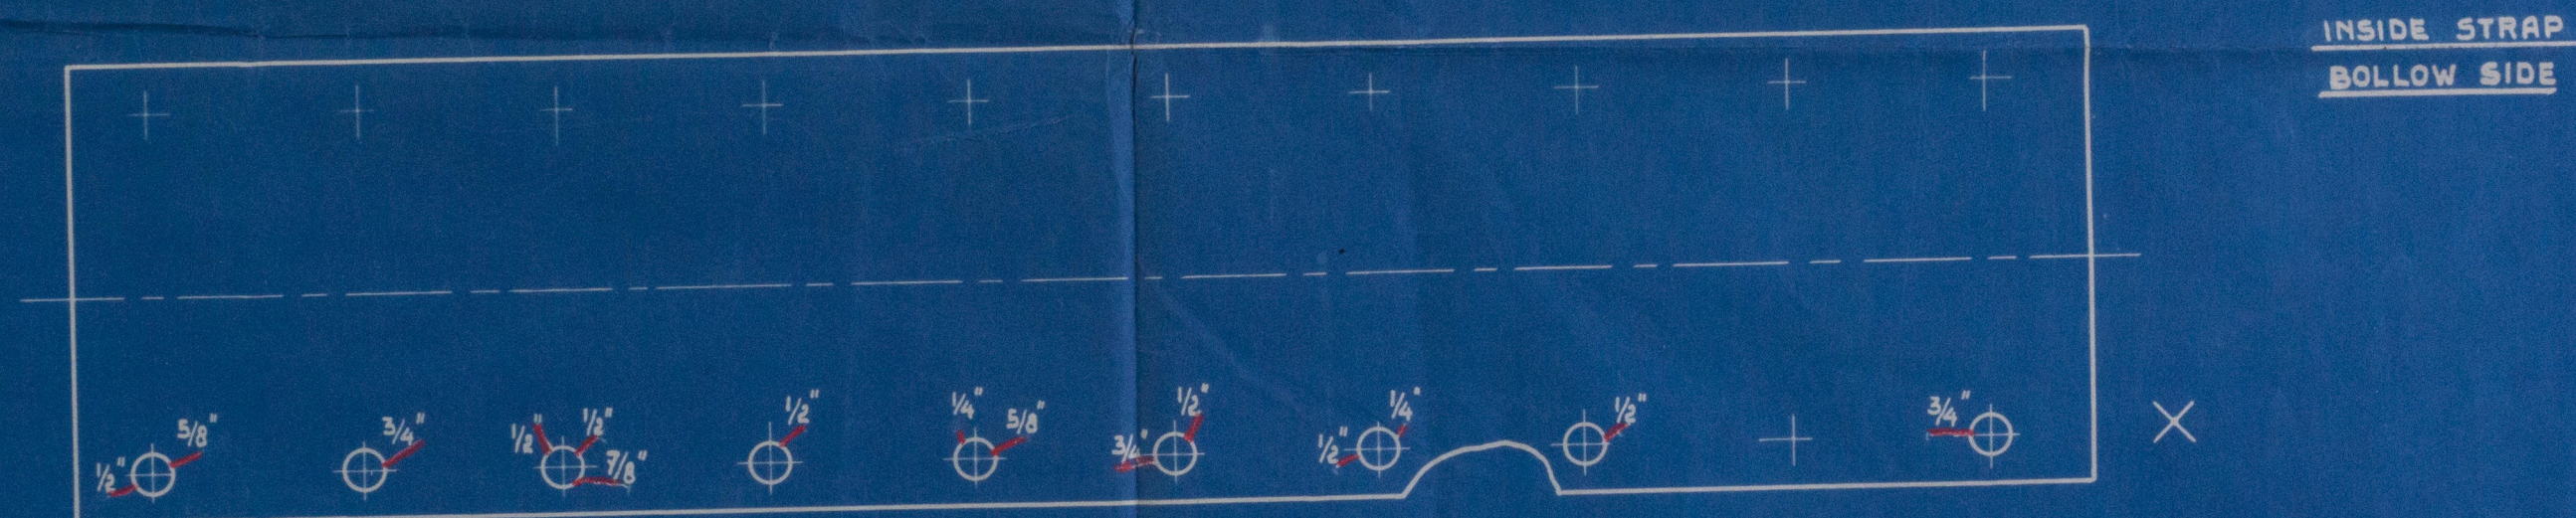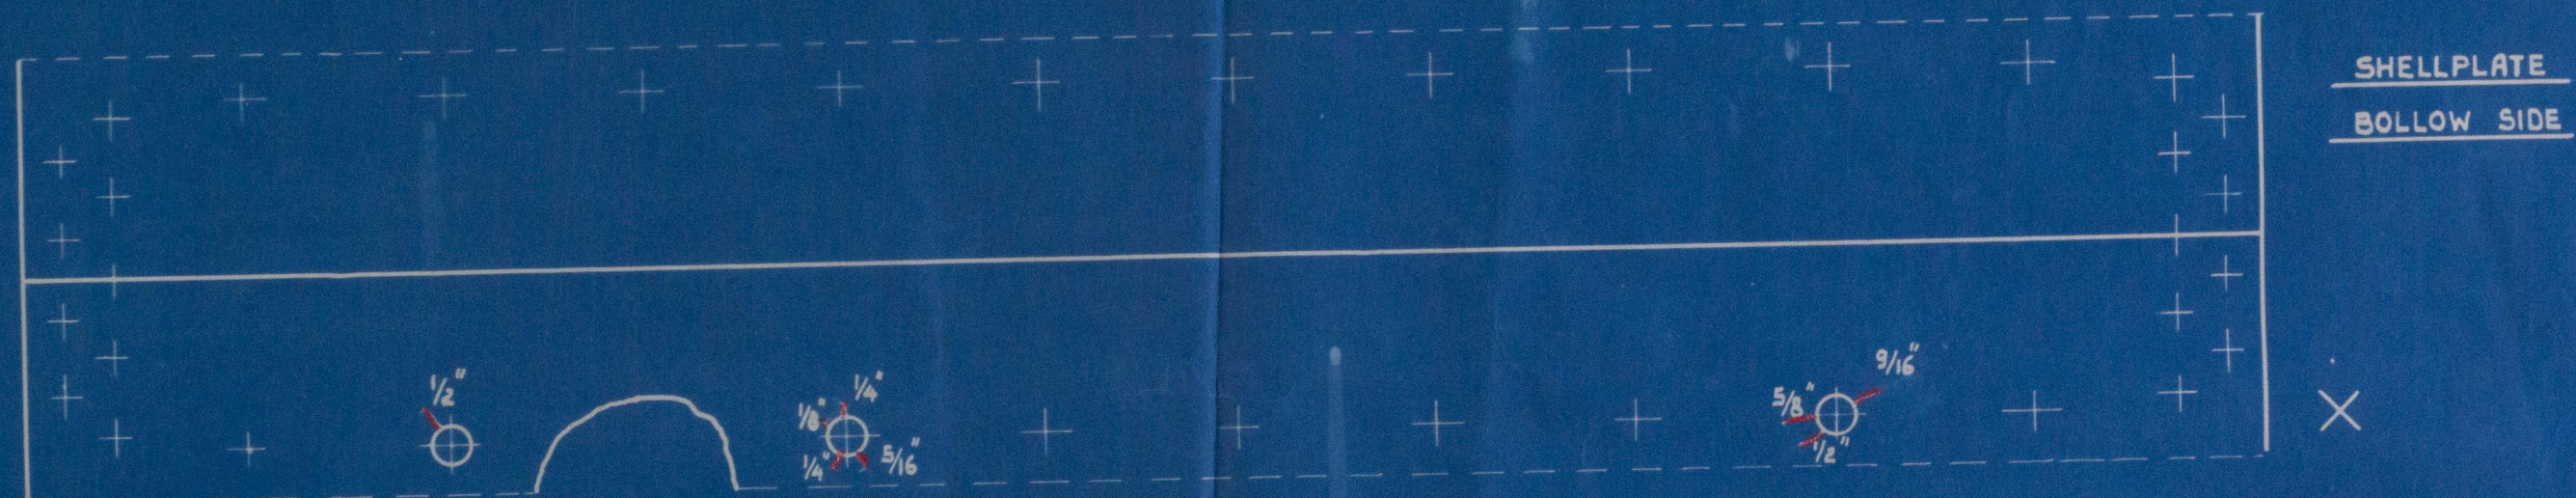

W226-0140

Defects all on this side of butt

Defects all on this side of butt