

"VEERHAVEN"

Classification (which must be entered in Register Book & Supplements)
Machinery and Boiler
Surveys
(including date of N.B., if any).

S.S. VEERHAVEN

SCHAAL 1/10 SCALE 1/10


CENTRE BOILER

UPPER BUTTSTRAP

UITGENOMEN NAGELEN - REMOVED RIVETS. (5 OFF.)

SKETCH A

BUITENZICHT. - OUTSIDE VIEW.

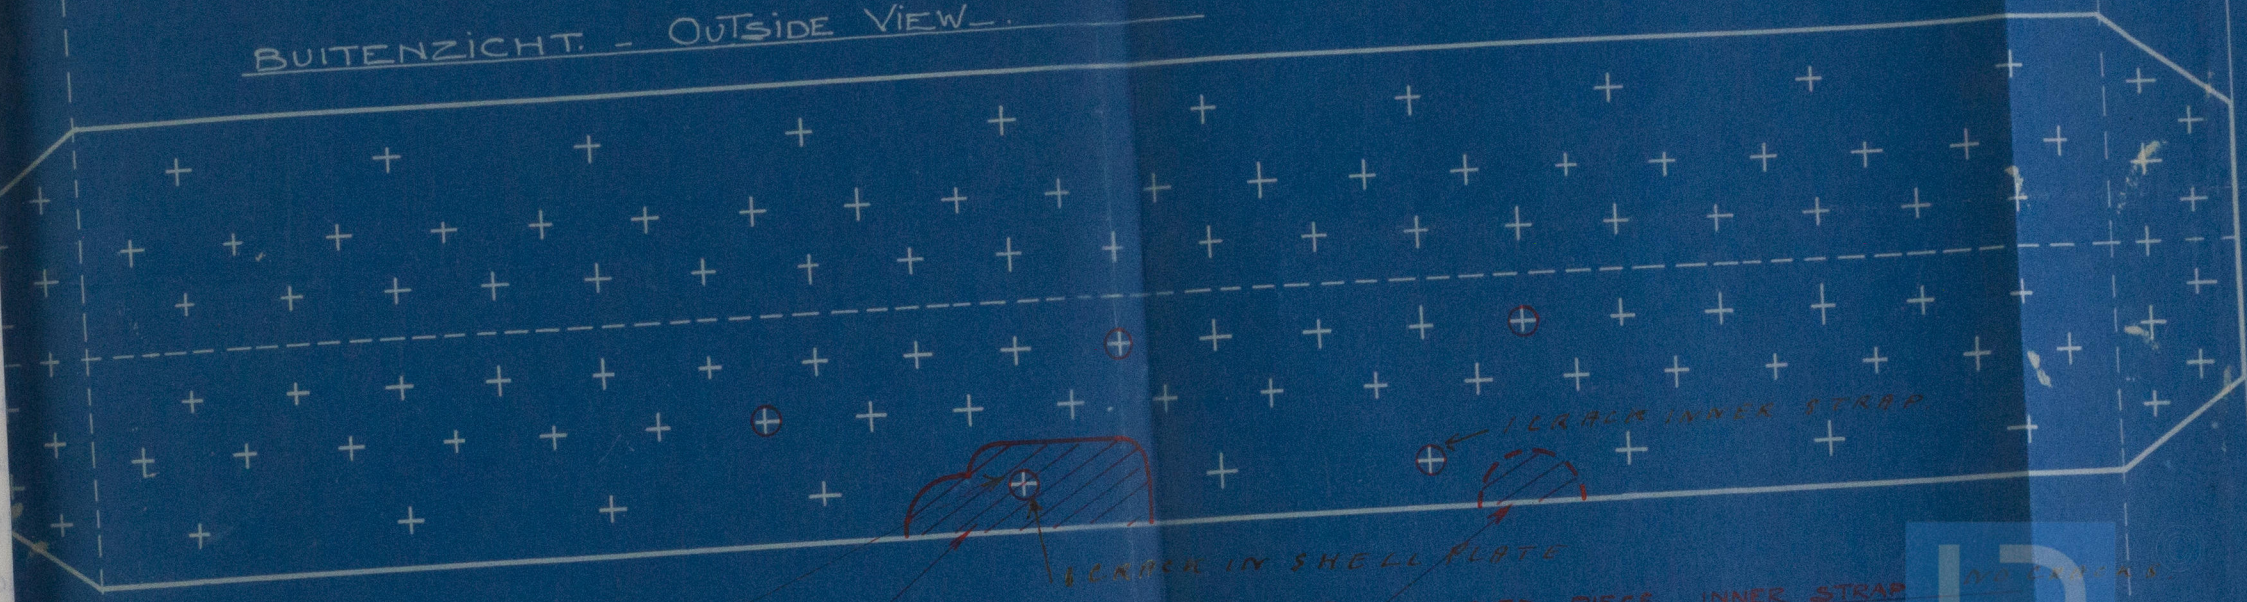

FORWARD


REMOVED PIECE OUTER STRAP

REMOVED PIECE INNER STRAP

HOLE REAMERED
OUT TO 36 mm.

MERCANTILE MARINE ENGINEERING AND GRAVING DOCKS C^o. N.M. ANTWERPEN 4/12/35.

W126-0175

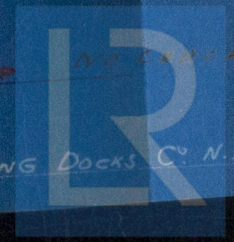

Foundation