

C<sup>o</sup> N.M. ANTWERPEN 4/12/35.

ESN (See Cont<sup>re</sup>)


S.S. VEERHAVEN.

SCHAAL 1/10. SCALE 1/10

PORT BOILER  
UPPER BUTTSTRAP

OUTGENOMEN NAGELN - REMOVED RIVETS. (2 OFF)  
NO CRACKS.

BUITENZICHT. - OUTSIDE VIEW.

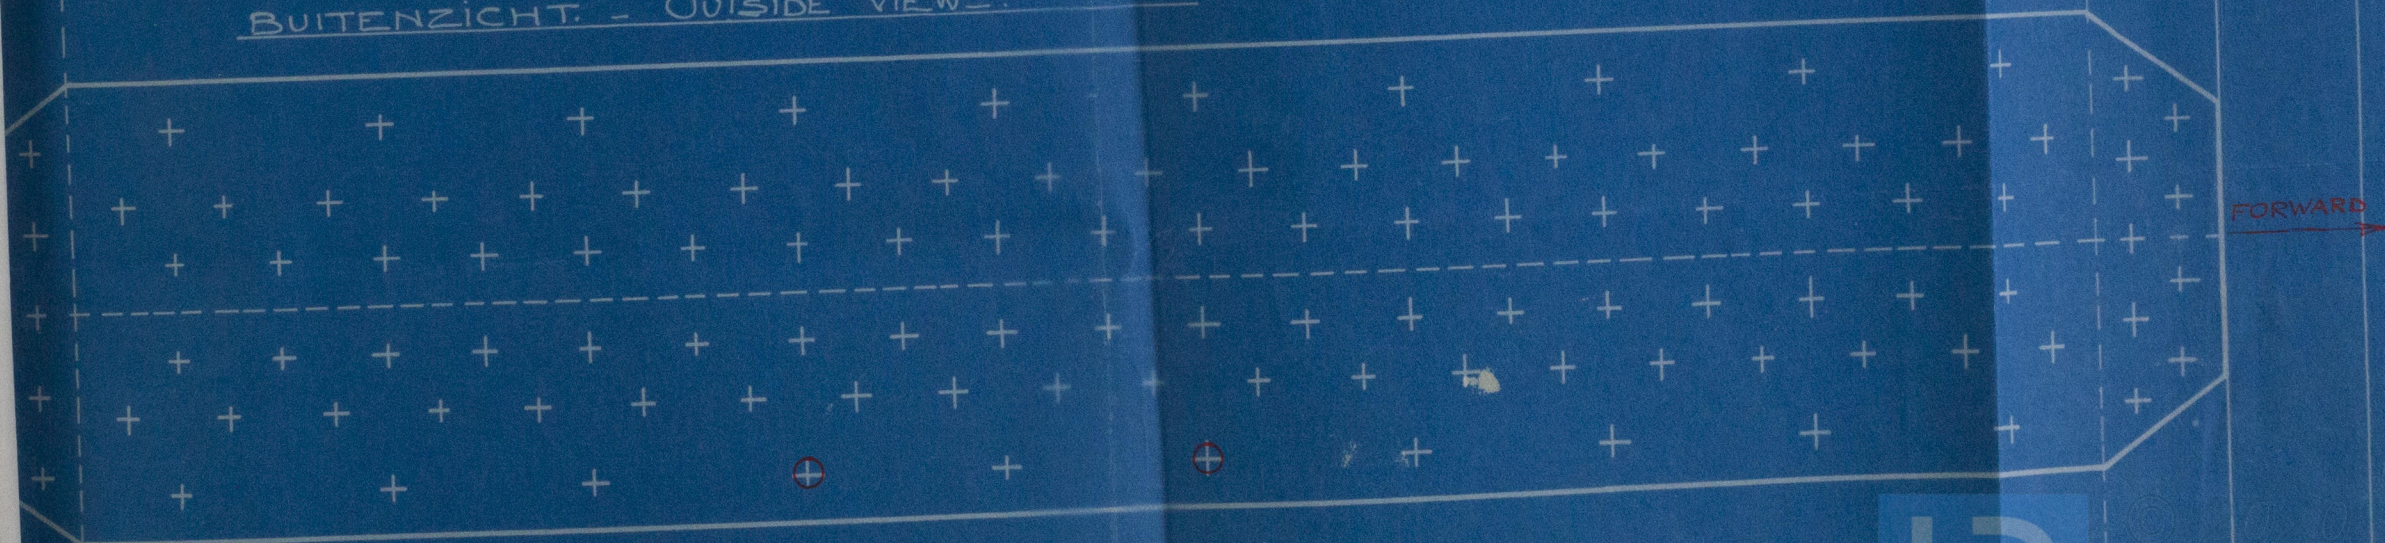

W226-077

MERCANTILE MARINE ENGINEERING AND GRAVING DOCKS C<sup>o</sup> N.M. ANTWERPEN 4/12/35.

P.T.O.

Certificate

226-0