

S.S. "VEERHAVEN."

SCHAAL 1/10 SCALE 1/10


BUITENZICHT. OUTSIDE VIEW.

CENTRE BOILER

LOWER BUTTSTRAP

QUITGENOMEN NAGELN. REMOVED RIVETS (3 OFF)

NO CRACKS.

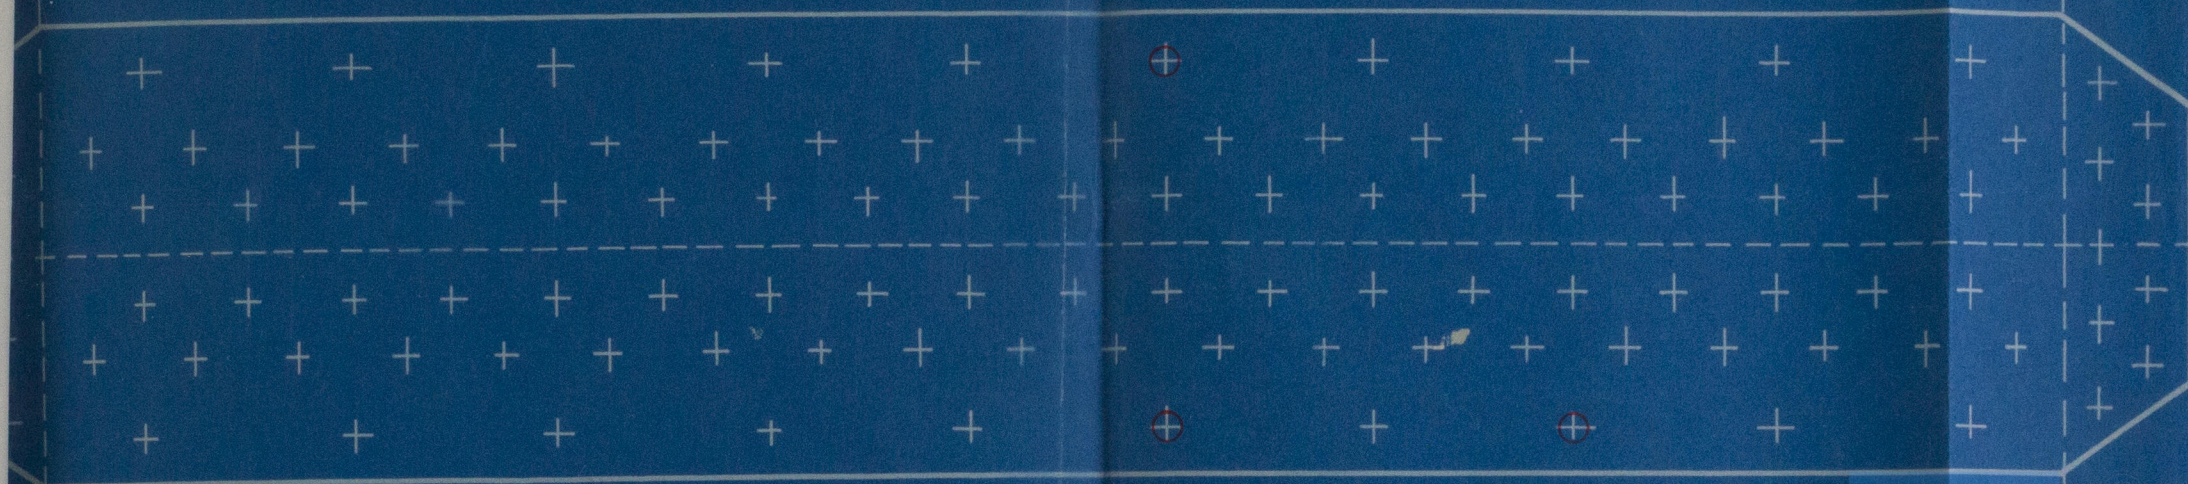

W226-0178

MERCANTILE MARINE ENGINEERING AND GRAVING DOCK CO. N.M. ANTWERPEN 4/12/35.