

MANHOLE ON STROKEHOLE SIDE OF CASING

POSITION OF STAYS ON CHAMBER WING SIDES

TENSILE STRENGTH OF SHELLS, BUTTS, & MANHOLE RING.	29 to 33 TONS
" " " LONGITUDINAL STAYS.	28 " 32 "
" " " FURNACES.	26 " 28 "
" " " ALL OTHER PLATES.	26 " 30 "
" " " SCREW STAYS.	26 " 30 "
" " " GIRDER PLATES.	28 " 32 "
" " " RIVET BARS.	26 " 30 "

FOR MESSRS W^M HARKESS & SONS LTD s/s No ~~200~~ 204

1 BOILER REQUIRED

N^o 403. 1 BOILER 12'-6" DIAMETER.
AND 2 " 12'-0" " } N^o M. 2212



W228-0072

Richardson, Westgarth H^o & Co.

Main Boiler


N^o. 2212

for

W. Harkness & Sons


S.S. N^o. 204

W. P. 215 lbs

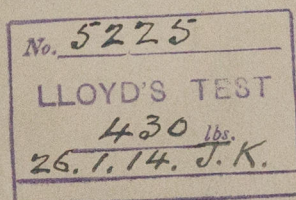

S.S. Galerman
Indb Rpt- no 8560

N.V. "Votivino"

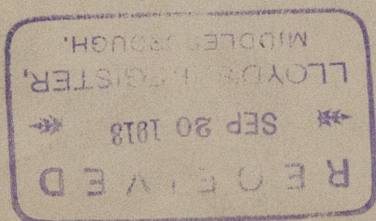

© 2019

W228-0072

Lloyd's Register
Foundation