

MIDSHIP SECTION

NUMBERS

8 4216 !
 0 2670 ! 22.5.13.
 68951 1ST NUMBER 10.12.13.
 318 !
 21926 2ND NUMBER !

LITTLE d UNDER 14. FORE BODY 20.96 AFTER BODY.
PROPORTIONS.

To UPPER Dk. For^d 11-87 D To L
BRIDGE Dk AFT UNDER 10

DIMENSIONS.

LENGTH B.P. 318.0" BREADTH M.D. 42.2" DEPTH 26.9 1/2" For 24 LEAF
To CLASS LLOYD 100A.1

1/2 SCALE


EQUIPMENT.

2ND NUMBER 21926

POOP & BB 205' 6" }
FULE 40' 3" } 1692
CASINA 42' 6" }
D' HOUSE 25' 0" }

NUMBER: 23618

LETTER U

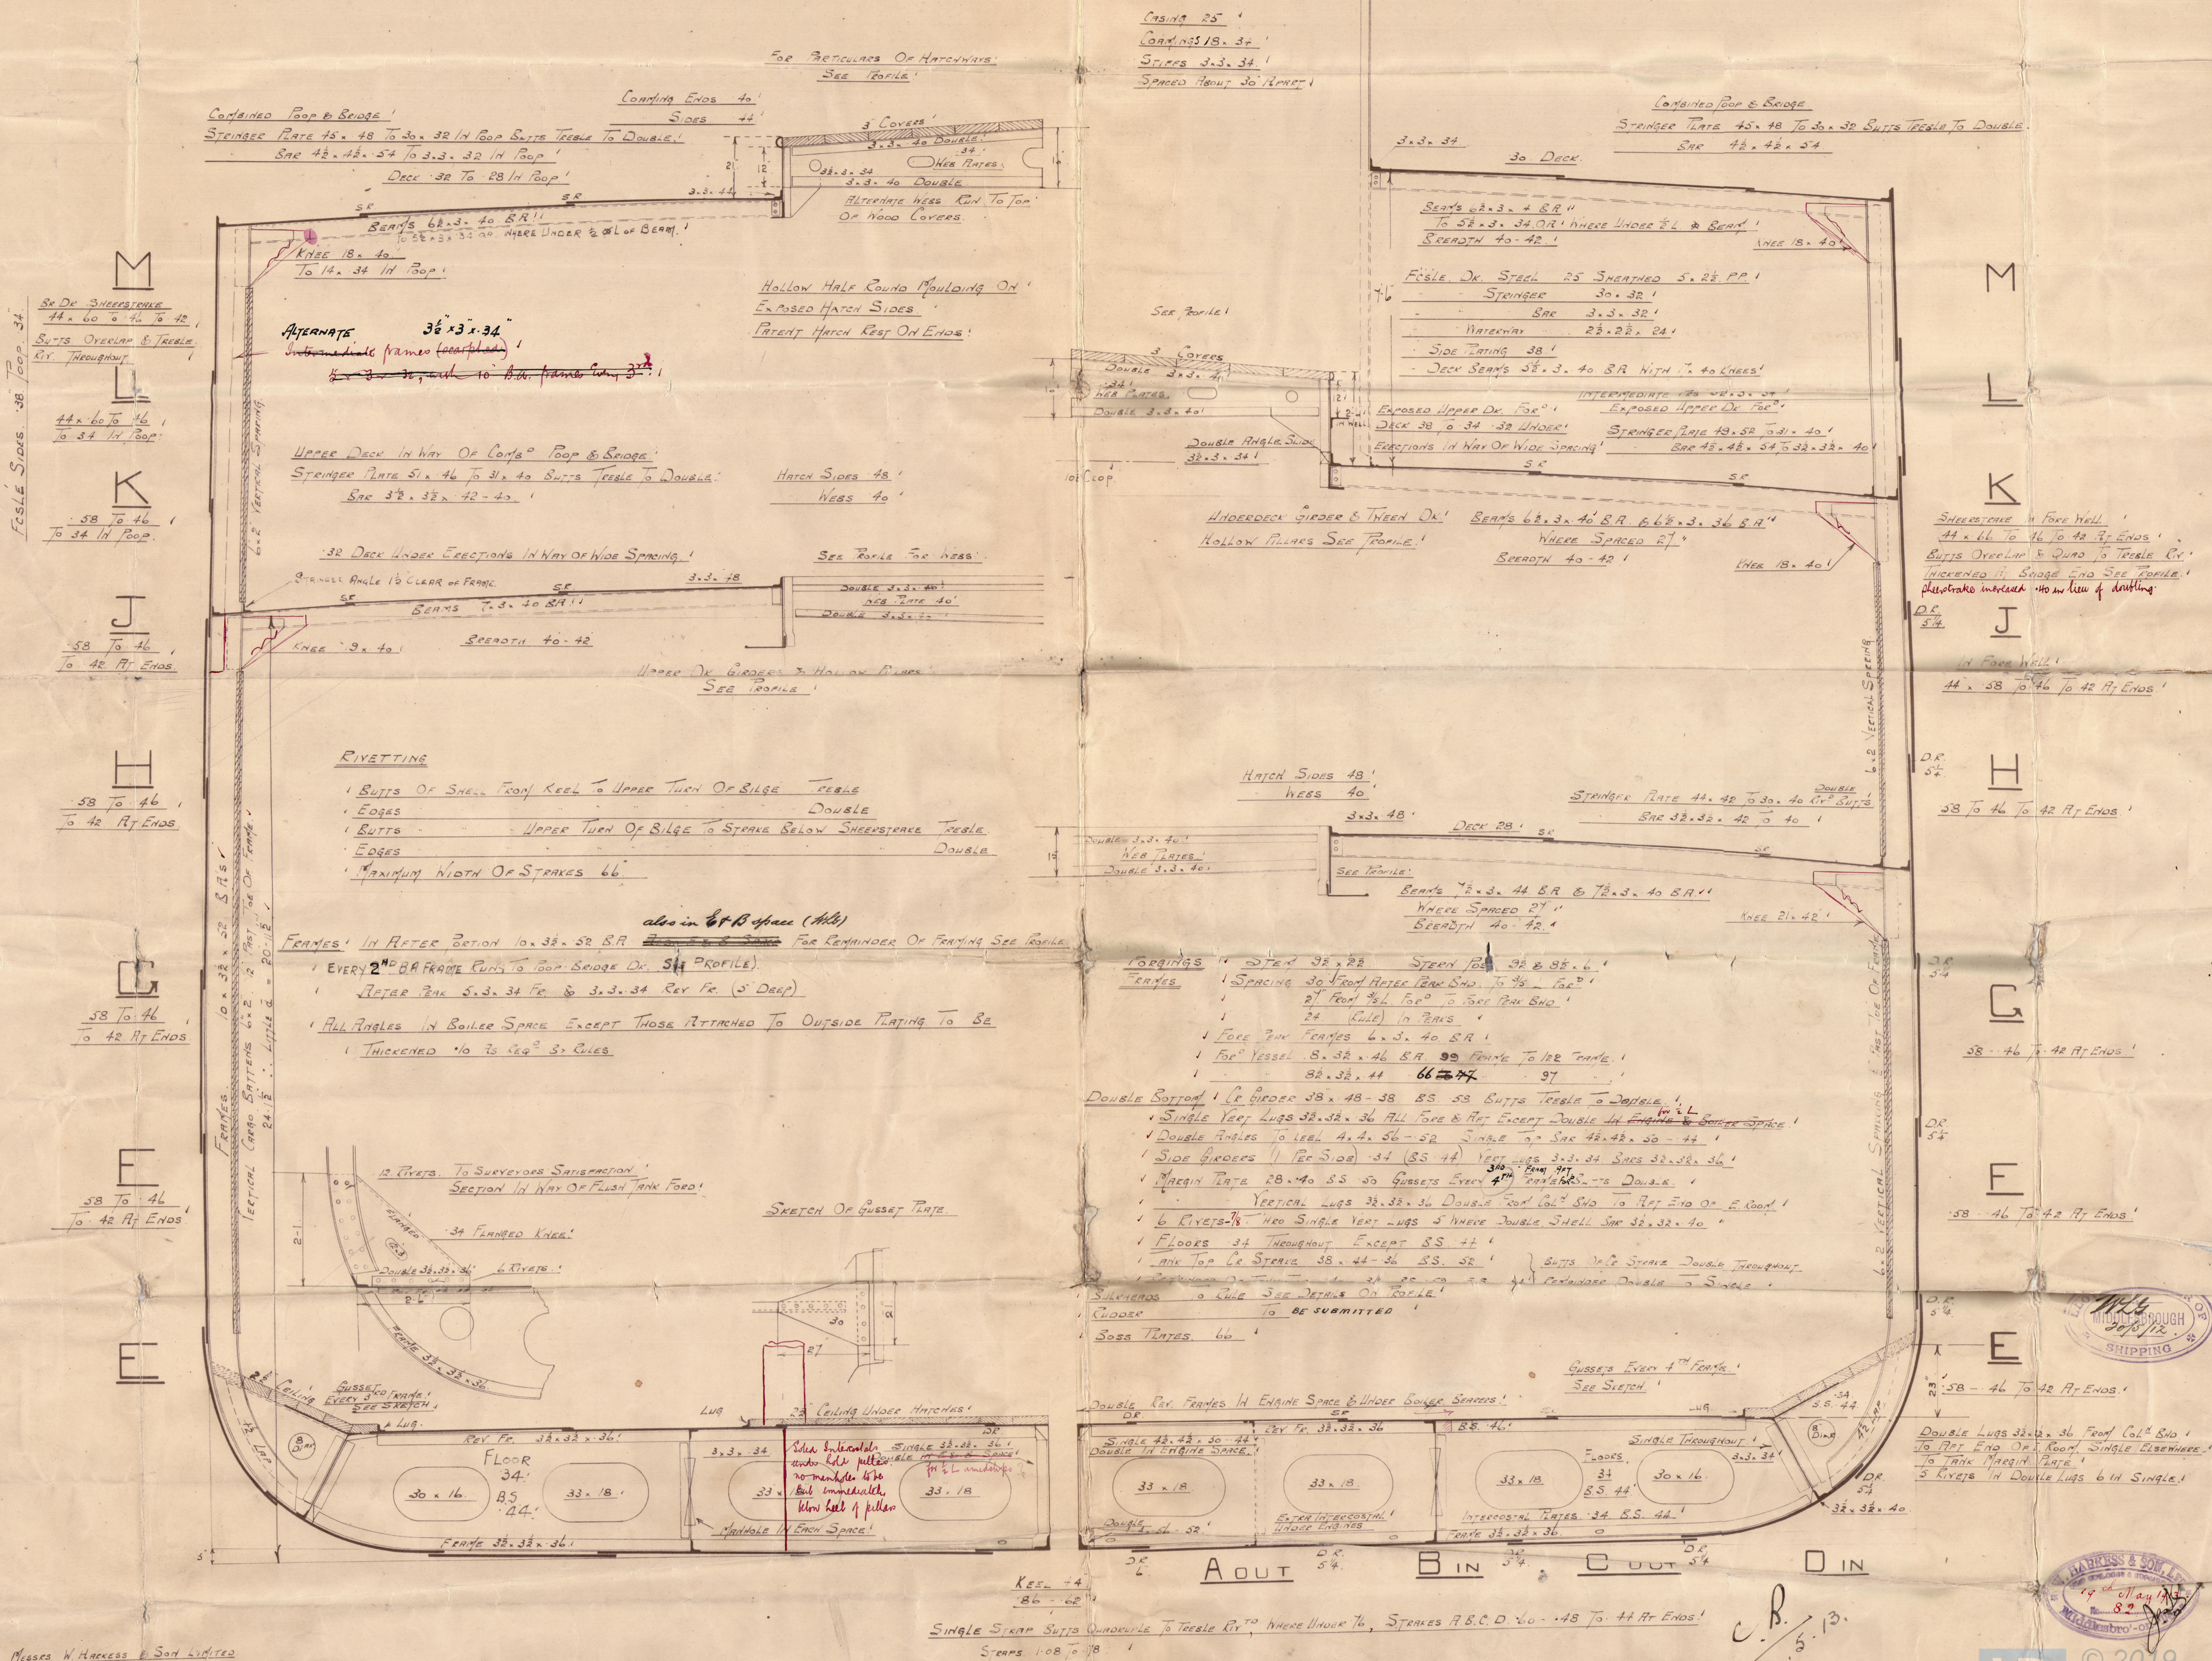

MESSRS. W. HARKNESS & SON LIMITED

SHIPBUILDERS & REPAIRERS,

EAST SLIPWAY,

MIDDLESBROUGH - ON - TERS.

SINGLE STRAP BUTTS QUADRUPLE TO TREBLE RY^{TO}, WHERE UNDER 7/8, STRAKES A.B.C.D. 60 - 48 TO 44 AT ENDS.
STRAPS 108 TO 78: 1

C.B. / 2.5.13

Nº 204

© 2019
Lloyds Register
Foundation





W228-0074

Midship Section

S.S. "FALEARNIAN"

M^o
Cldb. Rpt. No. 8560

N.N. *Vothurns*

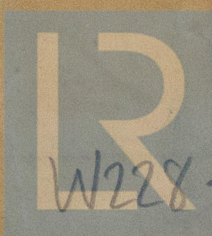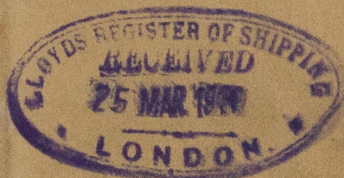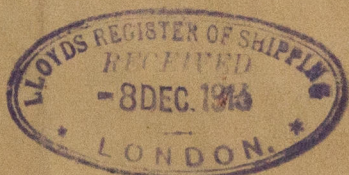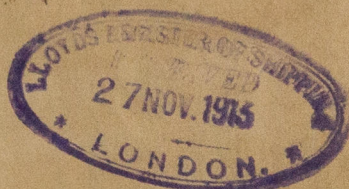

© 2019

Lloyd's Register
Foundation