

22513  
10.12.13

# PROFILE AND DECK PLANS

STEEL SCREW STEAMER

DIMENSIONS 318-0 BP 42-2 BREADTH, 26-9% FOR 24-13 FT DEPTH

TO CLASS 100A LLOYDS


1/8 SCALE

LONGITUDINAL N° 21926

TRANSVERSE N° 68-05

DETAIL OF PILLAR HEAD AT 82-3 & 111-11 MARKED S






DETAIL OF PILLAR HEAD MARKED O

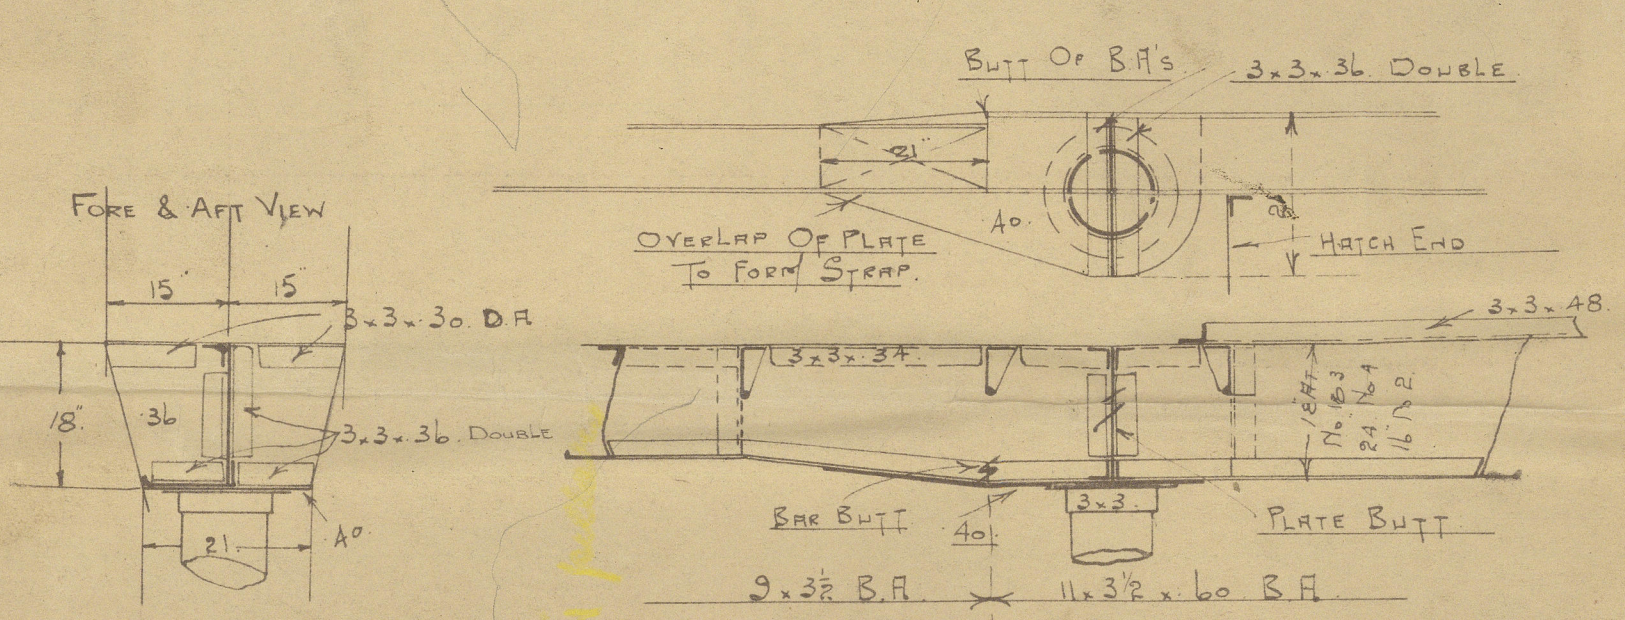

DECK GROSS CLEAR OF HATCHES

SPIDER DECK

LONGITUDINAL N° 21926

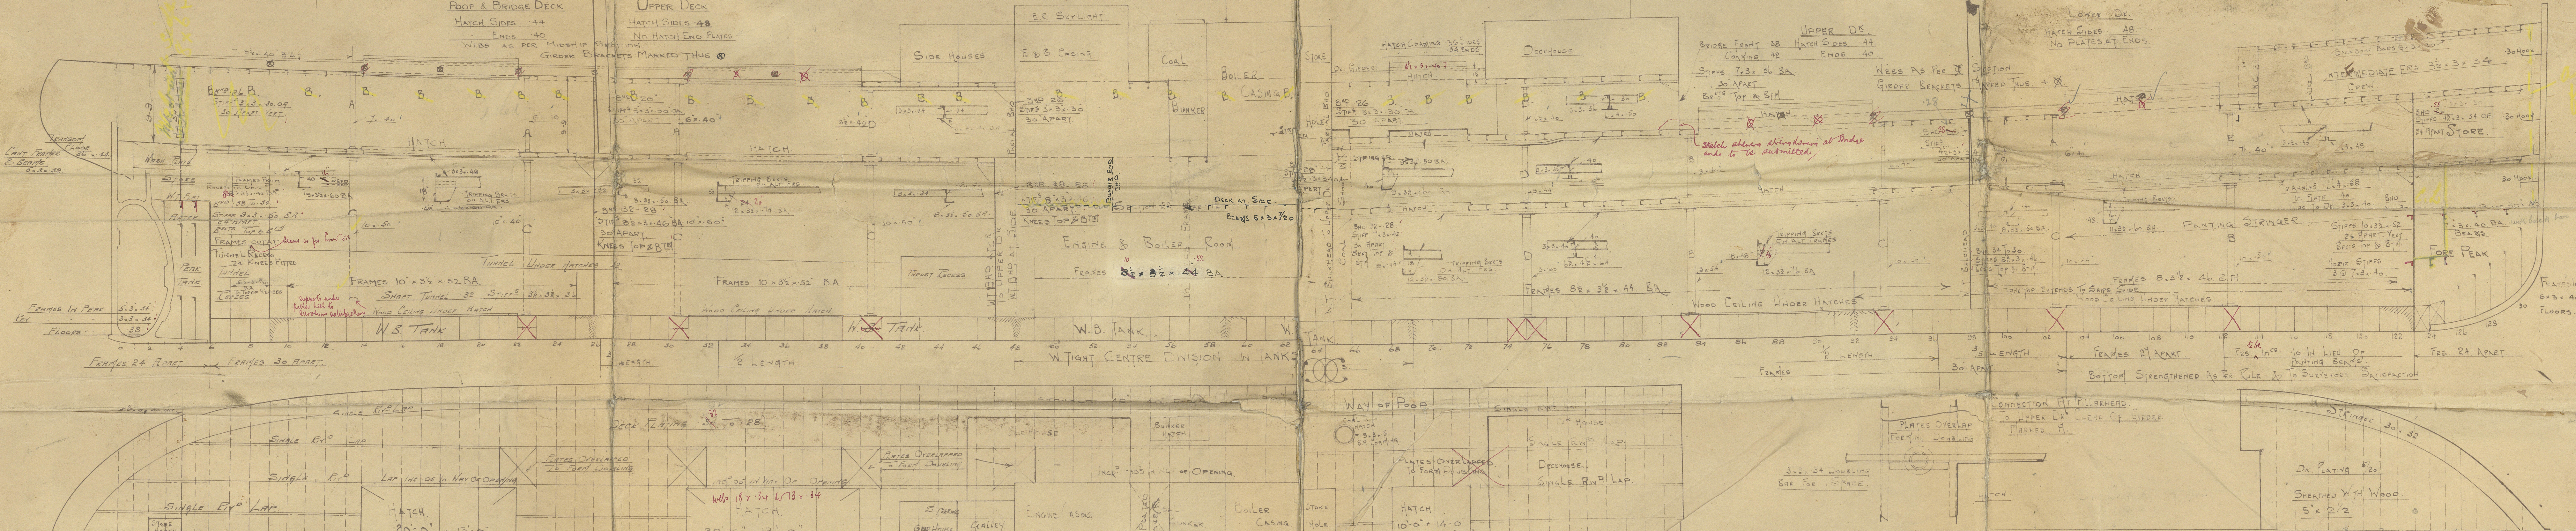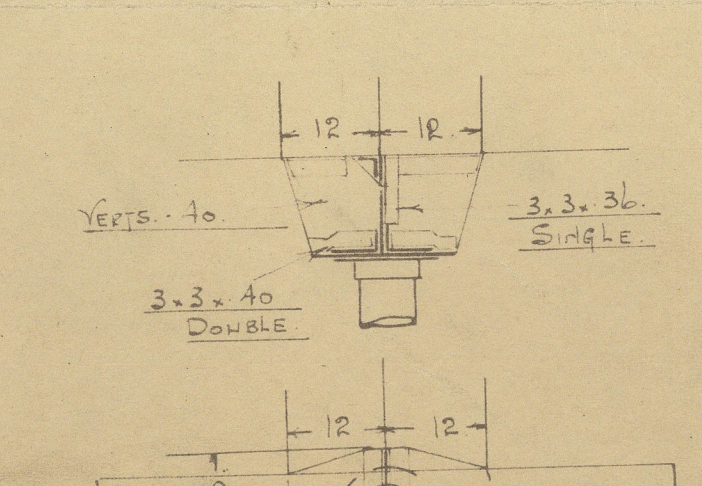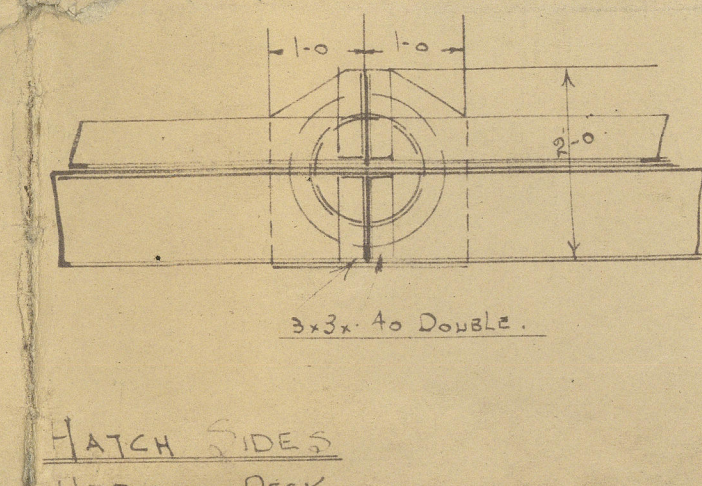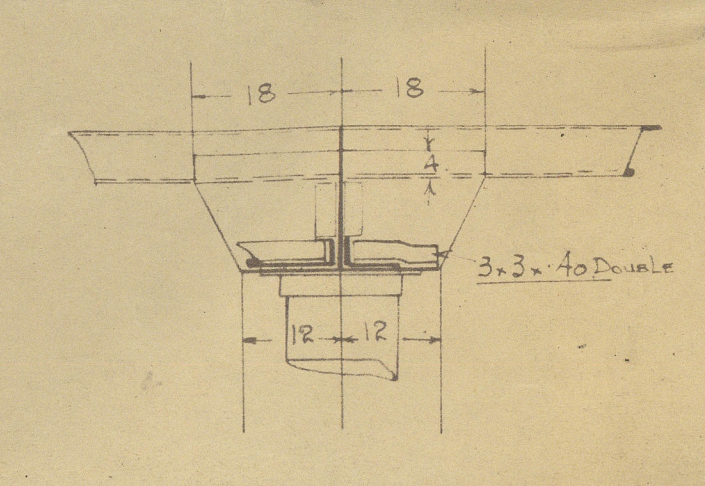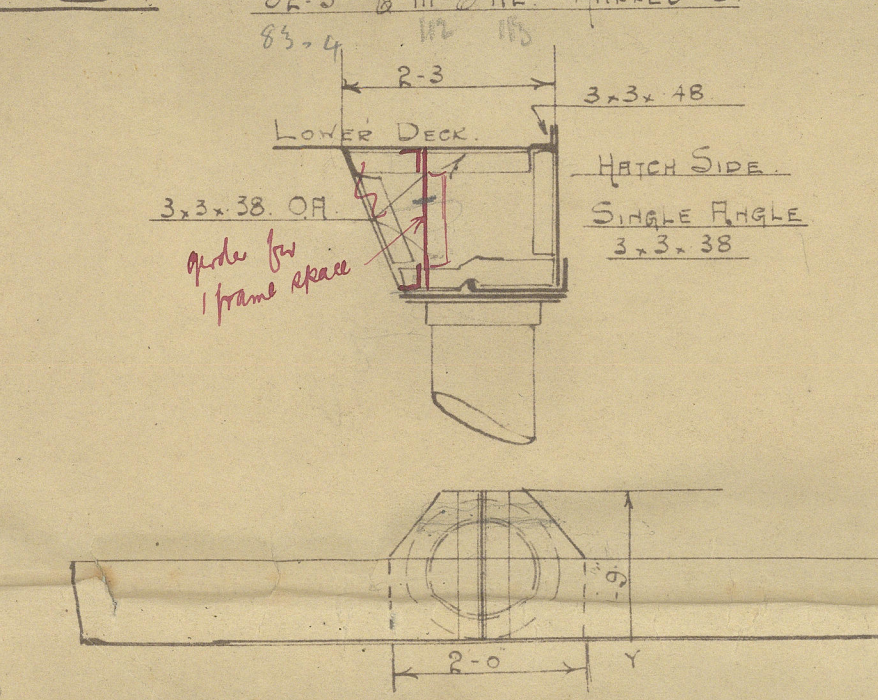

BULKHEAD FRAMES MARKED B TO RUN UP TO POOP & BRIDGE DECKS 1E EVERY THIRD


COMBINED POOP & BRIDGE DECK

BEAMS 1/2 x 3.0 to 3.4 to 5.8 x 3.4 AT END WHERE UNDER 6.0 & 8.0



UPPER DECK

BEAMS 1/2 x 3.0 to 3.4 EXCEPT WHERE OTHERWISE MARKED

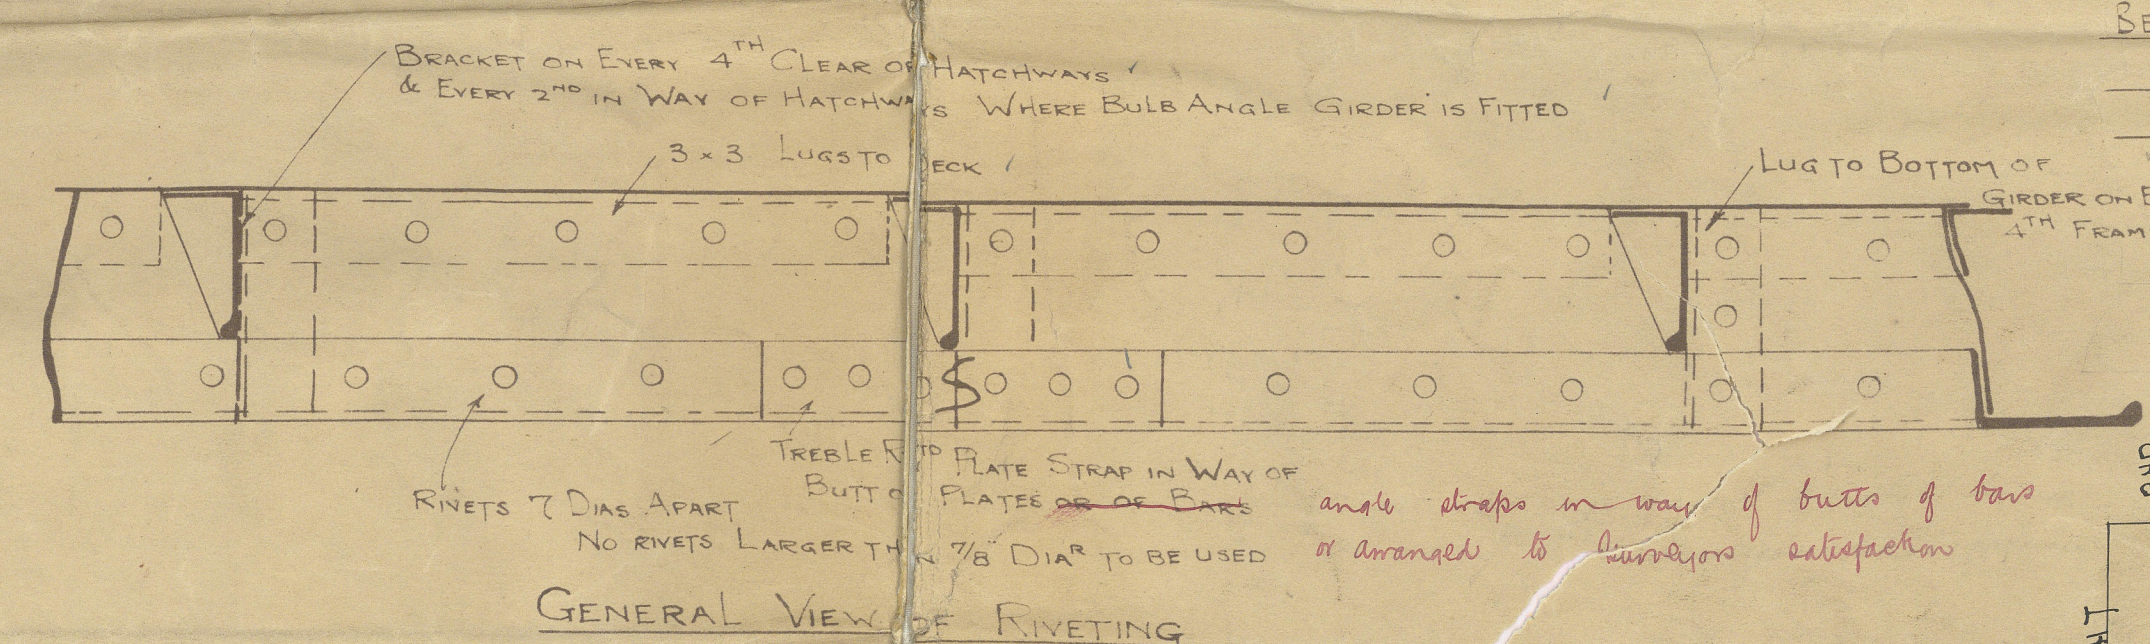

Messrs W HARRISS & SON LTD  
SHIPBUILDERS & REPAIRERS  
BURY ST EDMUNDS  
SUFFOLK

LOWER DECK

BEAMS 1/2 x 3.0 to 3.4 EXCEPT WHERE OTHERWISE MARKED

N° 204




19th May 1913



S. S. No 204

Profile & Deck Plans

SS "Valerian"  
Wab. Lpt 8560  
N.W. "Rothmans"

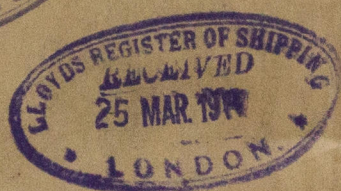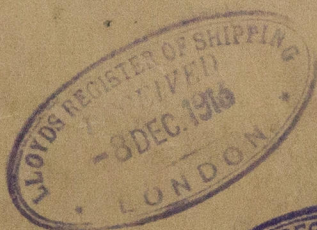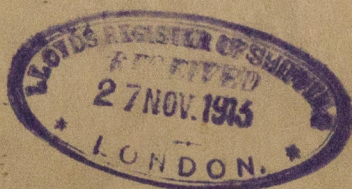

© 2019

W 228 - 0075

Lloyd's Register  
Foundation