


W228-0108

# S.S. "VOLVOVA PUTNIK"

Proposed Modification to the third (lowest) deck

Arrangement as at present in vessel

12 x 3 1/2 x 60 B +  
or equivalent  
Section showing stringer  
where no through beams  
are fitted

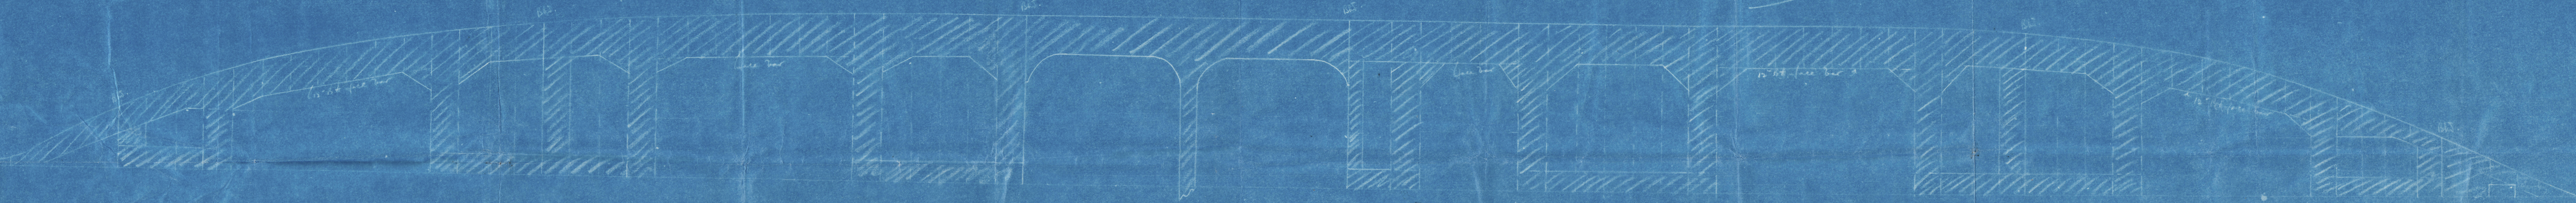


366  
3/1/24



Retain in office  
with papers

---

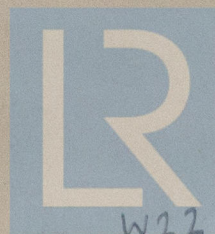

© 2019

Lloyd's Register  
Foundation

W228-0108