


off a/c

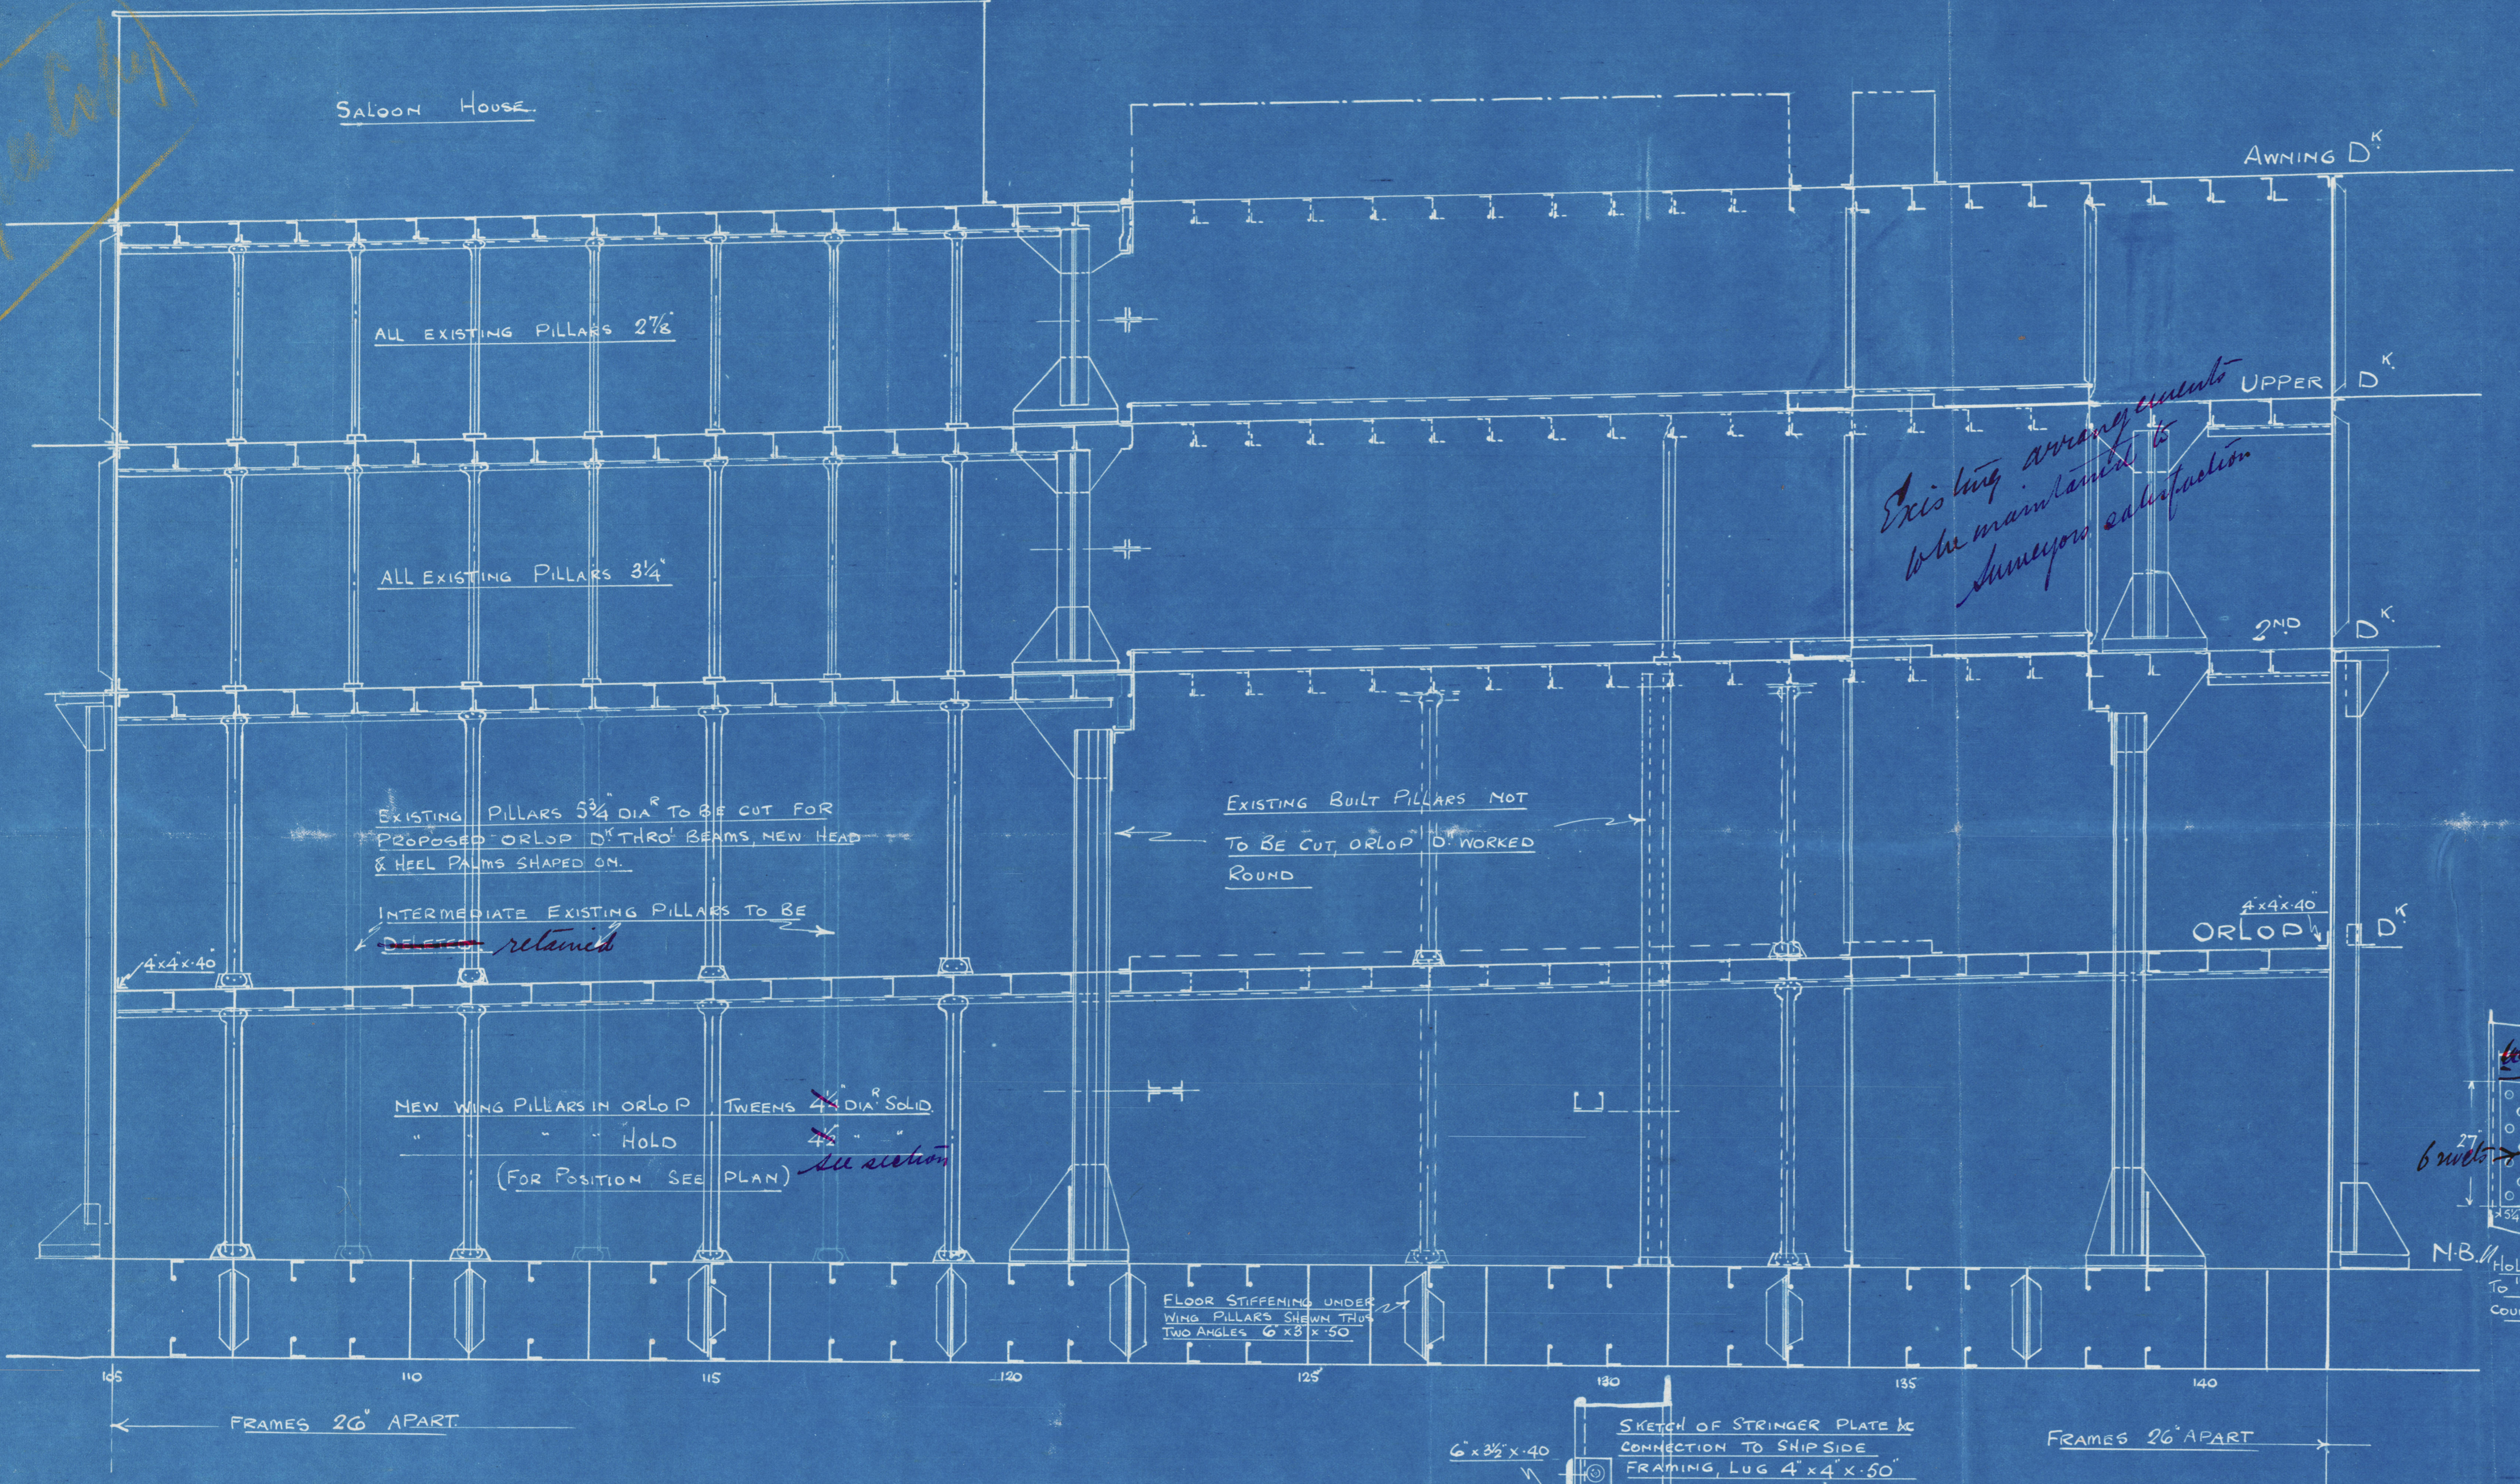

Existing arrangement to be maintained to improve satisfaction




SHIP'S FRAME GIRDER 10 x 3 1/2 x 46 BA.

6 rivets

ALL 7/8 RIVETS

KNEES KEPT WELL OUTBOARD TO GIVE AS LARGE INSULATED CAPACITY AS POSSIBLE

Holes in frames drilled to 7/16" for 7/8 RIVETS, KNEES COUNTERSUNK AS REQUIRED

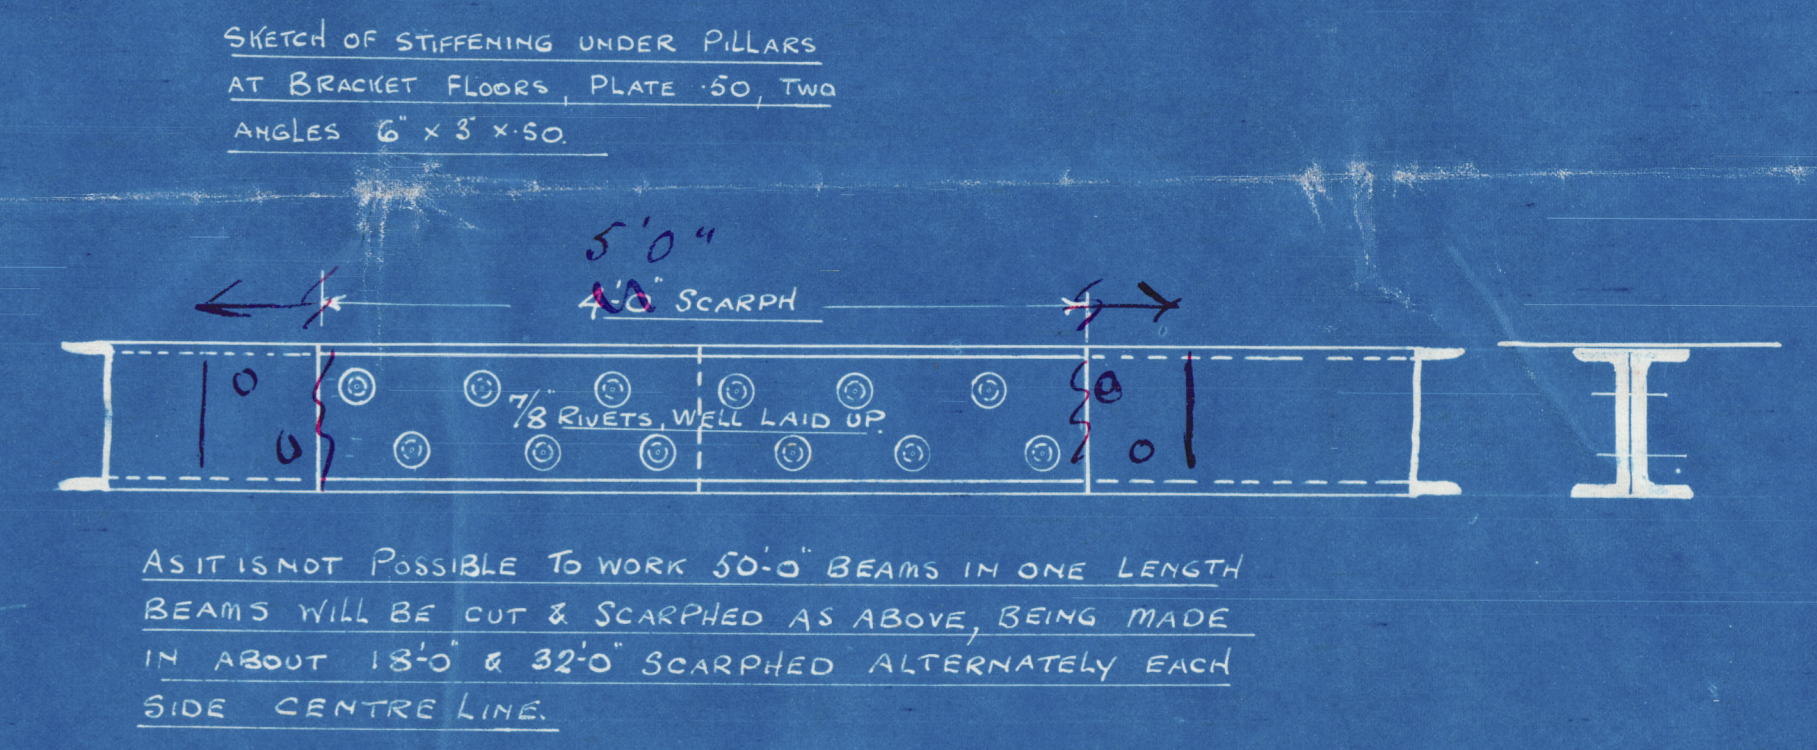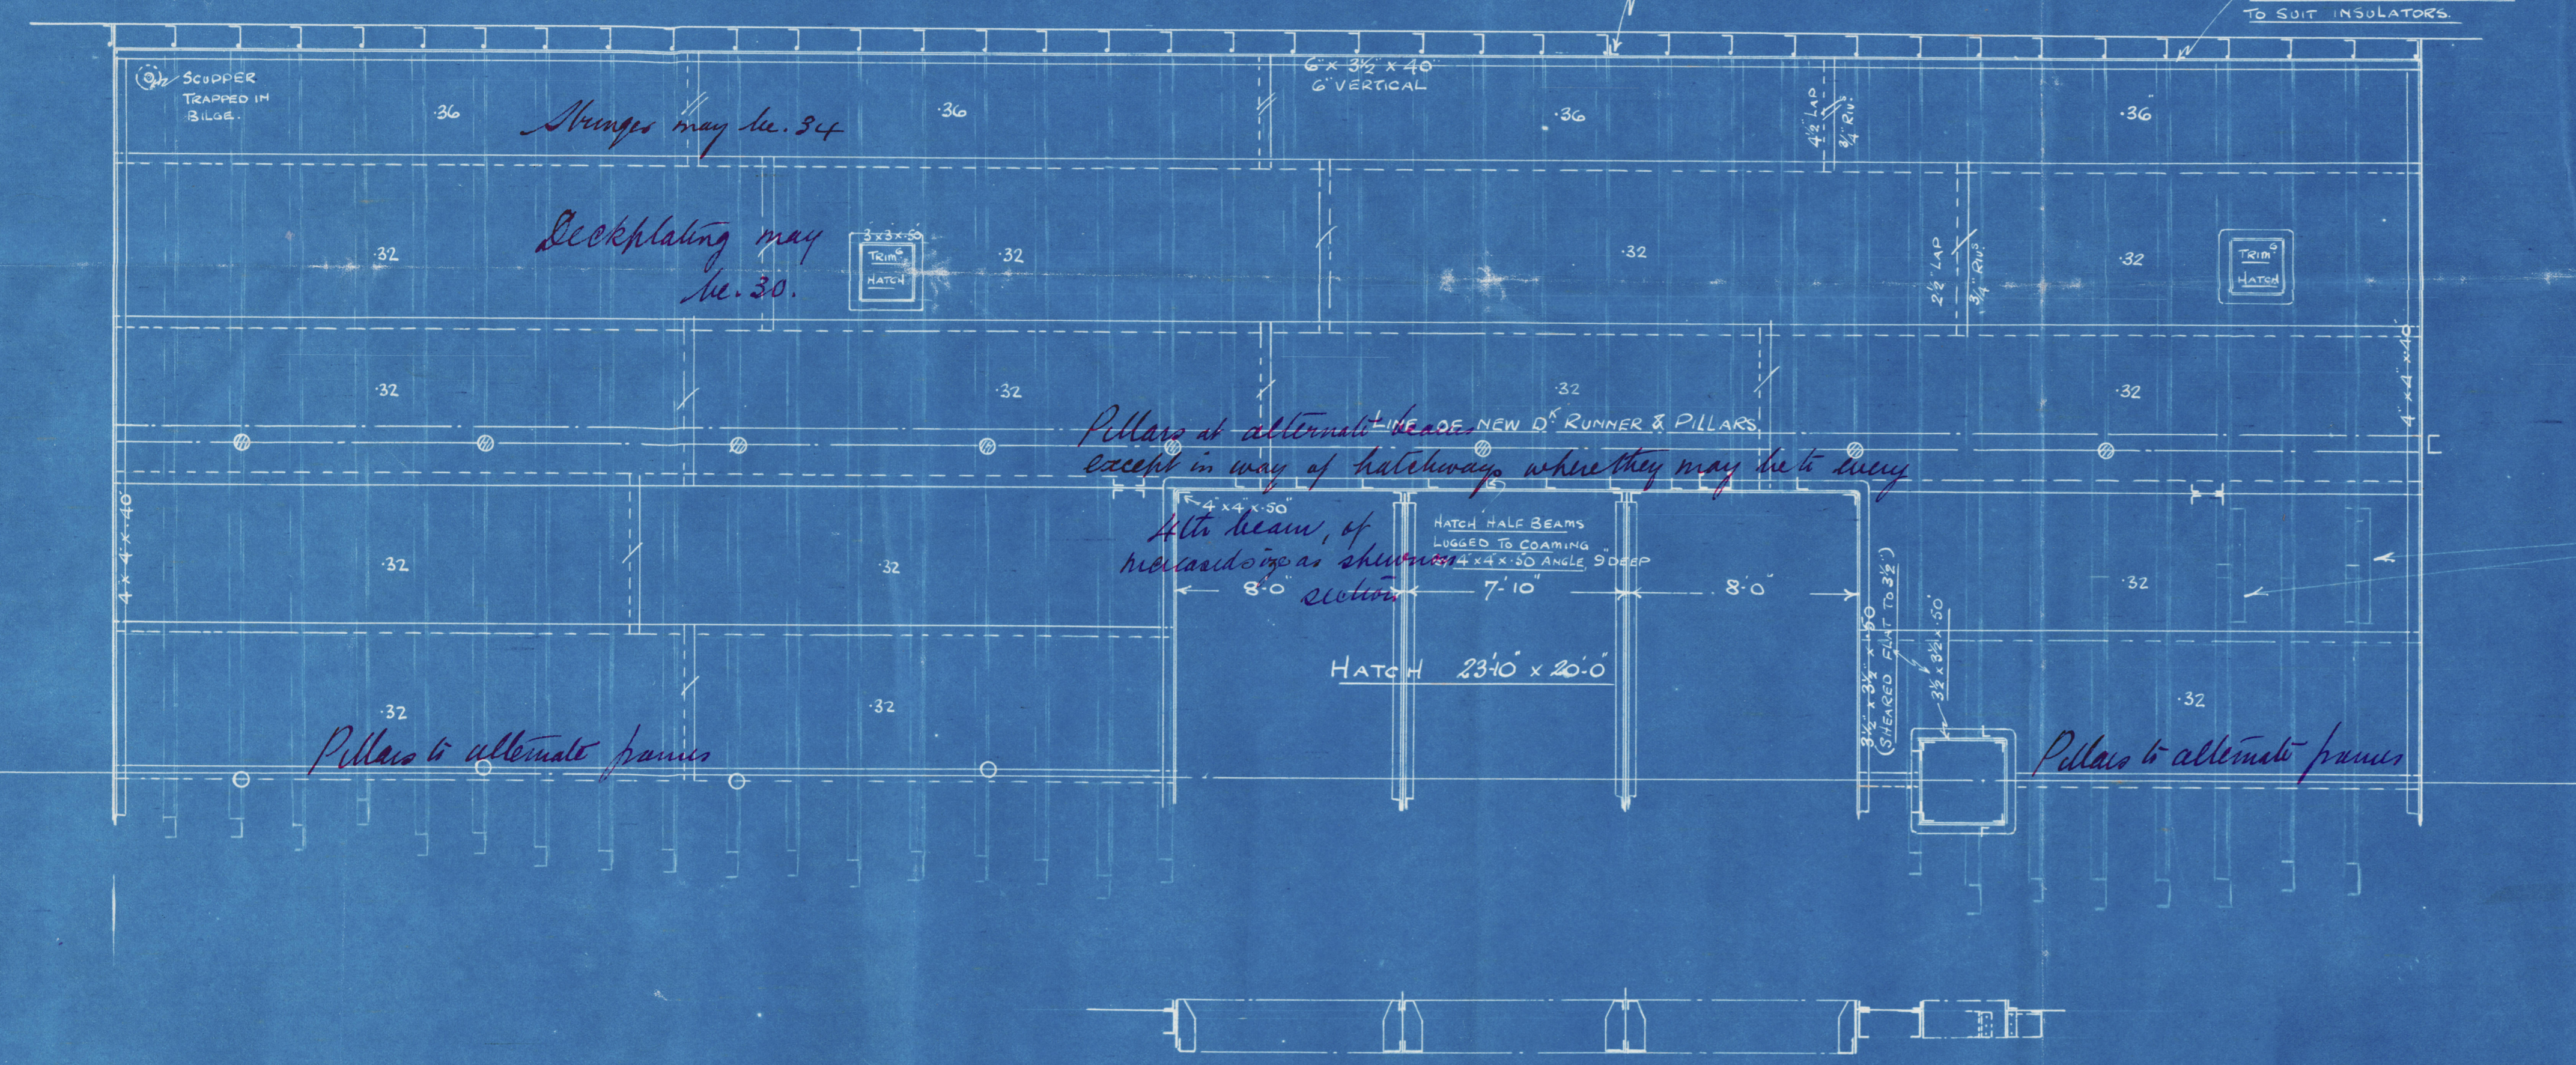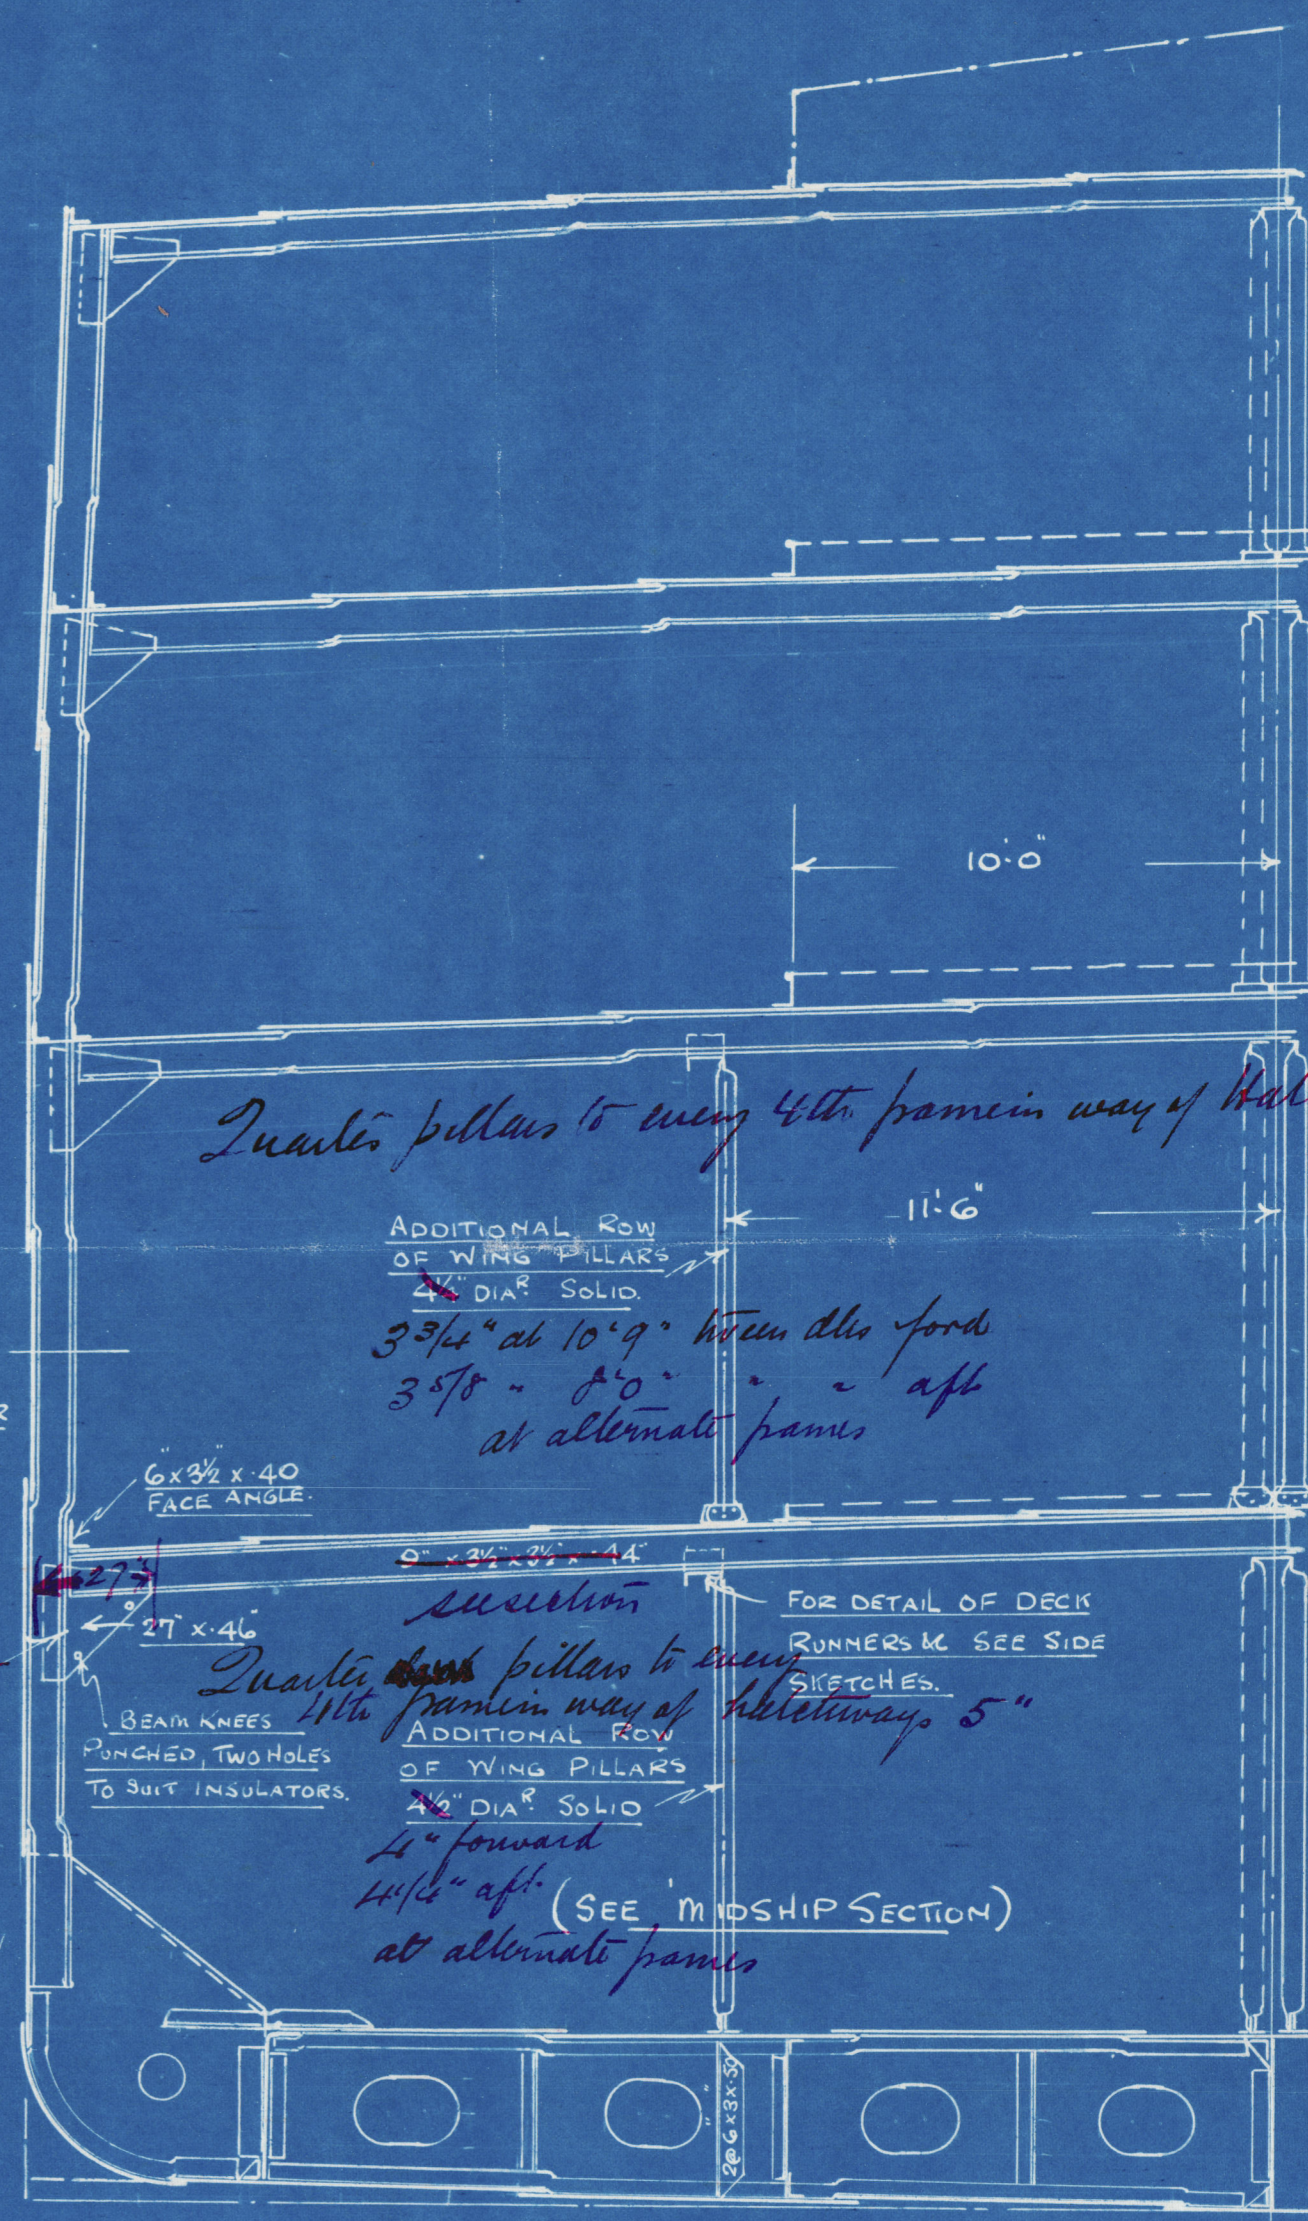

S/S. "VIKINGSTAR"
No 3 Hold

SKETCH SHOWING PROPOSED ORLOP DECK & PILLAR STRENGTHENING TO 2ND Dth FOR CARRIAGE OF CHILLED MEAT.

Scale 1/4" = 1 ft.

"
Vikingslar
"

Liv .86549.



© 2019

Lloyd's Register

W228 - OFS6 Foundation