

4910-623M

S/S. "VIKINGSTAR" (EX "LUSIADA")
BUILT BY MESSRS NAPIER & MILLER, OLD KILPATRICK 1920


400' B.P. x 52' 0" x 31' 0" mld.

SKETCH SHEWING MIDSHIP SECTION WITH PROPOSED
ORLOP DECK.

ORLOP DECK 10' 9" B.T.B. IN NOS 1 & 2 HOLDS

8' 0" " " 384 "

1-11-23

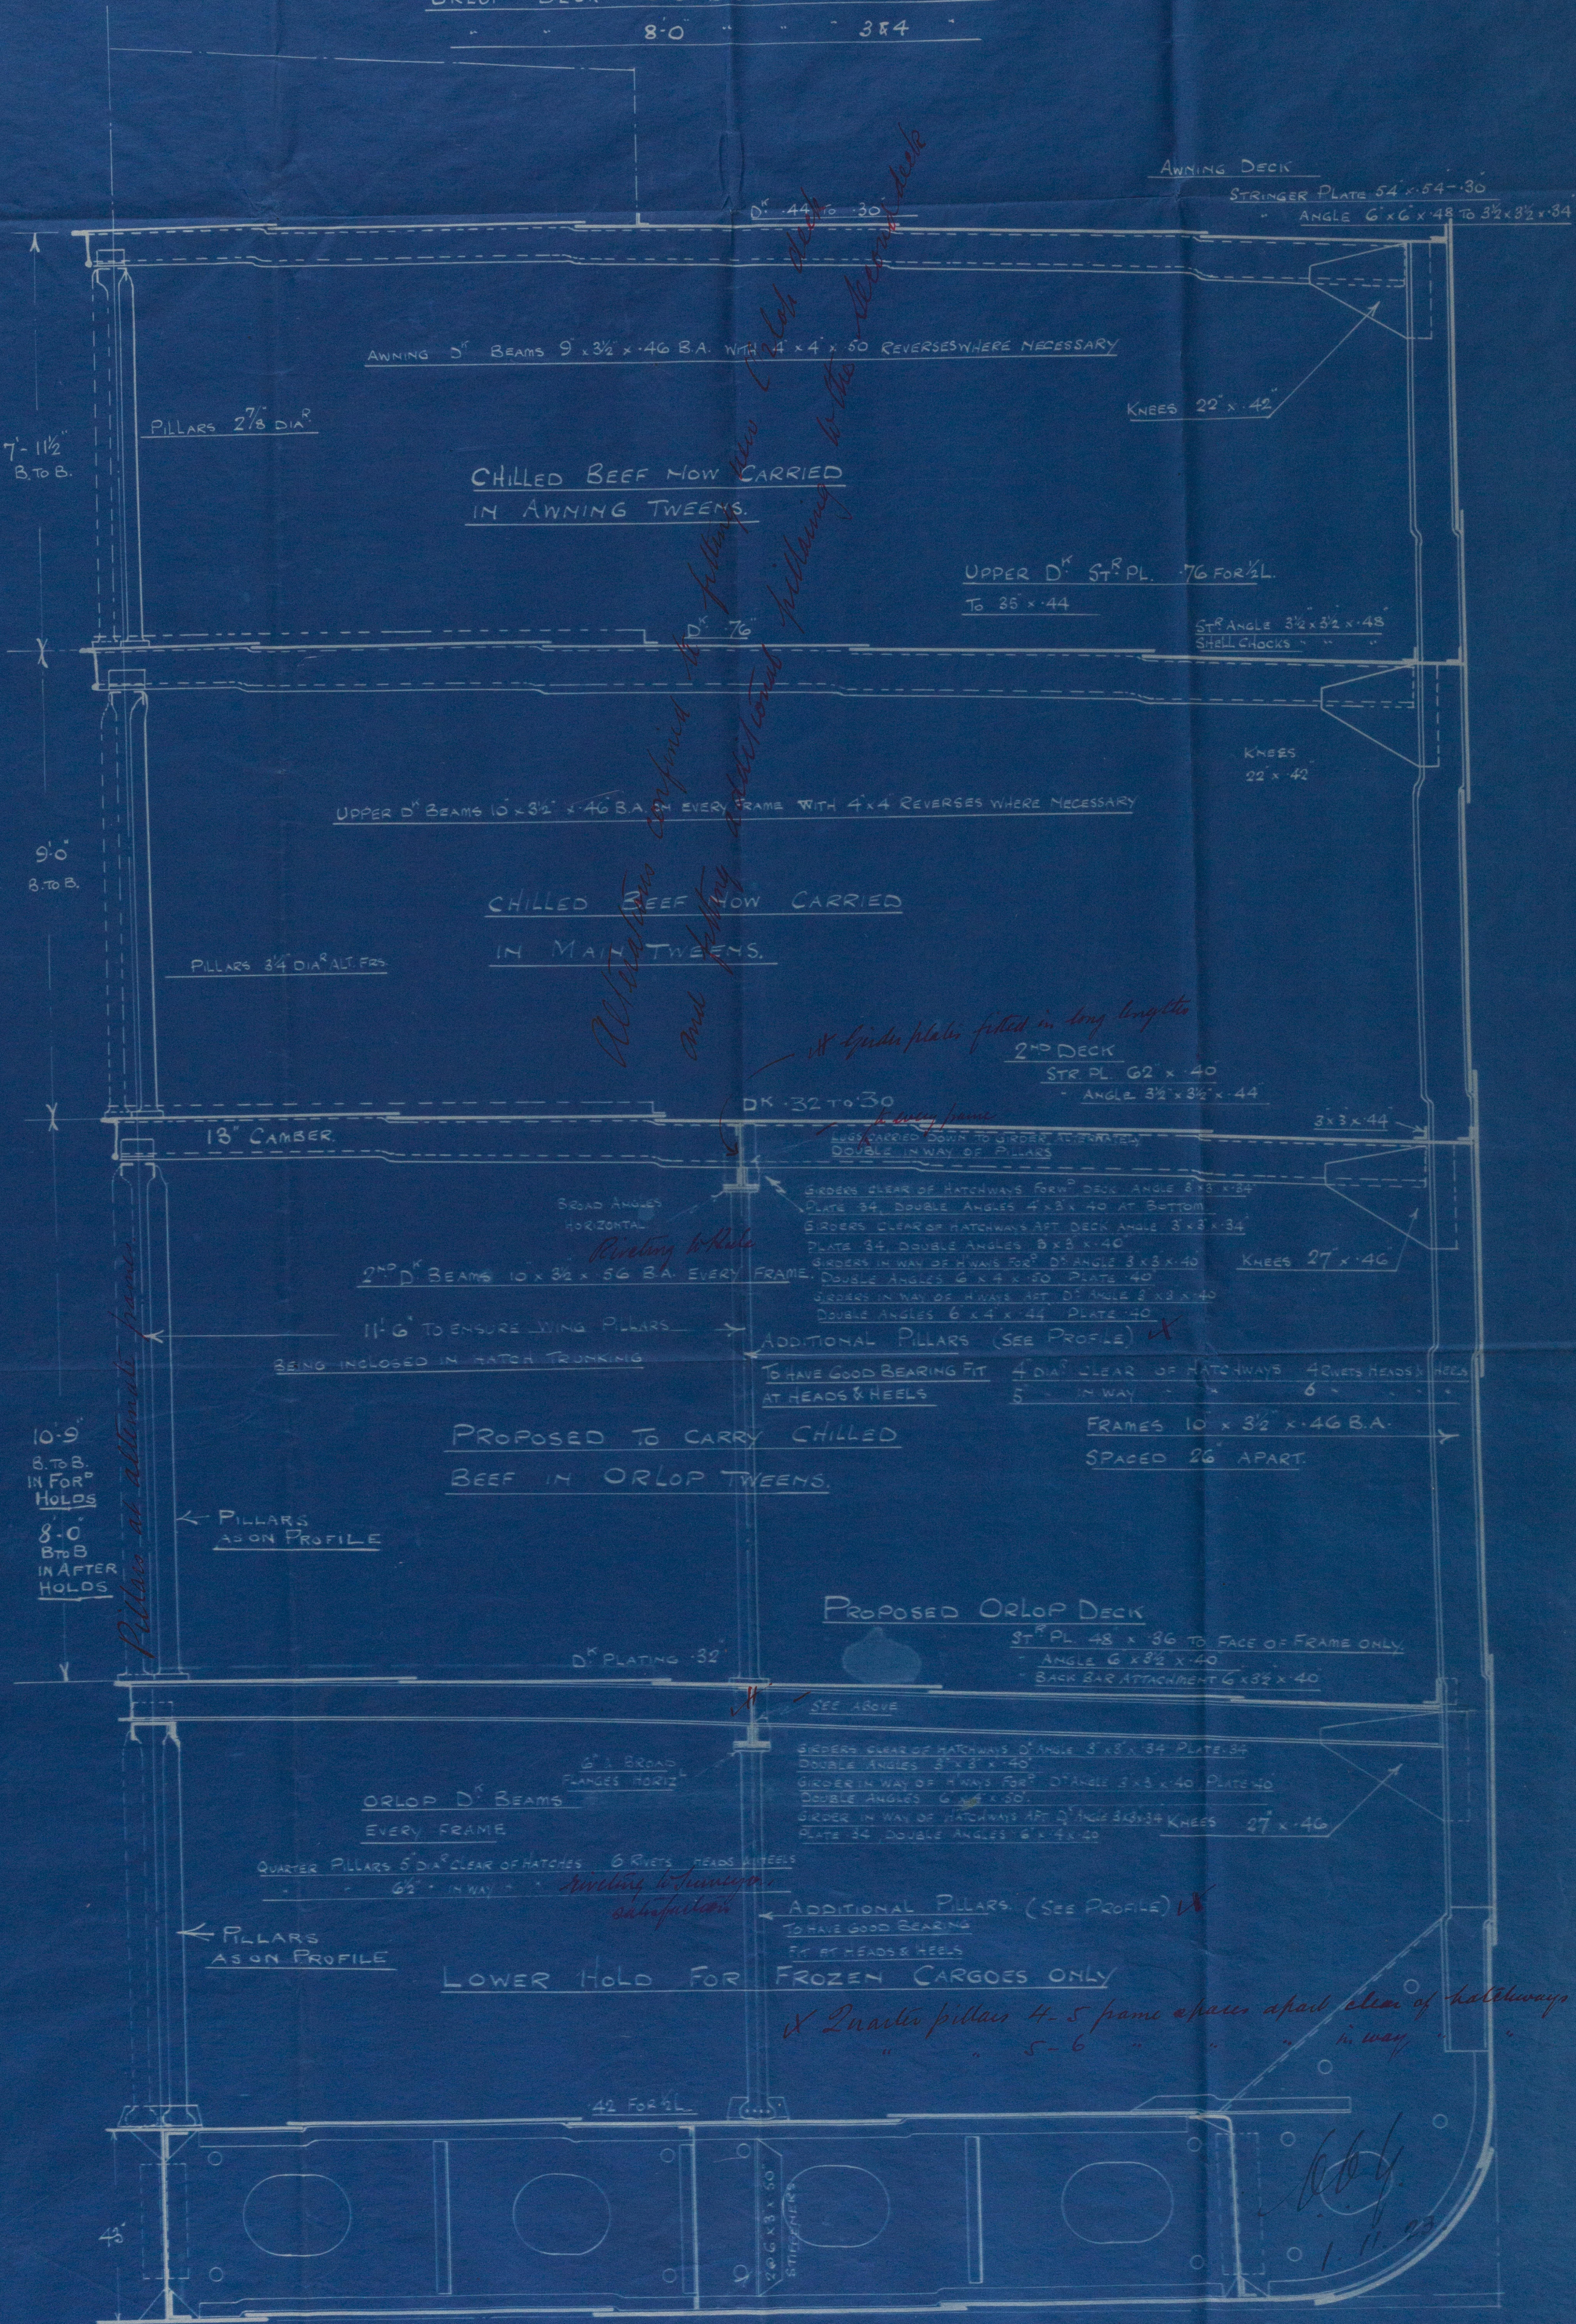

Attention required to fitting new 1" dia. plate filling in the 1" dia. hole

4" dia. plate fitted in long lengths

Pillar at alternate frame

Resting whole

Arranging to hammer

*2 quarter pillars 4-5 frame spaces apart clear of hatchways
" " 5-6 " " " " " " " "*

Midship Section

S. S. *Vikingofar*

LIVERPOOL

Report No. *86549.*



© 2019

Lloyd's Register
Foundation

W228 - 0164