

S.S. N° 174. PROFILE & DECK PLANS.




SCALE 1/8" = 1'-0"

8/8/24 TYPE: SHORT POOP AFT QUARTERDECK, BRIDGE AND FORECASTLE

LENGTH INSIDE STEM AND STERNPOST - 243'-0"
 LLOYDS LENGTH - 249'-8"
 BREADTH MOULDED - 38'-0"
 DEPTH MOULDED TO MAINDECK - 17'-6"
 QUARTERDECK - 21'-6"
 BRIDGEDECK - 24'-6"


CLASS: LLOYDS' 100 A.1.

ALL THICKNESSES IN 100 TNS

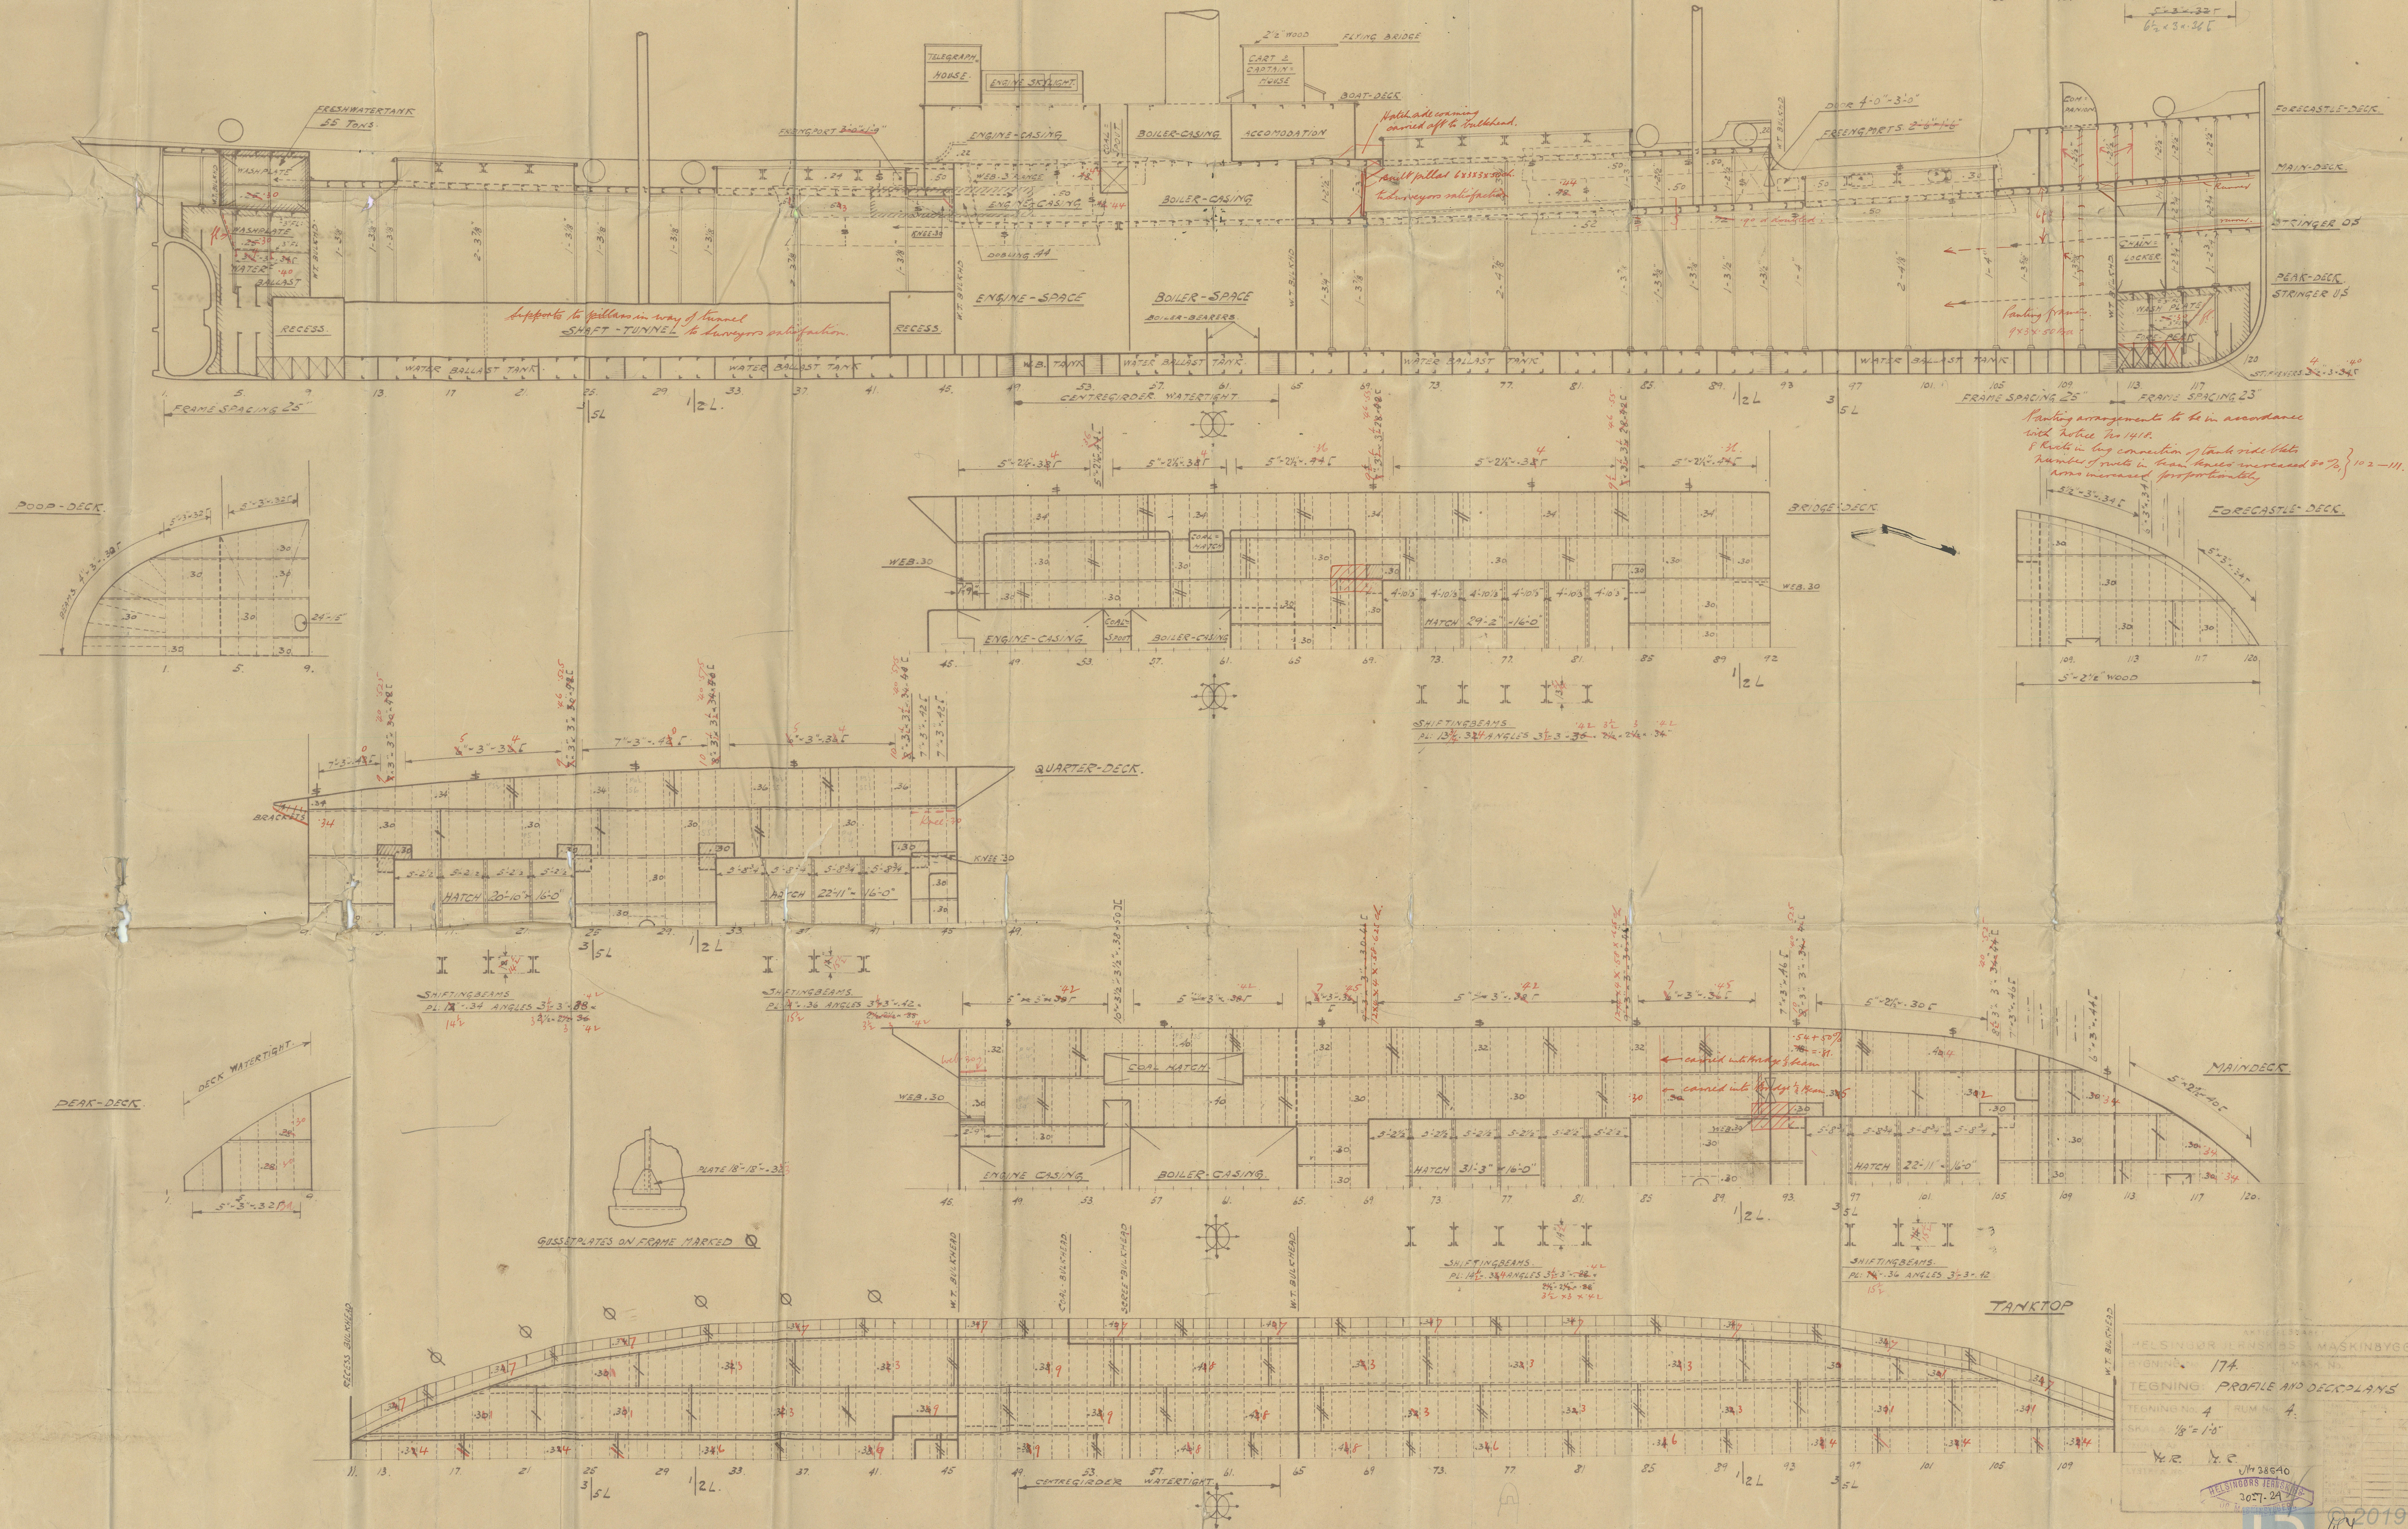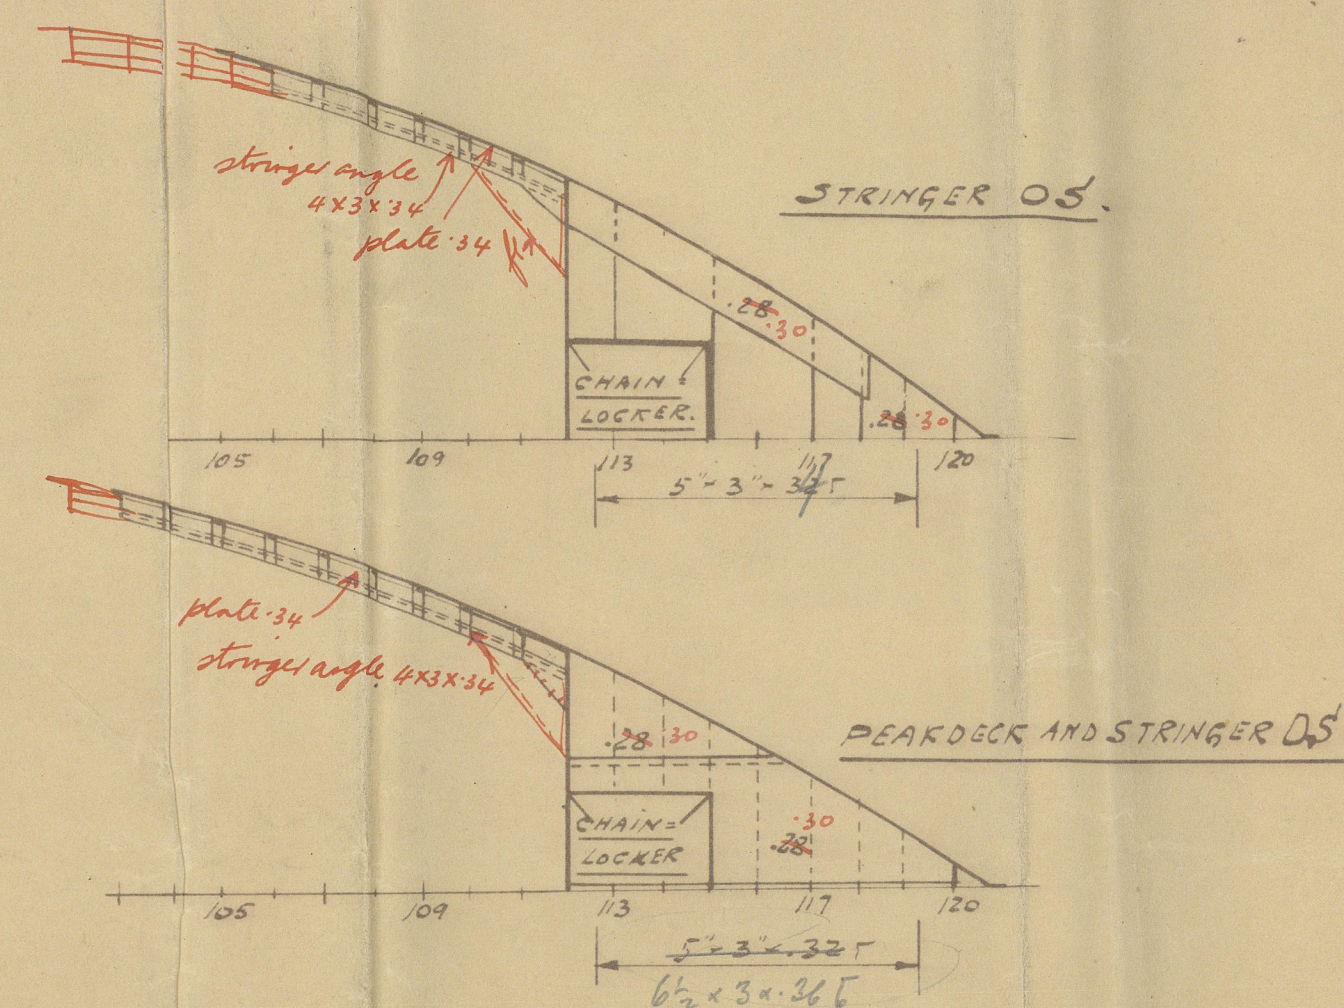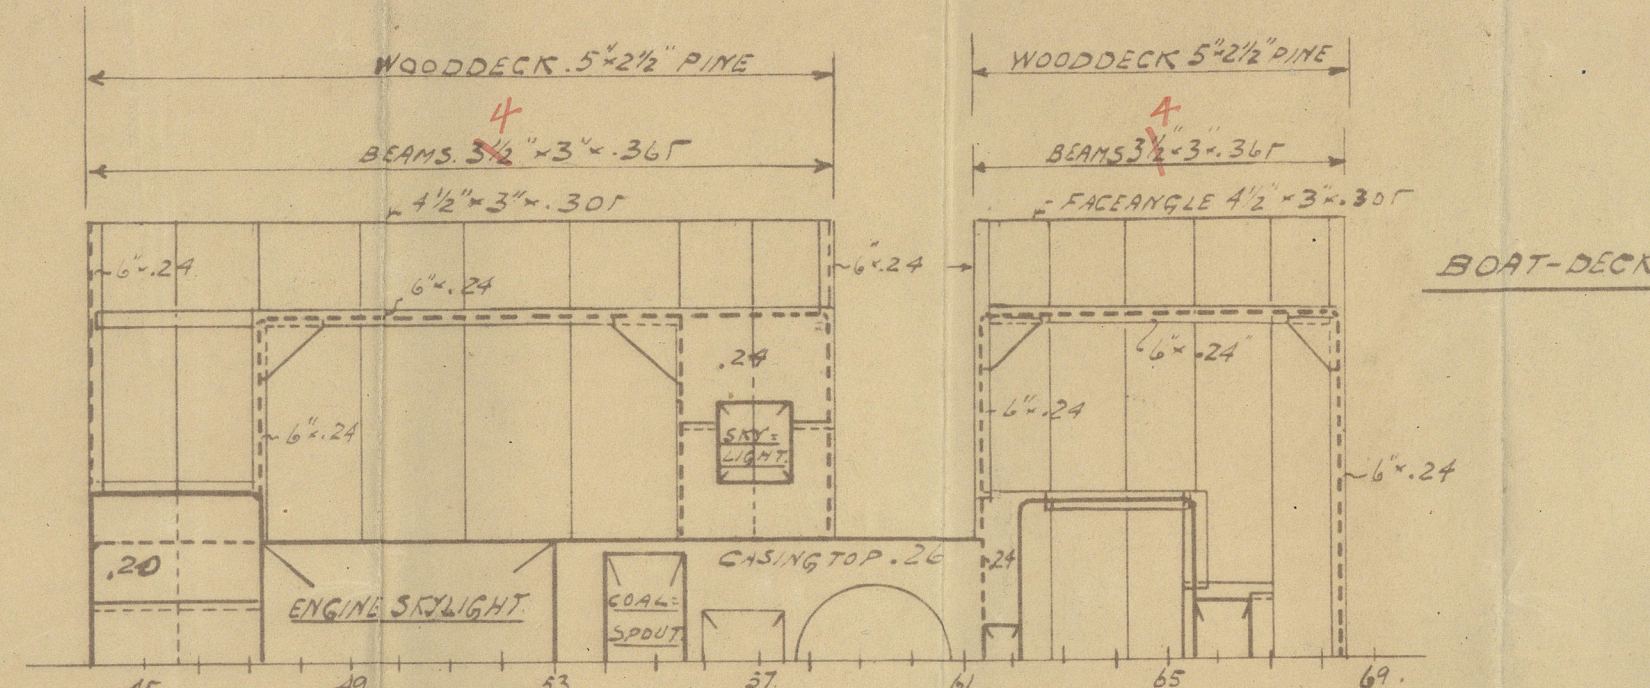

Painting arrangements to be in accordance with Rules No. 1411.
 8 knots in big connection of tank side plate
 Number of rivets in tank lines increased 80% } 102-111.
 Area increased proportionally

307-24	

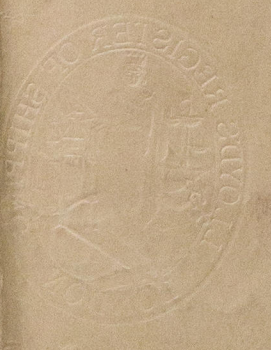

W 229-0127

3919

HELSINGØRS JERNSKIBS
OG MASKINBYGGERI
Nº 174
PROFILE & DECK PLANS.



1/2 Aaro" of Elsinore.
Gen. Rpt. No. 7120

4



2985
1798
1799