

STEEL BOILER 9'-6" DIAM. BY 9'-6" LONG LLOYDS SURVEY 100 LBS. W.P.


FOR MESSRS CRAIG TAYLOR & CO STOCKTON-ON-TEES S.S.N. 109.

3511

SCALE 1" = 1 FT.

3511

26/4/05
A.S. Wiley

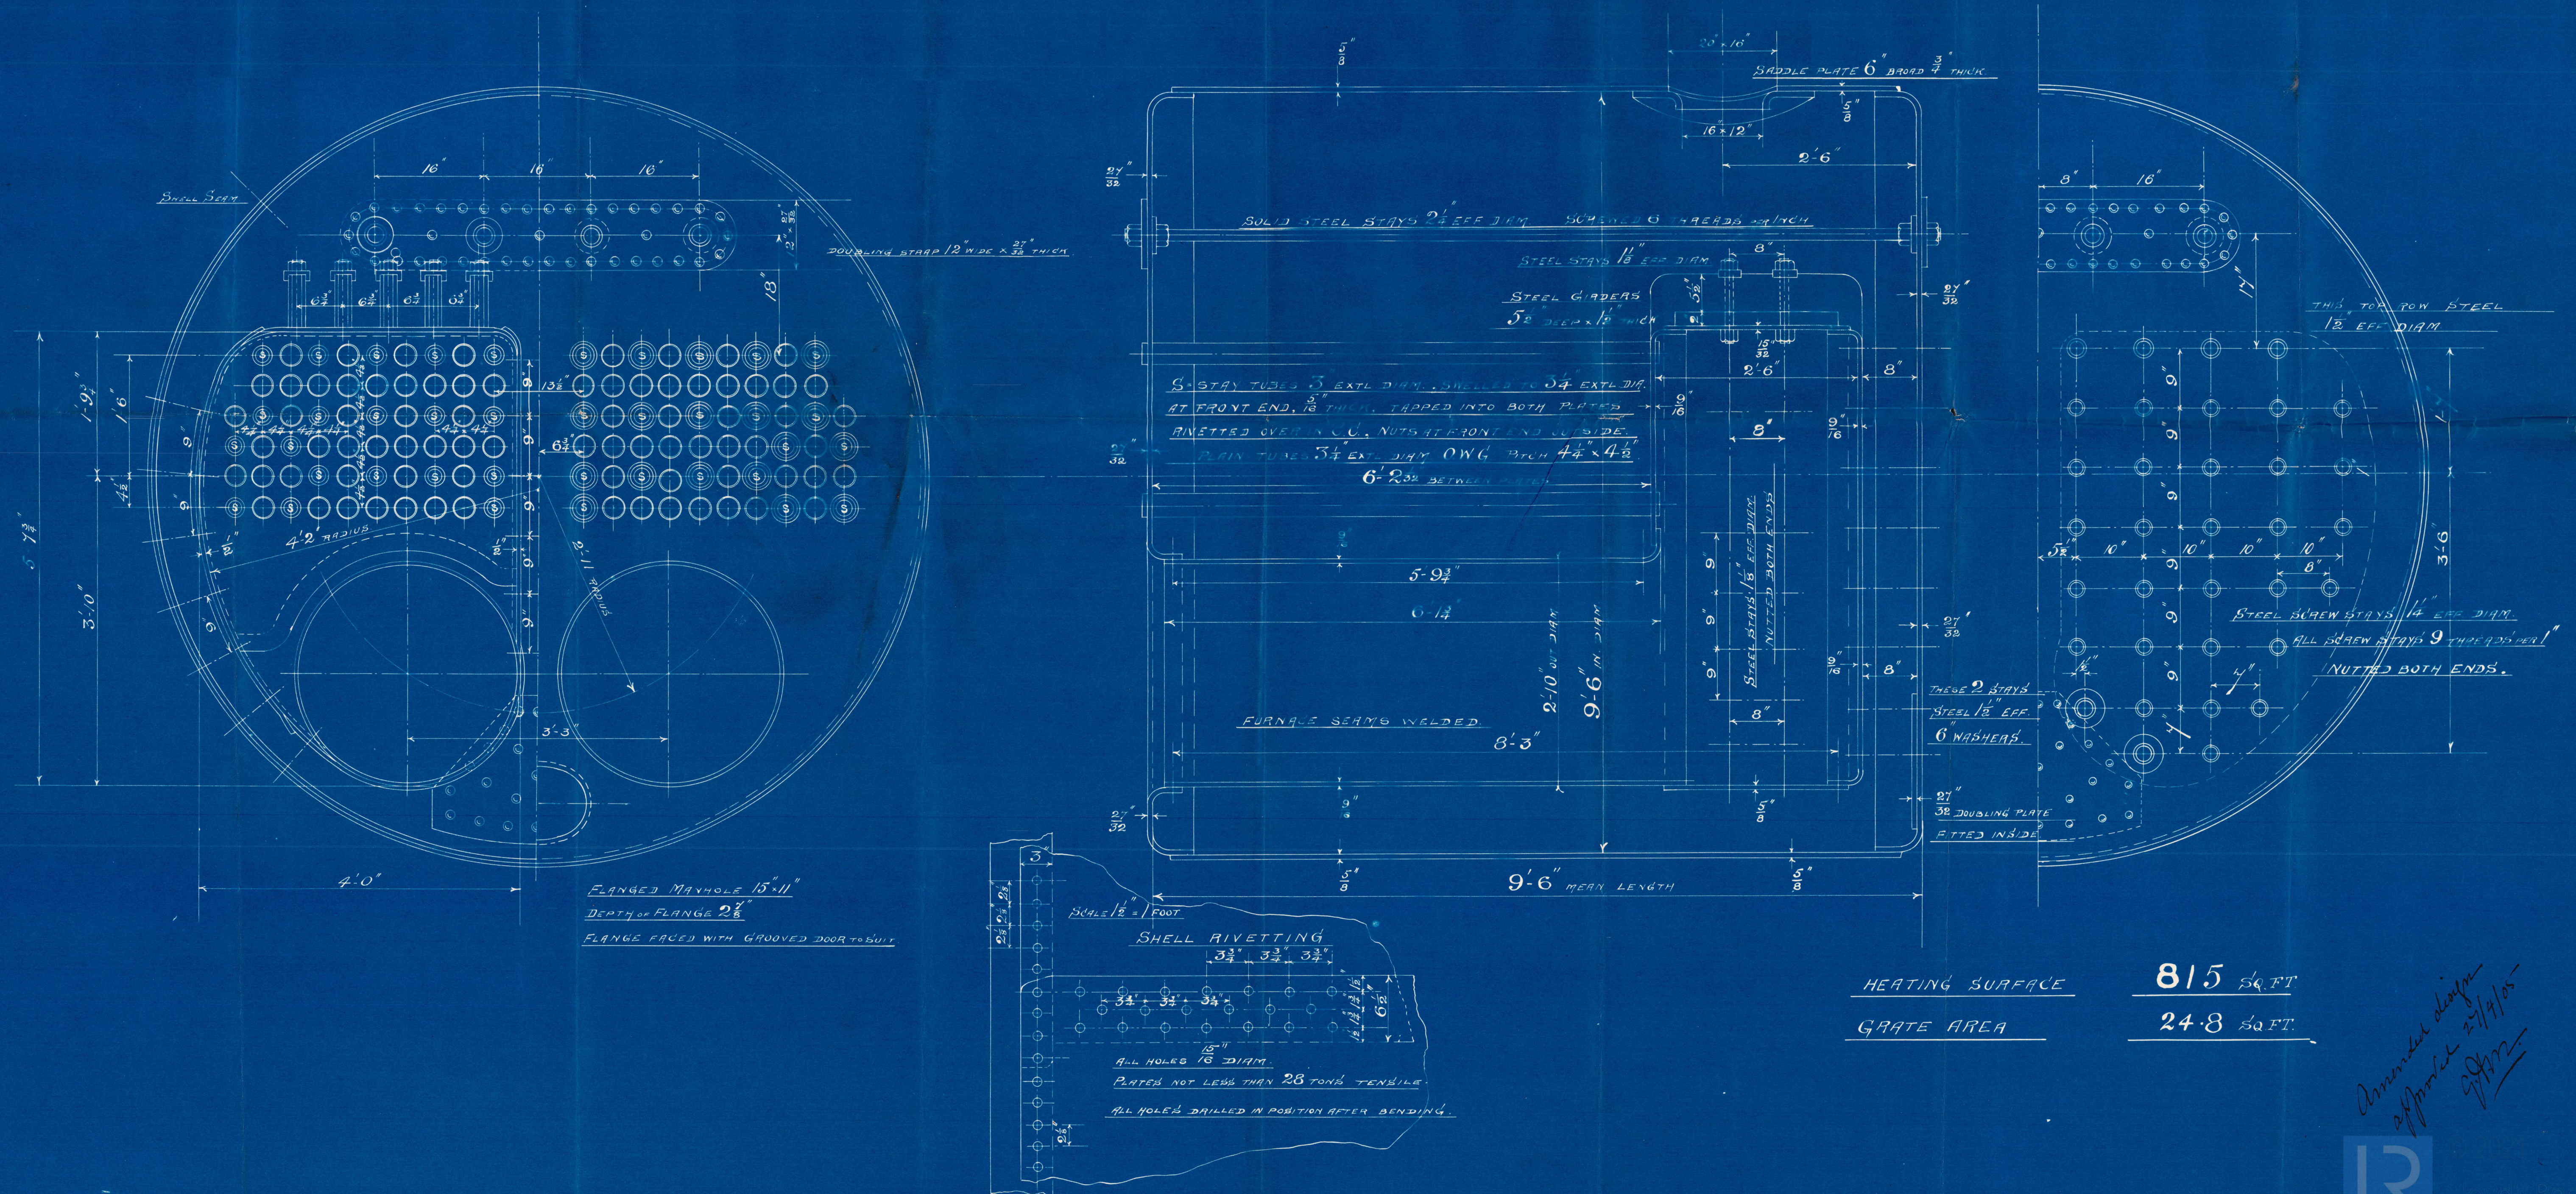

Biley Bros
No 3511

Amended plan

for
Cory Taylor & Co. No 109

Donkey Boiler

S S "Ballochmyle"

Indt report No. 4143

n.v. "Aghies Spyridon"

No. 3457
LLOYD'S TEST.
200 lbs.
4 a.m.
30-11-05

20 plates

W232-0077



© 2021

Lloyd's Register
Foundation