


DOXFORD & SONS
PROPOSED INTER-ST +
PROPELLER SHAFTS

FOR CONTRACT
578 OE

app^d 17.1.23
Braganza
ex y
"Pacific Trader".

SUNDERLAND RPT. NO. 28810

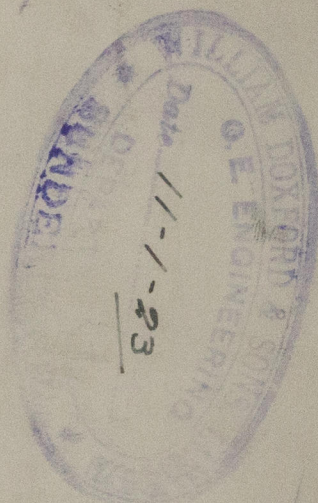

© 2019

Lloyd's Register
Foundation

W234-0081