


THUS FOR EACH ORDER NUMBER.

CHECKED BY 10/8.
DATE 23/12/1926.
TIME CHARGED TO Nº 1.

PLATES	STEEL
RIVETS	"
STAYS	"
TUBES	IRON.

WORKING PRESSURE	120 LBS/IN ²
TEST PRESSURE	230 LBS/IN ²

PLATE	=	82%
RIVET	=	83.2%

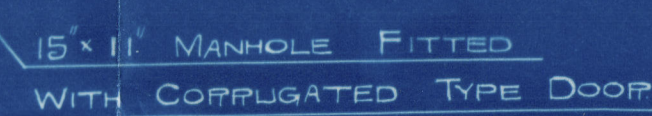

WALLSEND-SLIPWAY CO.

8⁴3 & 8⁴4.

ARMSTRONG WHITWORTH

1025-6.

PONKEY BLR

1 OFF.

W. P. 120 LBS.

S.S. British Endeavour.

NEWCASTLE ON TYNE


Report No. 81948.

S. S. BRITISH PROGRESS

NEWCASTLE ON TYNE.

Report No. 82006.

W234 - 69 2019

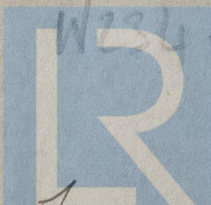

AMENDED

PLAN.

Lloyd's Register
Foundation