


20.6734

SS CITY OF VENICE
MODIFICATION TO AFTER WELL
SCALE 1/4" = ONE FT

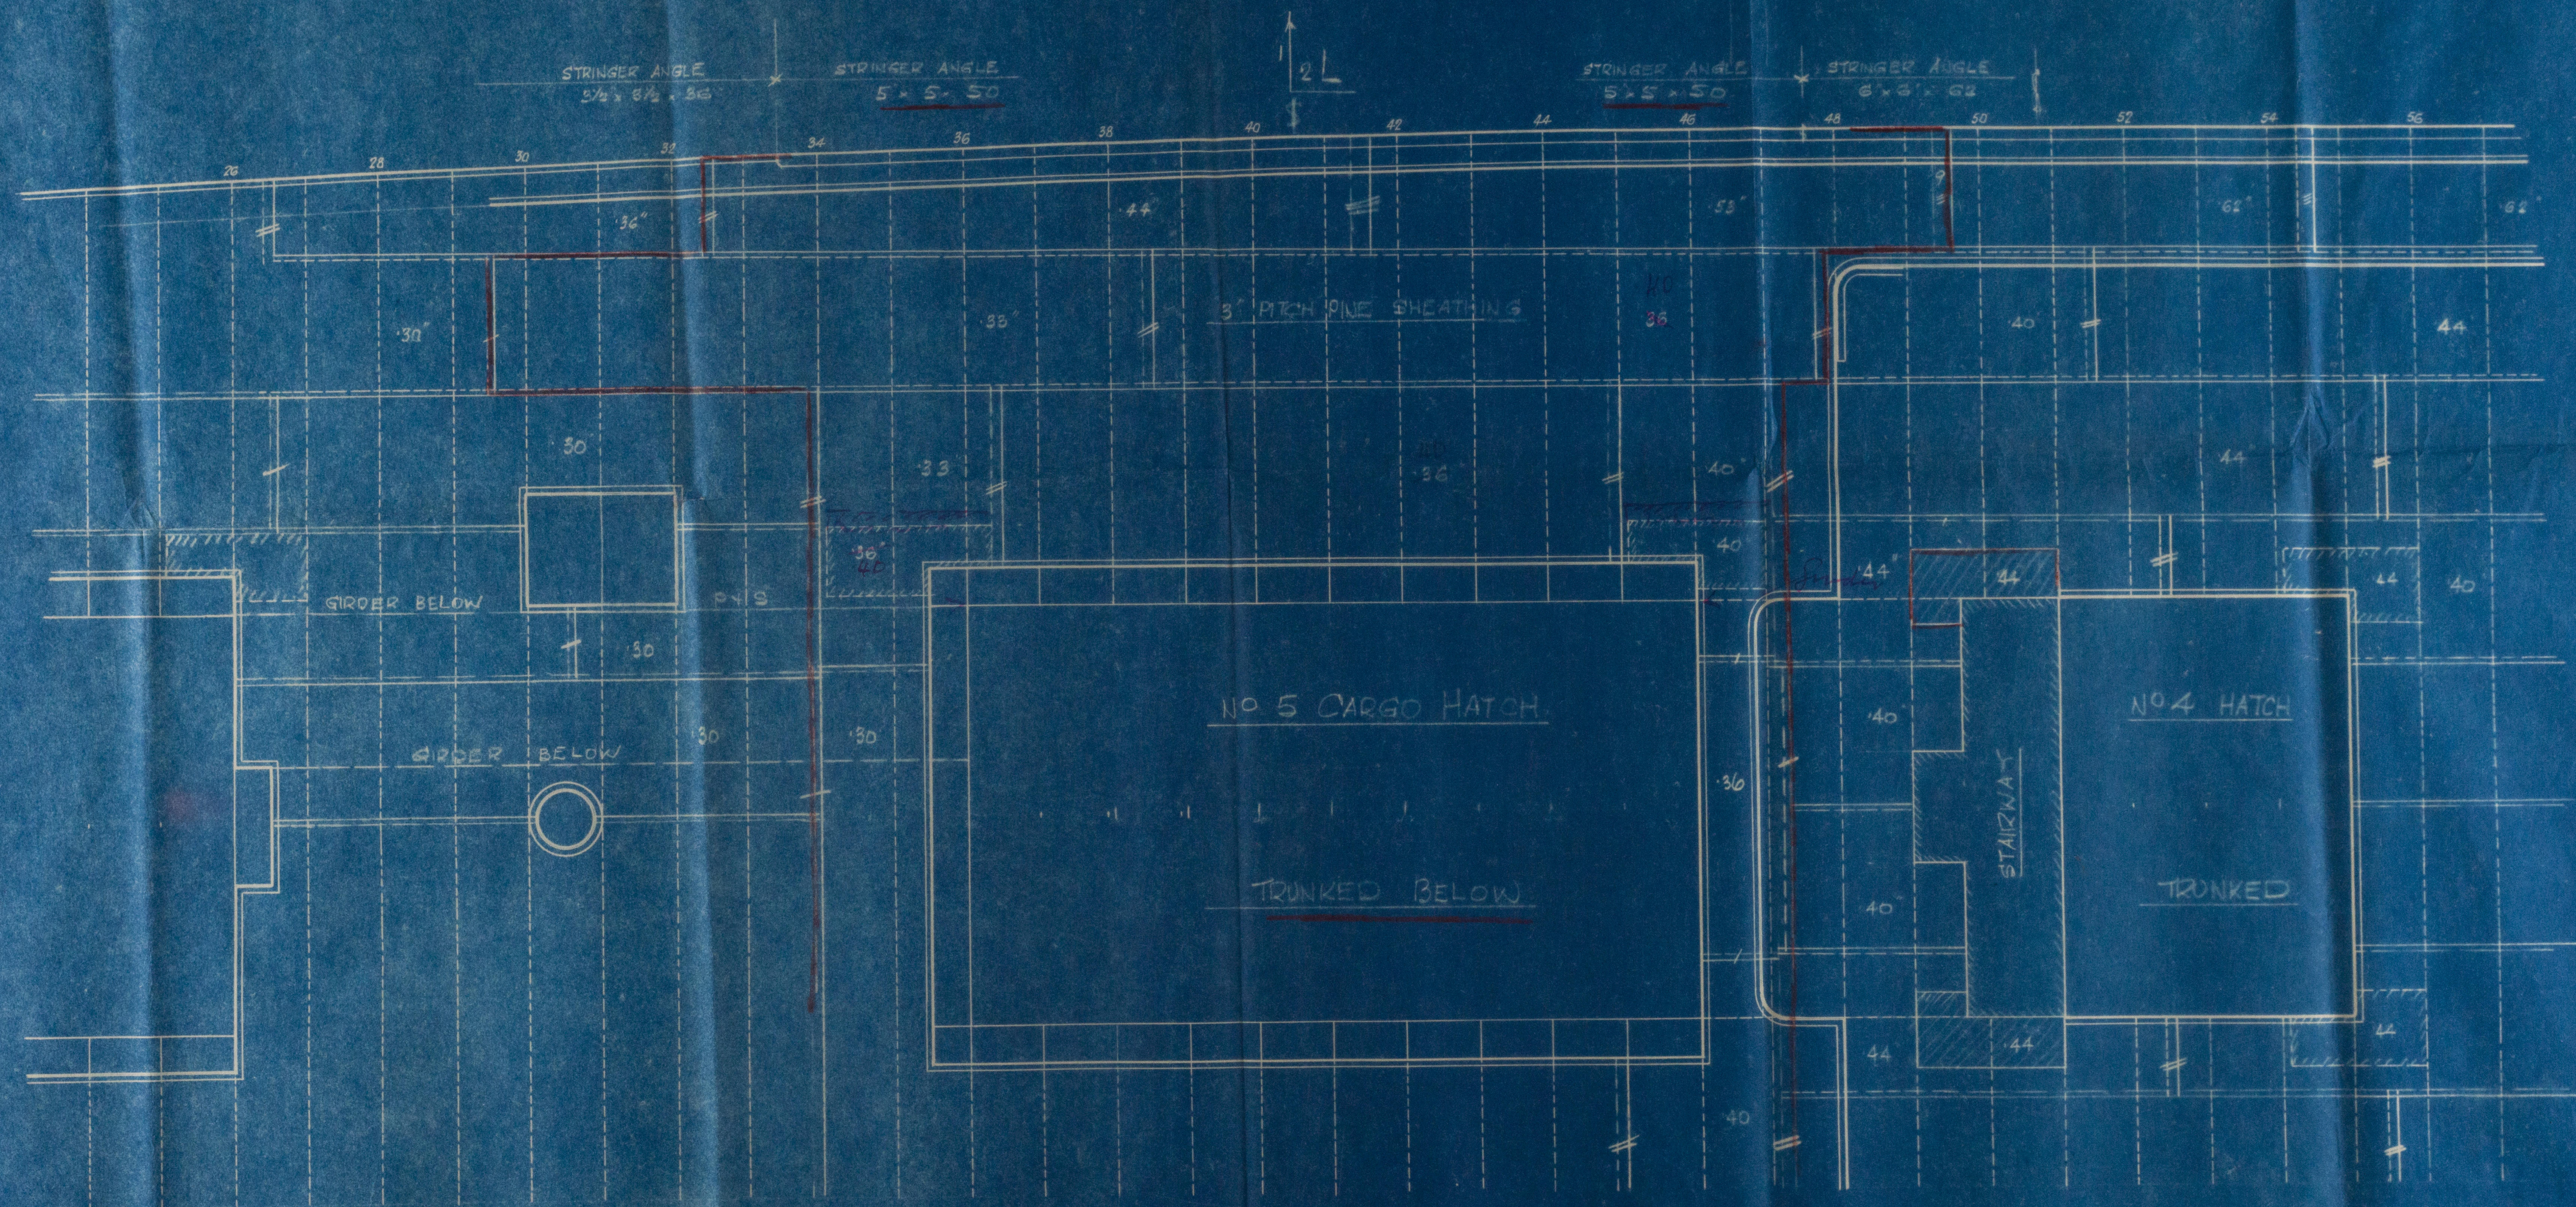

BEAMS
6 x 3 x 3 x 40/475 CH

BEAMS
6 x 3 x 3 x 40/475 CH

BEAMS 7 x 3 x 3 x 52/475 CHANNELS

BEAMS 8 x 3 x 3 x 38/50 CH

WORKMAN CLARK
SHIPBUILDERS
10 JUN 1934

LR

City of Venice

Del. rept. No. 11377.

Modifications at After well.

Shell and frame

Plan at Superstructure Deck.



© 2020

Lloyd's Register
Foundation

W236-0021