



*Handwritten signature*

SS CITY OF VENICE  
MODIFICATION TO AFTER WELL  
SCALE 1/4" = ONE FT

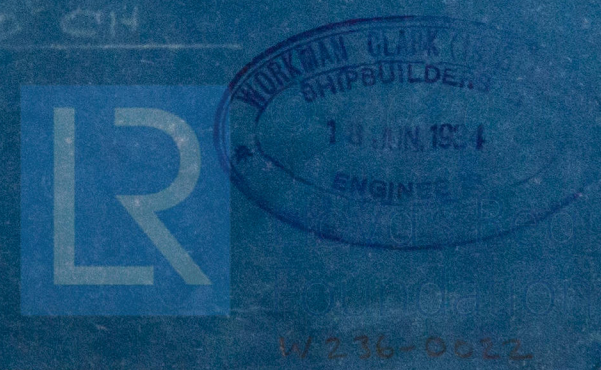

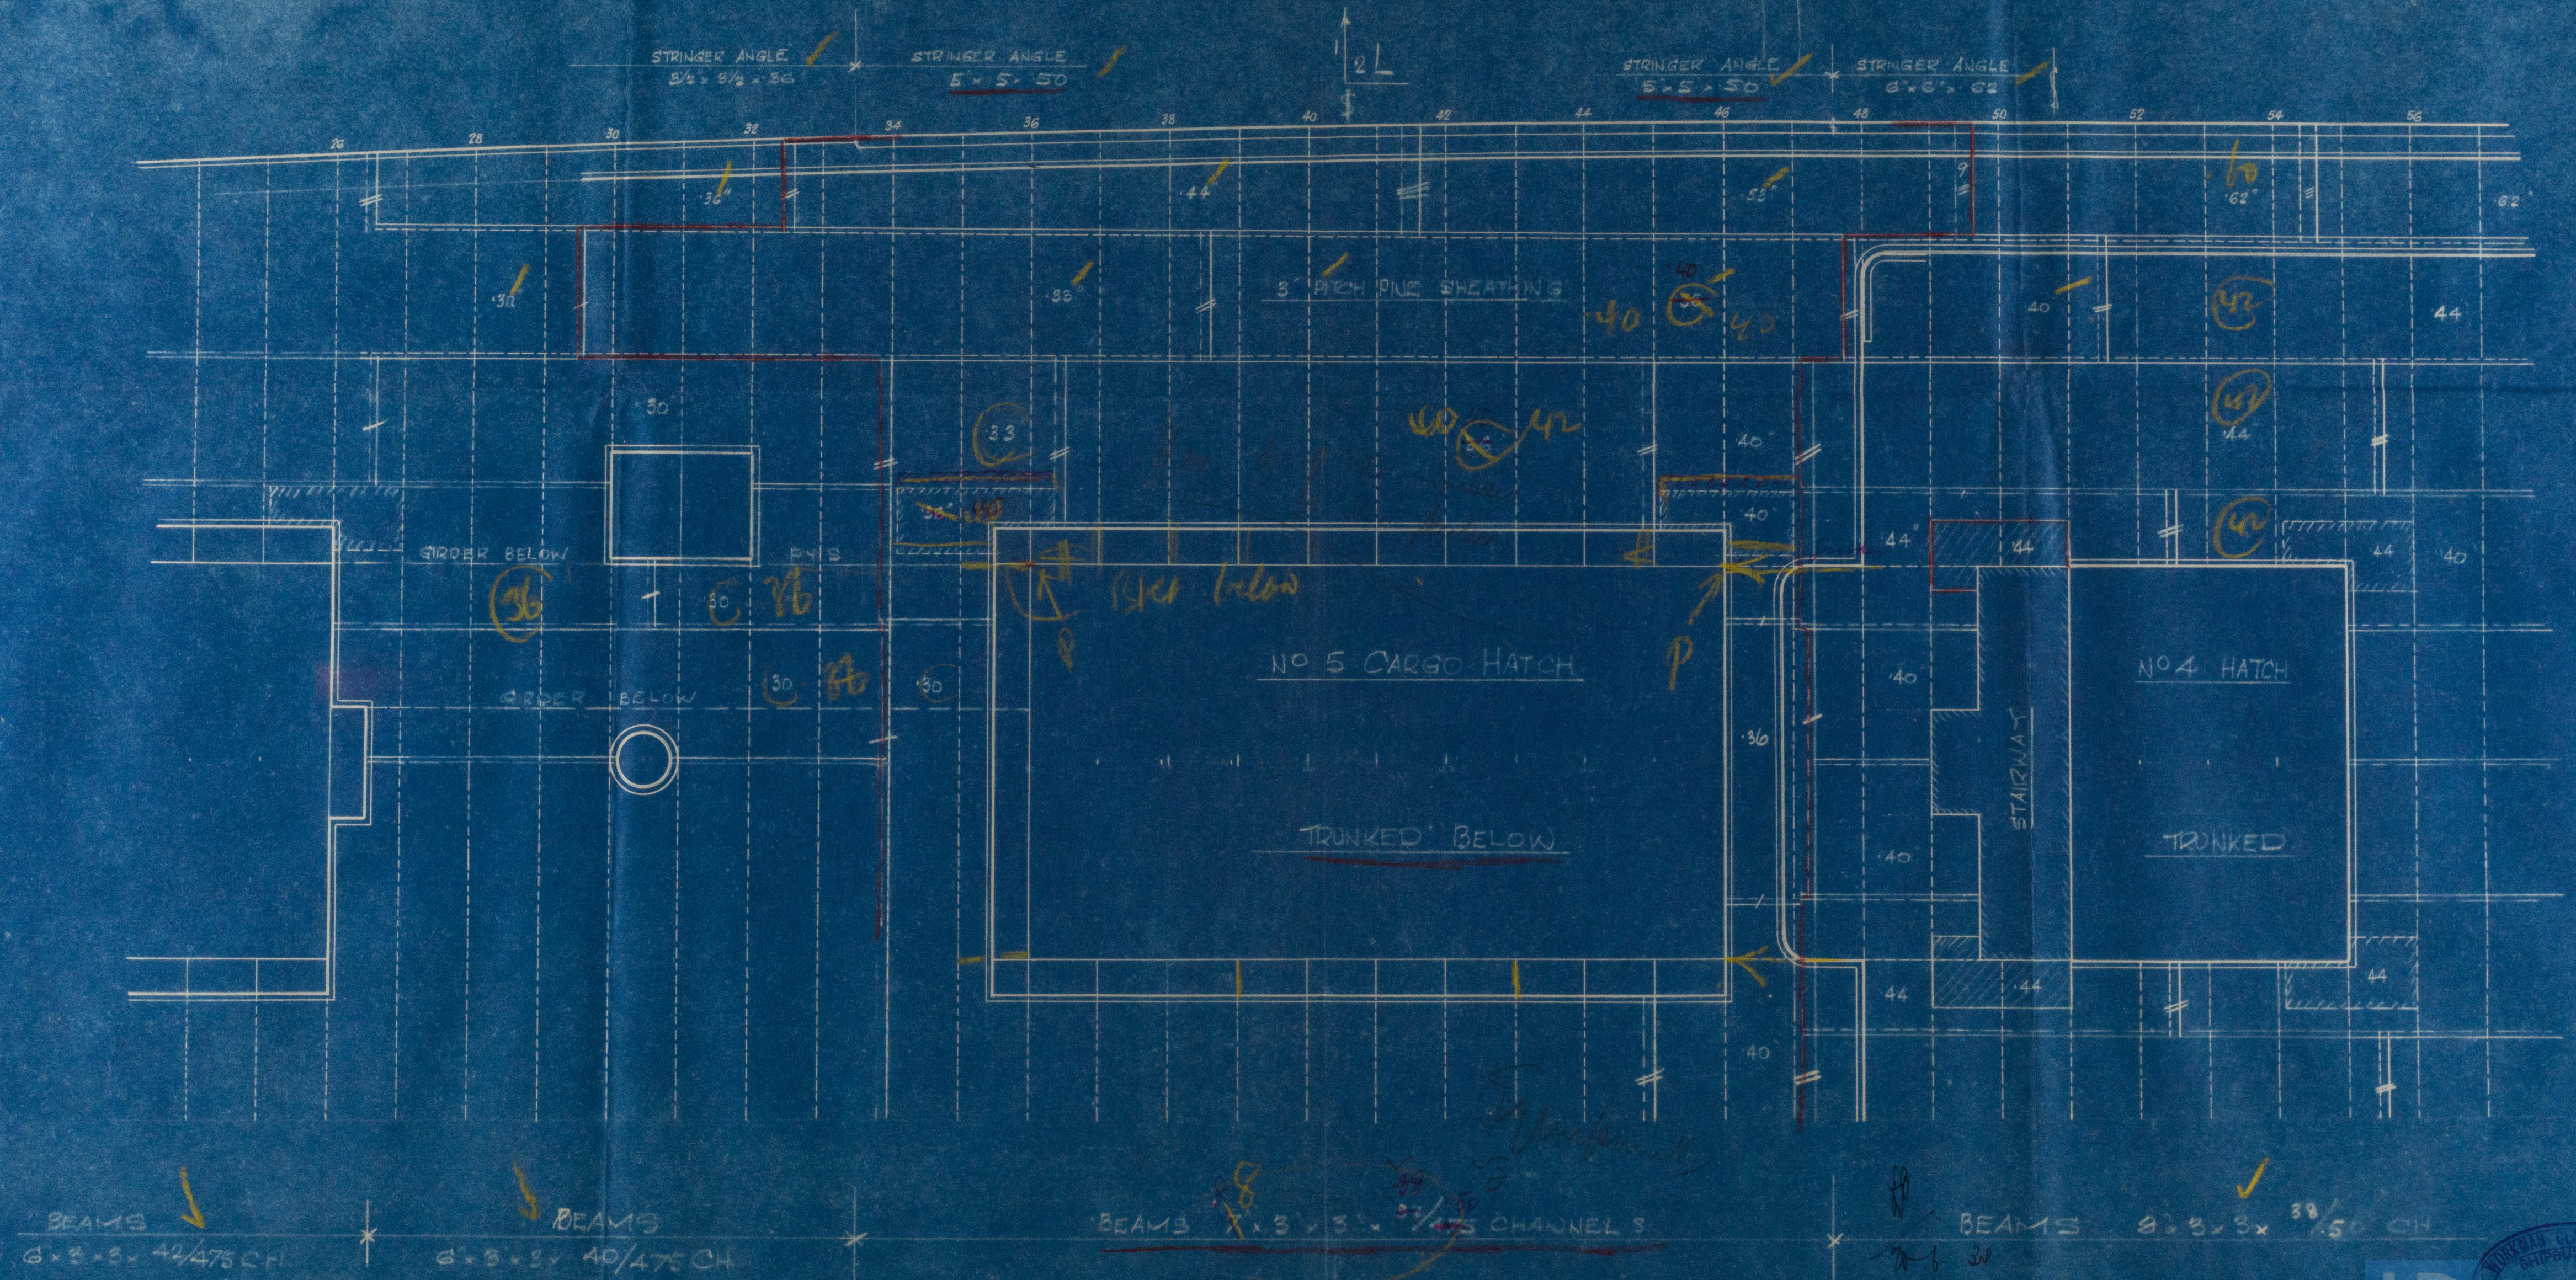

City of Venice

Rel. Sept. No. 11377

W236-0022



© 2020

Lloyd's Register  
Foundation

W236-0022