

20.6.34


CITY OF VENICE

MODIFICATIONS TO AFTER WELL.

SCALE $\frac{1}{2}'' = 1' - 0''$


NEW TRUNKED HATCH

SECTION AT NO 5 HATCH

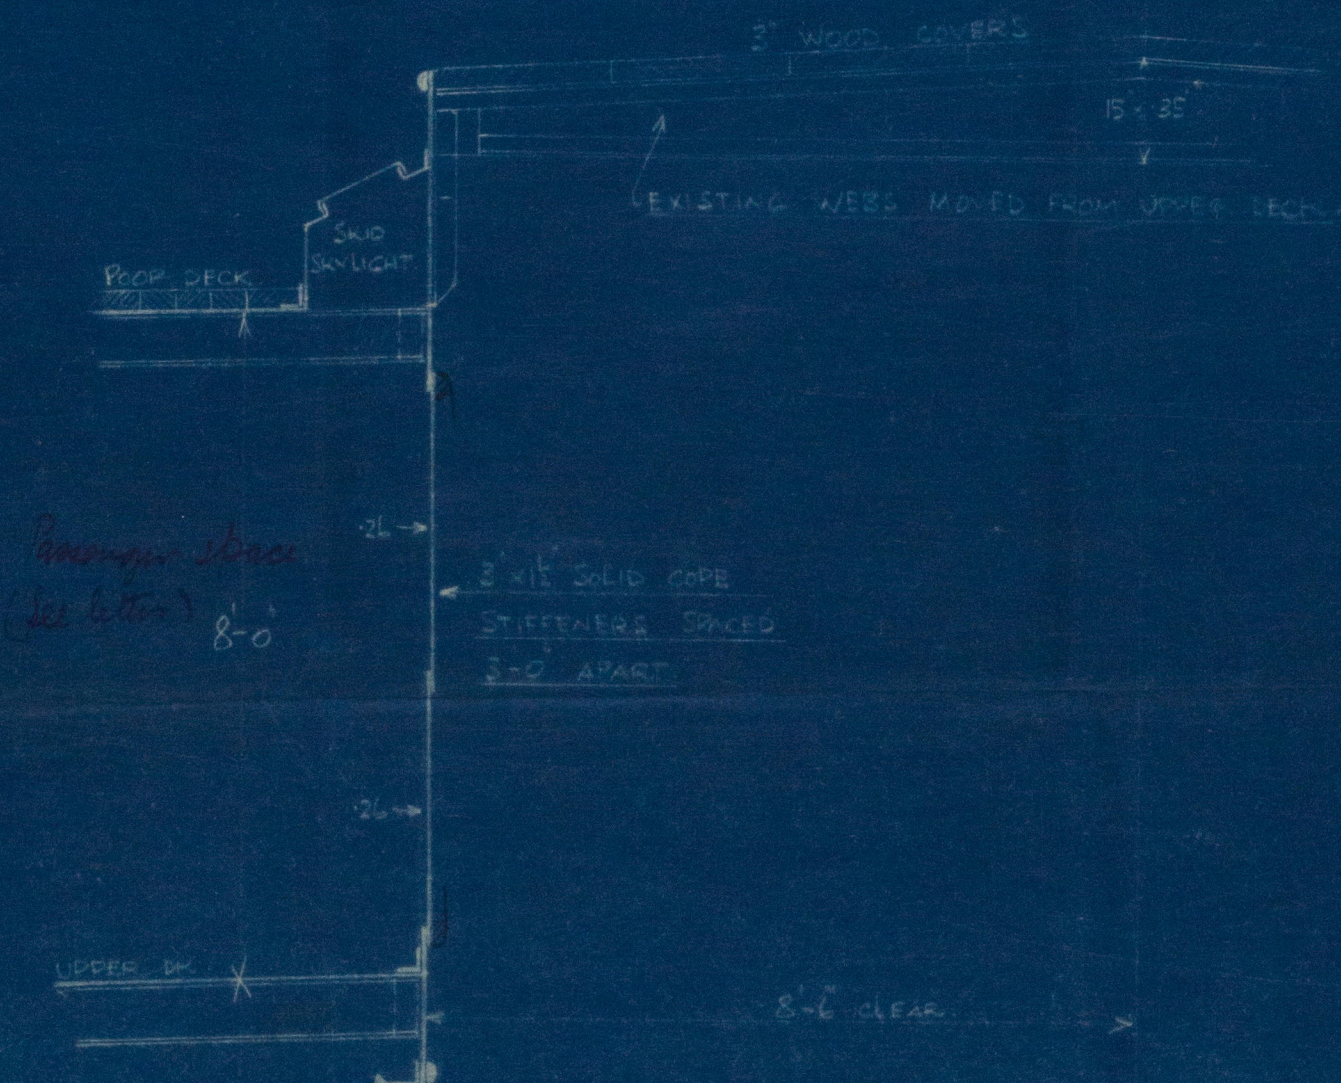

10'-6"

Note: Scantlings of web have been dealt with on the assumption that cargo of 50 cwt per lin will be carried in the trunkway.

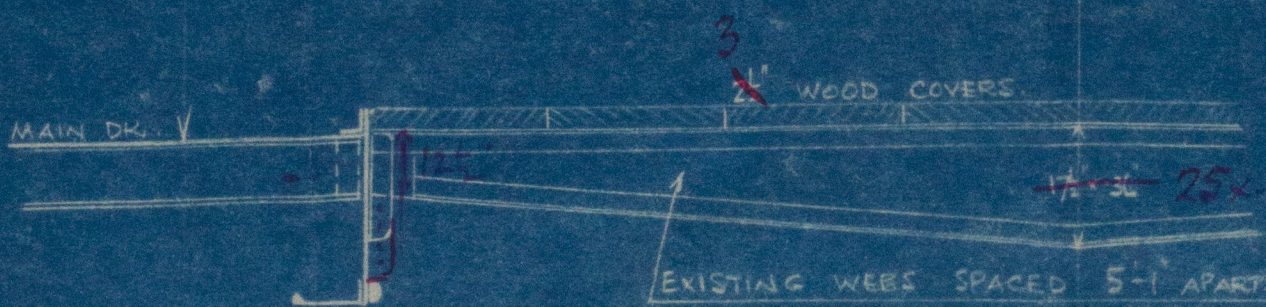

Existing Rib Plate

4th angles top & bottom 4x3x32 (existing)

20.6.34



SHIPBUILT
1.1.1934
ENGINE

W226-0023

City of Venice

Receipt 11377

Modifications to after well:

Section through N°5 trunked hatch



© 2020

Lloyd's Register
Foundation

W236-0023