

*MR*


# CITY OF VENICE

## MODIFICATIONS TO AFTER WELL.


SCALE  $\frac{1}{2}$ " = 1 FT

NEW TRUNKED HATCH

SECTION AT NO 5 HATCH

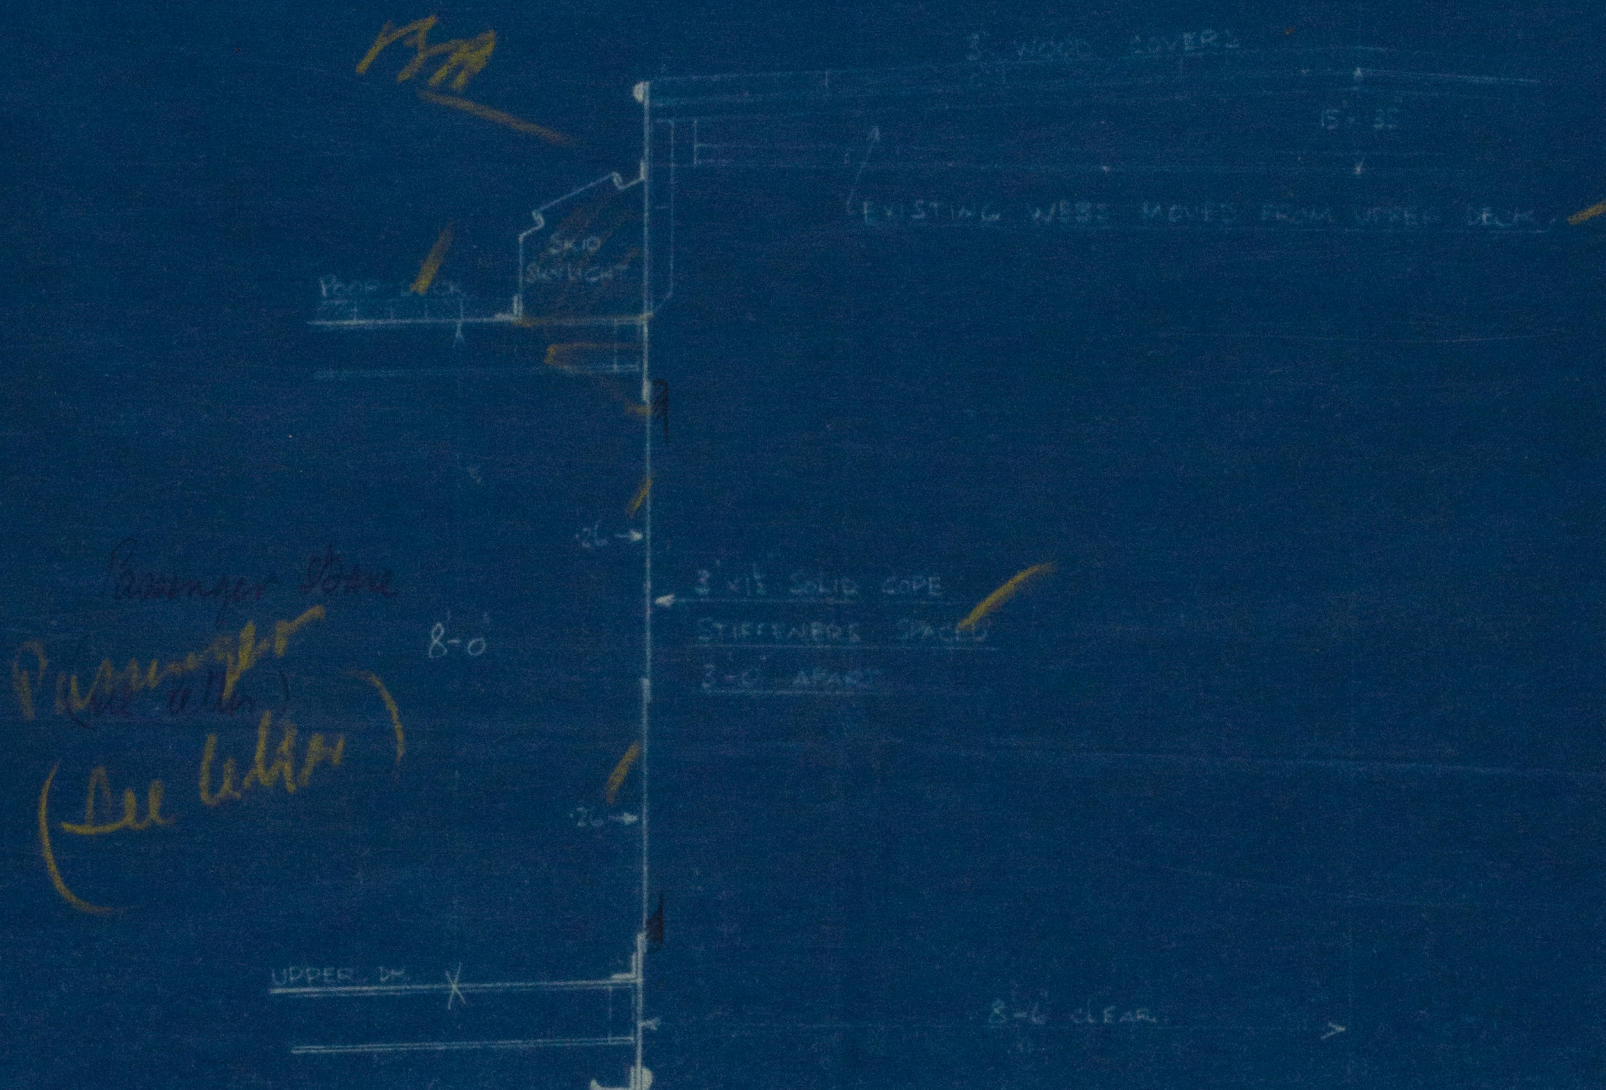


Note: - Drafting of web frame has been done with on the assumption that cargo of 50,000 lbs will be carried in the trunking area.

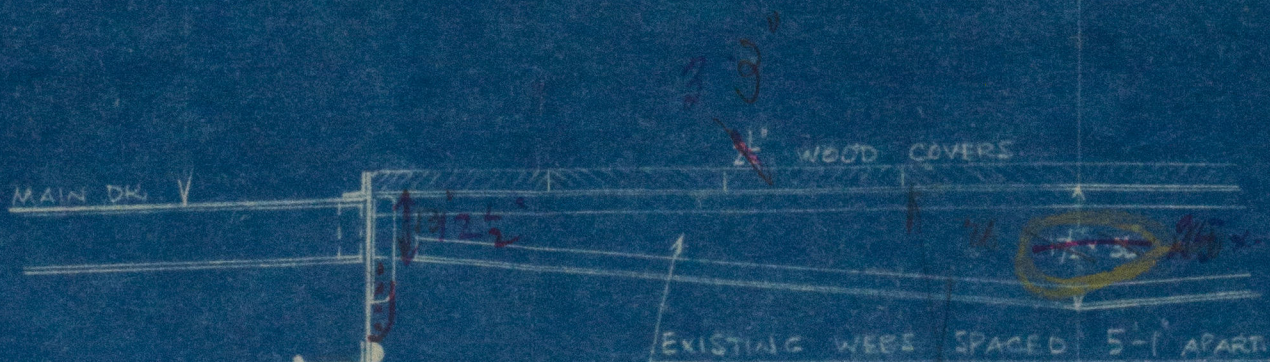

$\frac{433}{24} = 18.04$   
 $\frac{18}{24} = 0.75$   
 $18.04 + 0.75 = 18.79$

*Handwritten note:* 10x50

*Handwritten notes:* 10x50, 4x3x32, 4x3x32

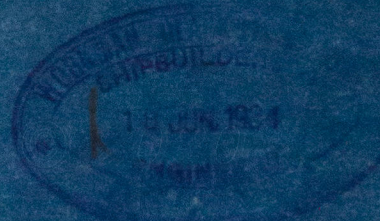



St. City of Venice,

Ref. rept. No. 11877.



© 2020

Lloyd's Register  
Foundation

W236-0024