29/5/33

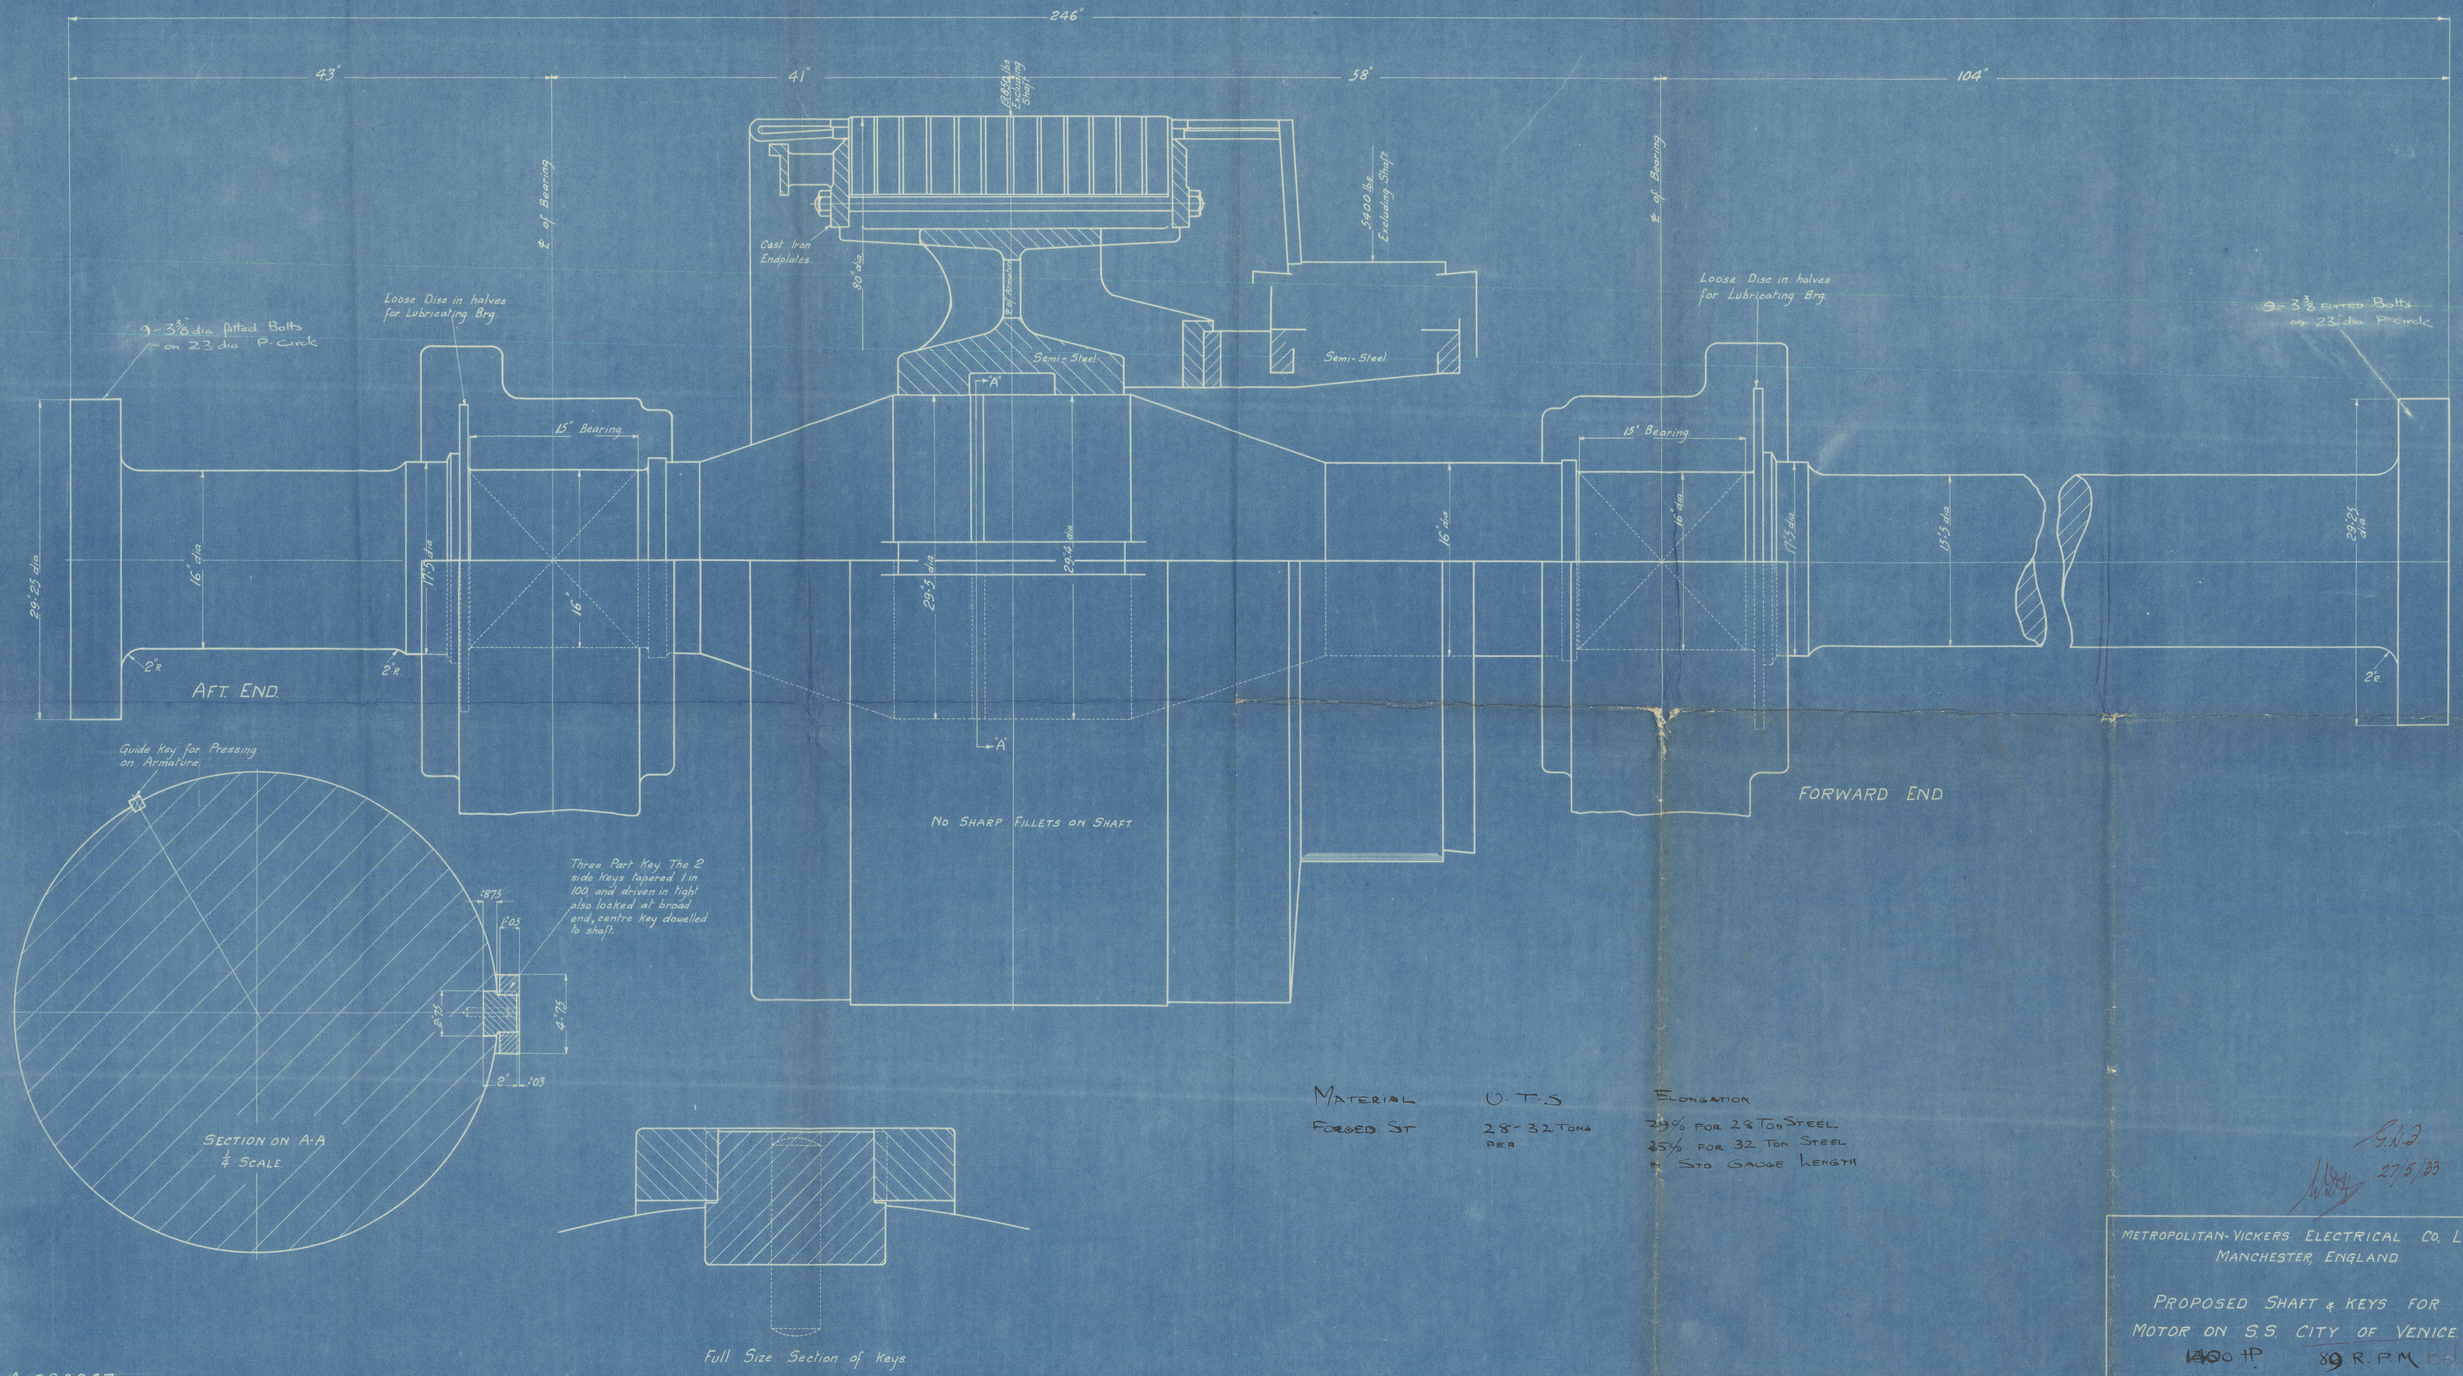

MATERIAL	U.T.S	ELONGATION
FORGED ST	28-32 TONS PER	29% FOR 28 TON STEEL 25% FOR 32 TON STEEL IN STD GAUGE LENGTH

G.N.J.
27/5/33

METROPOLITAN-VICKERS ELECTRICAL CO. LTD.
MANCHESTER, ENGLAND

PROPOSED SHAFT & KEYS FOR
MOTOR ON S.S. CITY OF VENICE.
1400 HP 89 R.P.M. Bd. 11156

Scale, 2" to 1 Foot. S.O. 215707/6 A869067

A 869067

1	Date 9-5-33
	Checked
	Dwg. Appd
	Des.

Drawing Issued by Plant D.O.
To:

© 2020 Lloyd's Register Foundation