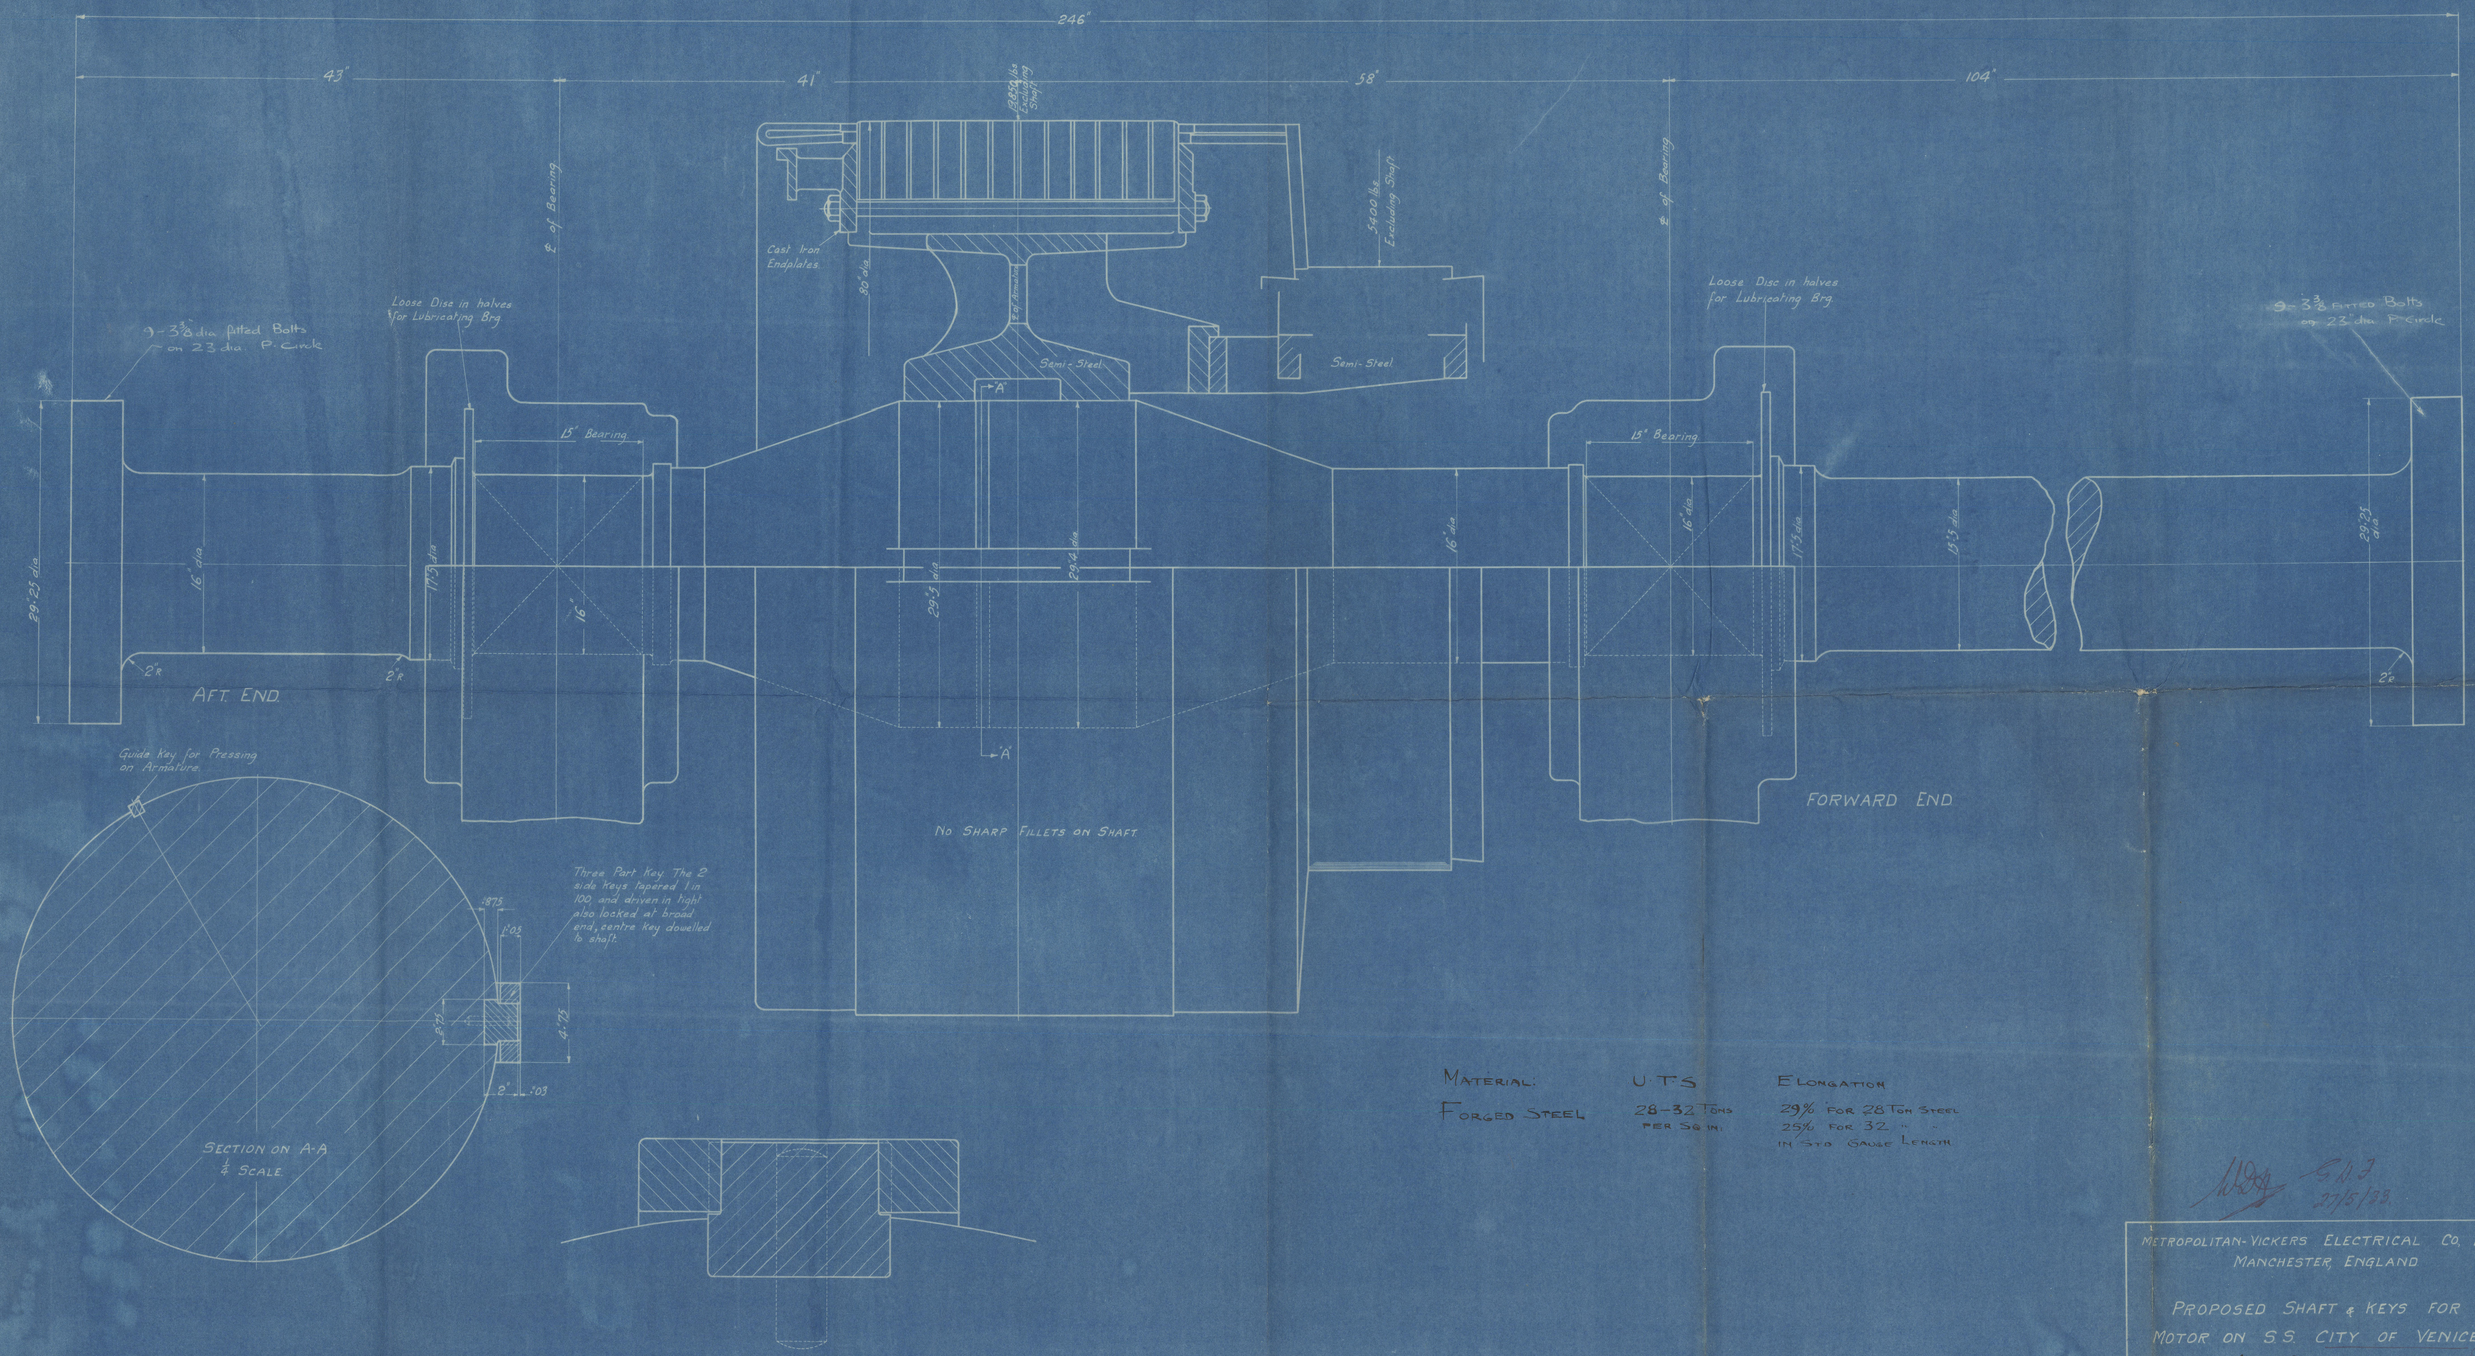

Material:	U.T.S	Elongation
Forged Steel	28-32 Tons per Sq. in.	29% for 28 Ton Steel 25% for 32 " " in Std. Gauge Length

G.D.F.
27/5/33

METROPOLITAN-VICKERS ELECTRICAL CO. LTD.
MANCHESTER, ENGLAND

PROPOSED SHAFT & KEYS FOR MOTOR ON S.S. CITY OF VENICE.

1400 HP 89 R.P.M.

Scale: 2" to 1 Foot. S.O. 215707/6 A869067

A 869067

Date	9-5-33
Checked	
Dwg. App'd	
Des.	

Drawing Issued by Plant D.O.

To:

© 2020 Lloyd's Register Foundation