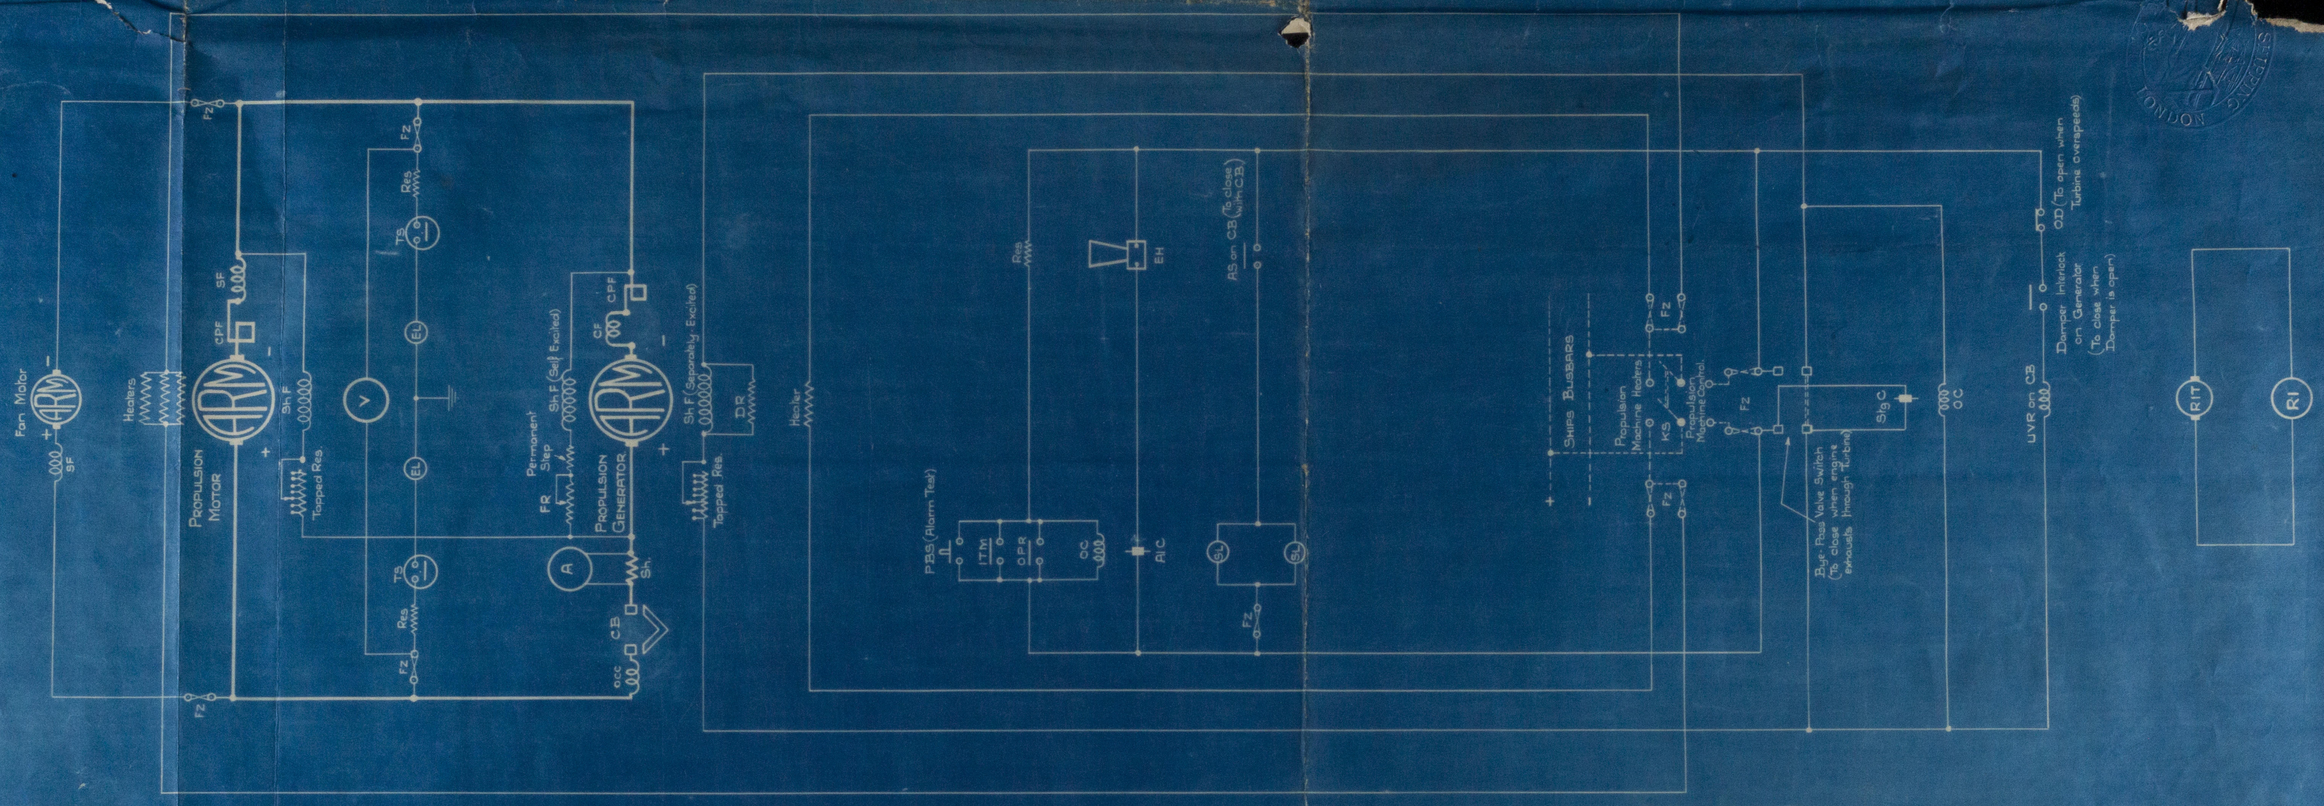

Symbol List

A	Ammeter
AIC	Alarm Contactor
ARM	Armature
AS	Auxiliary Switch
CB	Circuit Breaker
CF	Compensating Field
CPF	Commutating Pole Field
DR	Discharge Resistance
EH	Electric Horn
EL	Earth Lamp
FR	Field Rheostat
FZ	Fuse
ITM	Indicating Thermostat on Motor
KS	Knife Switch
OC	Operating Coil
OD	Overspeed Device
OPR	Oil Pressure Relay
PBS	Push Button Switch
Res	Resistance
RI	Turbine Revolution Indicator
RIT	Revolution Indicator Transmitter
SF	Series Field
Sh	Shunt
ShF	Shunt Field
SL	Signal Lamp
Stg C	Starting Contactor
TS	Tumbler Switch
UVR	Under Voltage Release
V	Voltmeter
OCC.	Overcurrent Coil.

Main Contacts closed in De-energised Position

Auxiliary Contacts Open in De-energised Position

Auxiliary Contacts Closed in De-energised Position.

Gear shown Dotted not supplied under this Contract.

For Complete Diagram of Connections see A 855284.

METROPOLITAN-VICKERS ELECTRICAL CO. LTD

MANCHESTER, ENGLAND.

Schematic Diagram of Connections for Non-Reversing Exhaust Steam Turbo Electric Equipment for SS "City of Venice" Bel 11156

Messrs Workman, Clark (1928) Ltd. Belfast.

SCALE = S.O. 815707/7

B855283

P.R.

1	Date 13.5.33	2	Date 7.7.33.		Date		Date		Date		Date		Date		Drawing Issued by		
	Checked W. Campbell		Checked F. L. Worrall		Checked		Checked		Checked		Checked		Checked		Ind. Sw'Gr.	D.O.	
	Drg. Appd.		Drg. Appd.		Drg. Appd.		Drg. Appd.		Drg. Appd.		Drg. Appd.		Drg. Appd.				
	Design Appd.		Design Appd.		Design Appd.		Design Appd.		Design Appd.		Design Appd.		Design Appd.				

Res was shown in series with UVR.

Exon 17/7/33

Lloyd's Register Foundation

LR