


TO CLASS LLOYDS 100A1.

KNEES :- 18" deep x .40.

KNEES :- 21" deep x .46

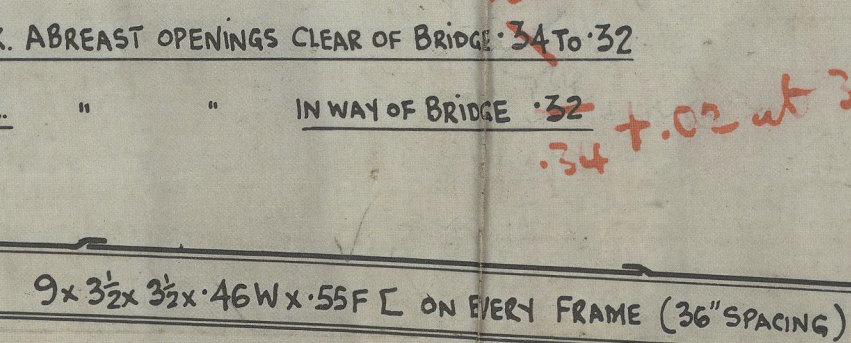

Workman Clock & Co.

Nº 468

Midship Section

City of Venice

Rel 9091



© 2020

Lloyd's Register
Foundation

W236-0151