


RH35

Z. № 22803

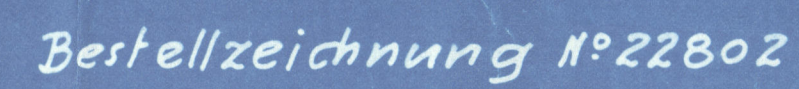

RH35

Z.Nº22803




RH 35

Z. № 22803




RH35

Z. № 22803

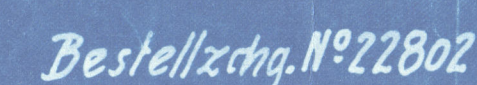

RH35

Z. № 22803

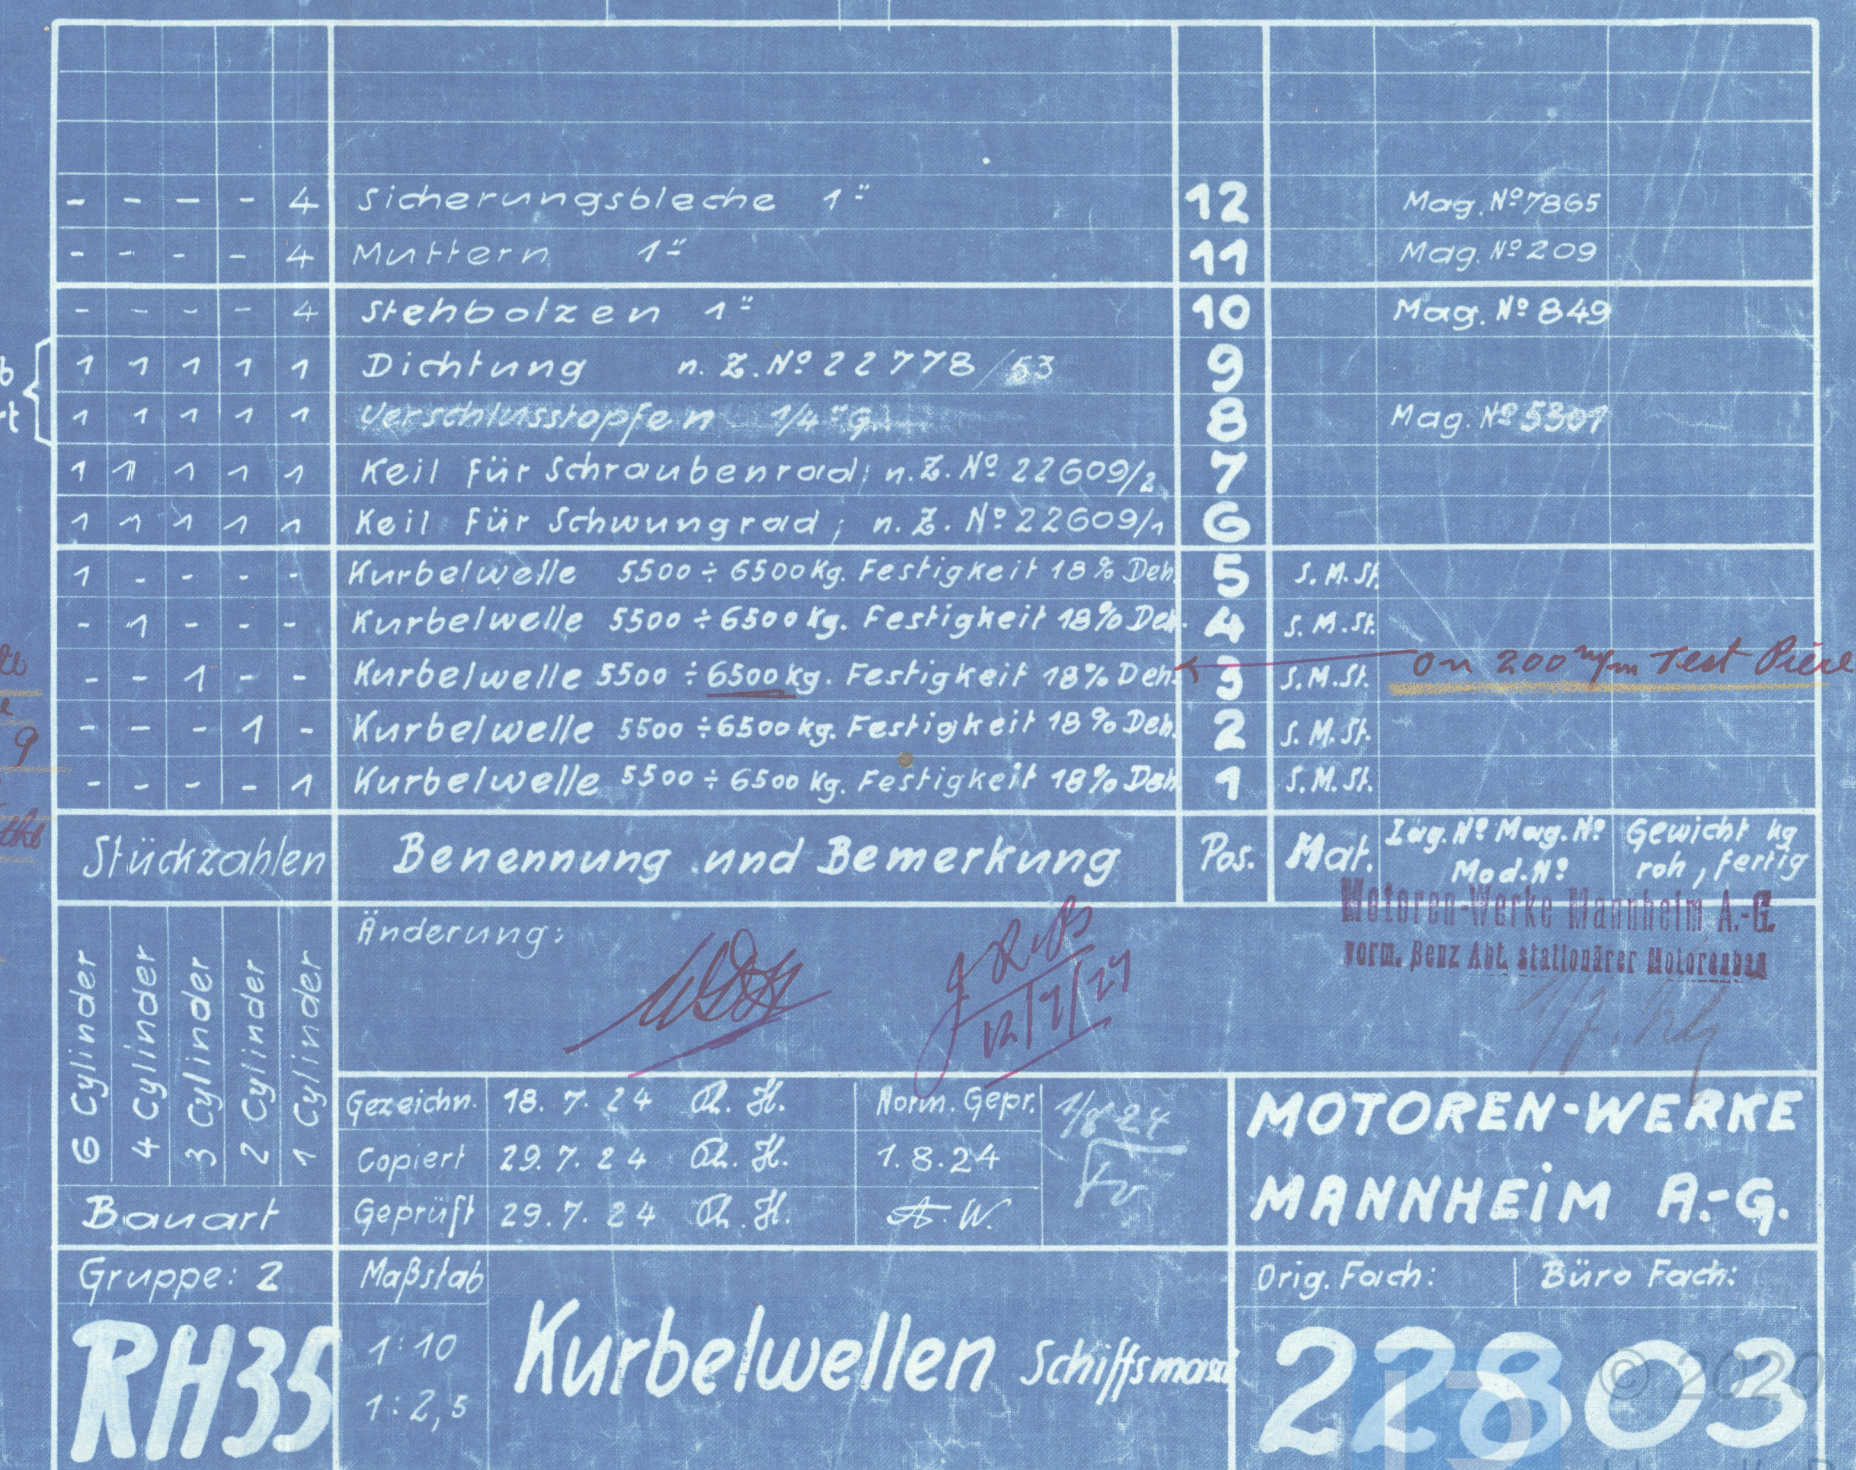

Z. № 22803

Motorenwerke Mannheim ch. d.

auxiliary heavy oil engine.

for Deutsche Lloyd Hamburg.

Sunday letter of 1st July 1927.

Frank ship.

8/5 Sagami n. n. "Congella"

N.Y.K. 27299.

© 2020

Lloyd's Register
Foundation

W238-0208