


Nº 666.

PROFILE & DECKS.

SCALE: 1/8" = 1 FOOT. PLAN NO. 1 A.
DIMENSIONS: 350'-0" x 50'-0" x 31'-6" TO SHELTER DECK.
TO CLASS 100 A1 AT LLOYDS.

ALL SECTIONS ARE NEW BRITISH STANDARD.
ALL MATCHES 14'-0" WIDE.

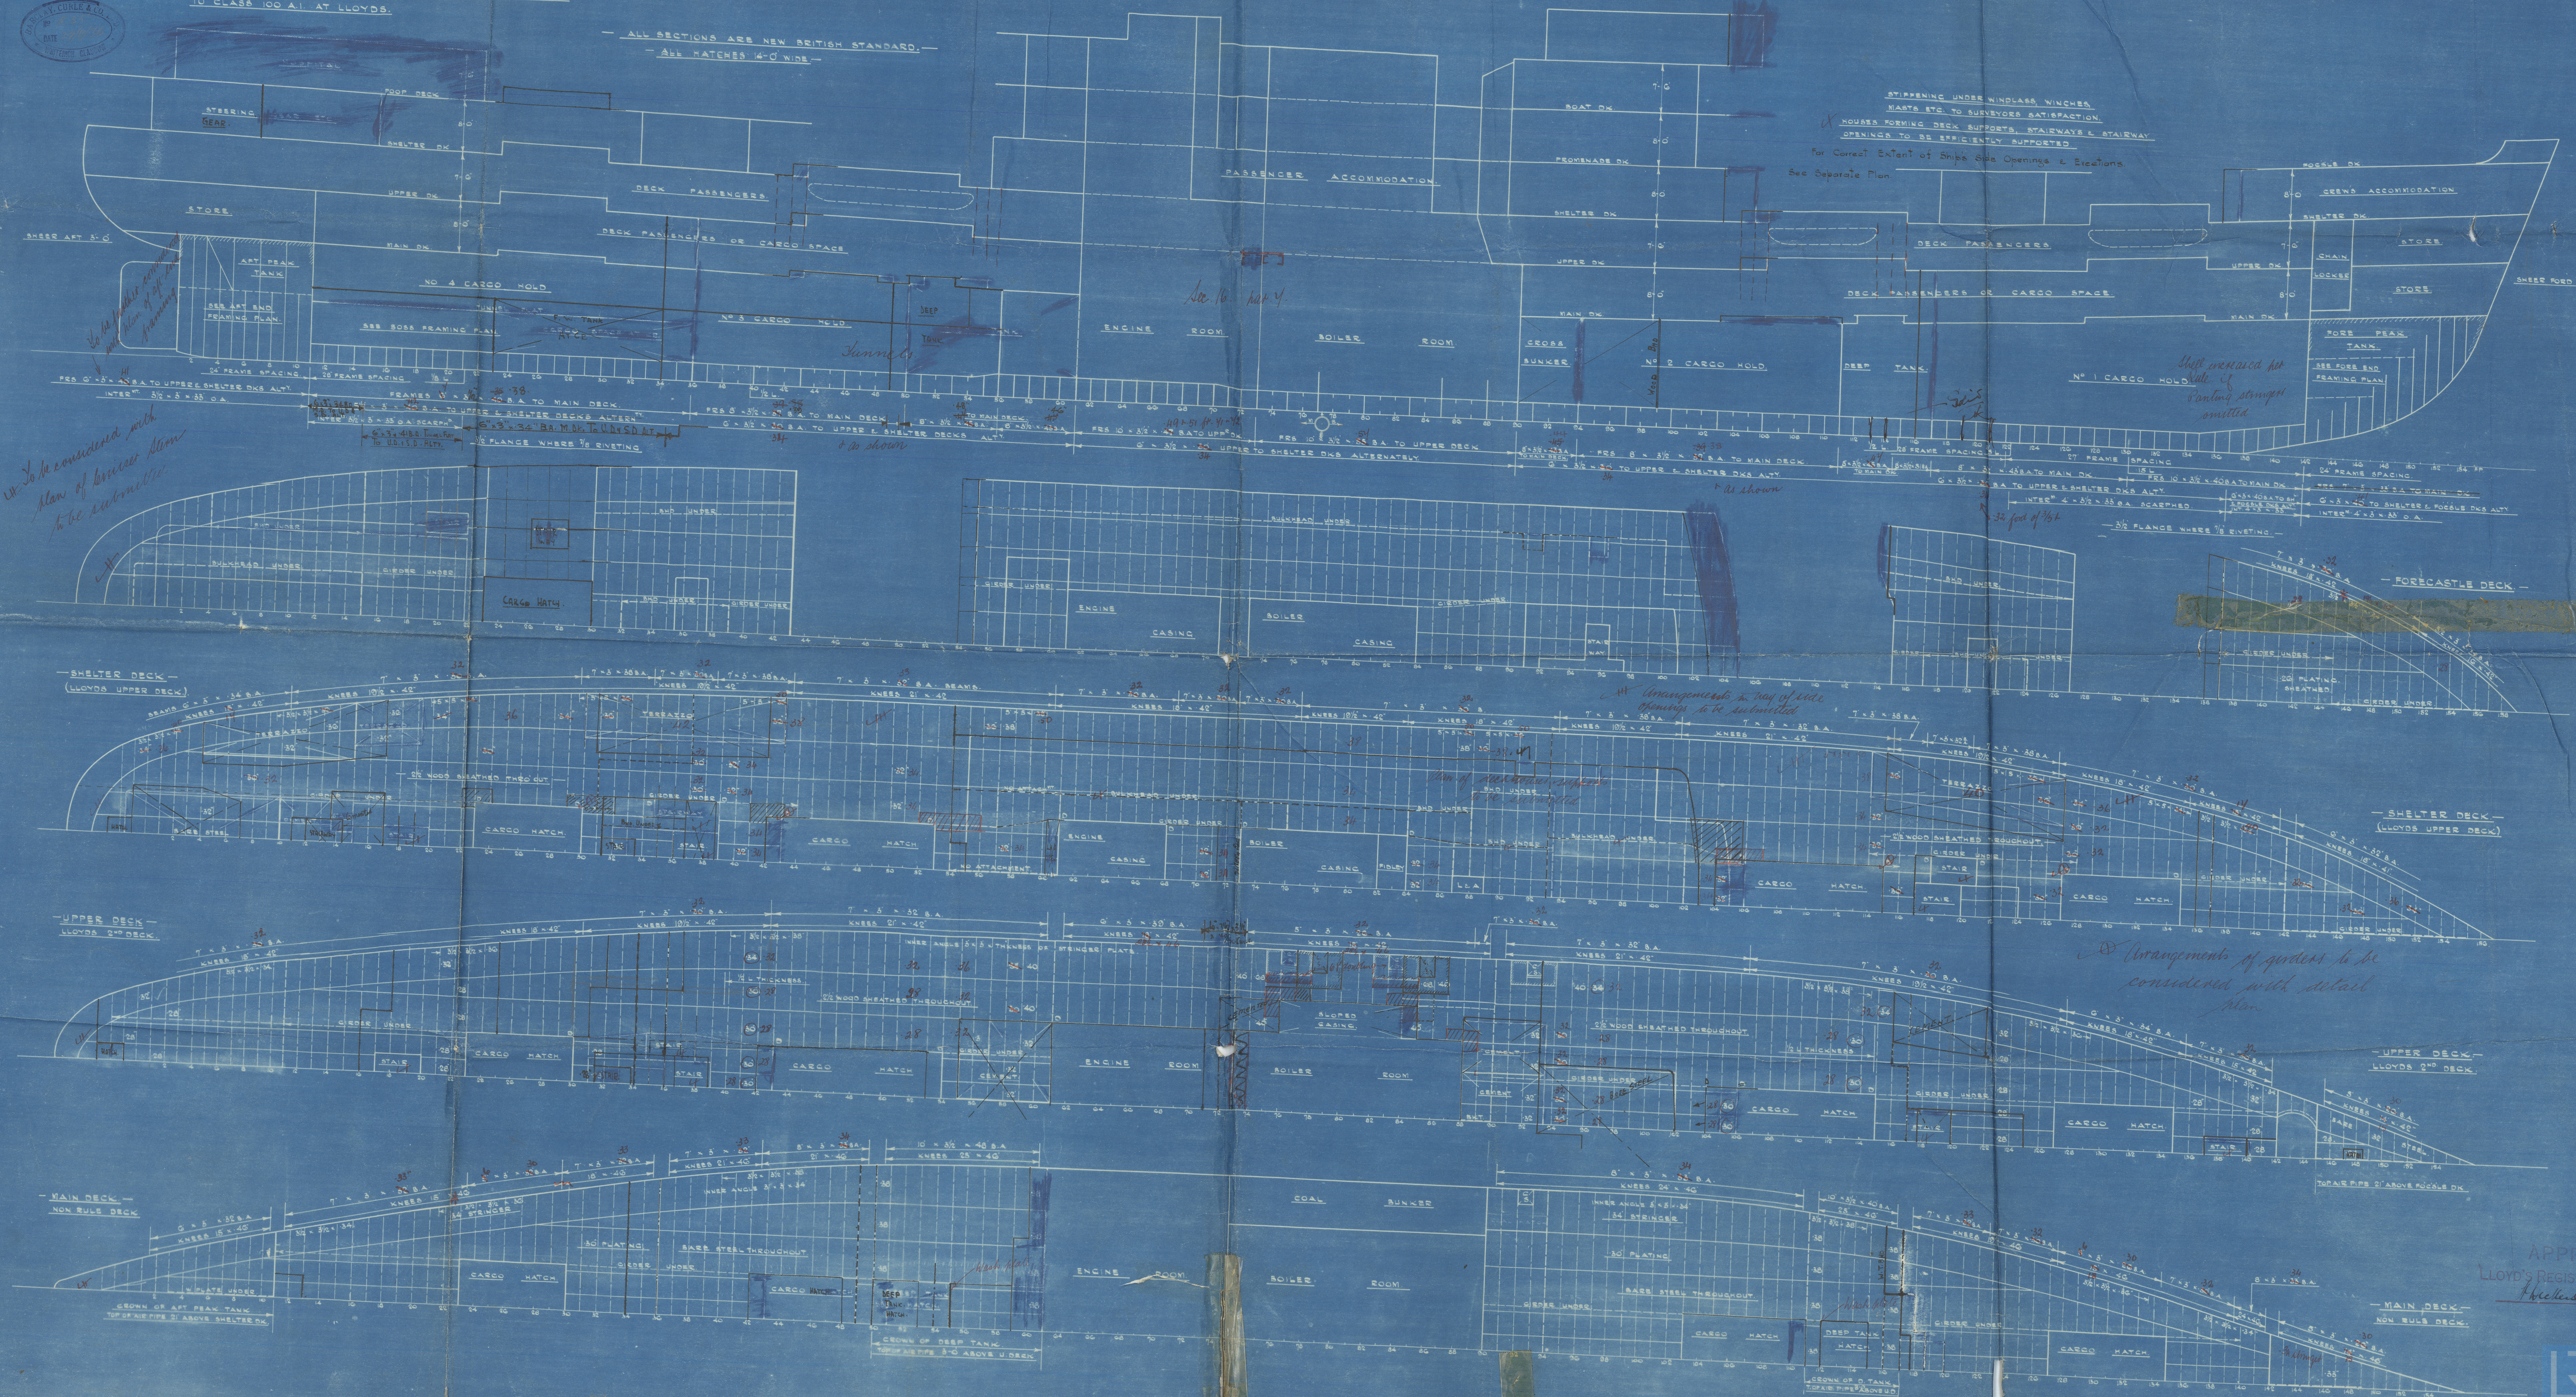

Barclay Curle & Co Ltd

666

Profile & Decks.

GLASGOW REPORT No. 57723

Yhd
GLASGOW REPORT No. 58998

666 "El Madina"
GLASGOW REPORT No. 59070

W240-0113



© 2020

Lloyd's Register
Foundation