



3.6.10

PROFILE & DECK PLAN

N^o 471


DIM^{NS} 120' 0" B.P. BREADTH EX, 22' 0" x 12' 4" MLD

SCALE $\frac{1}{4}$ " = 1 FOOT.

9502

Rev^d Lloyd's Surveyors
Hall

31/5/10 KR

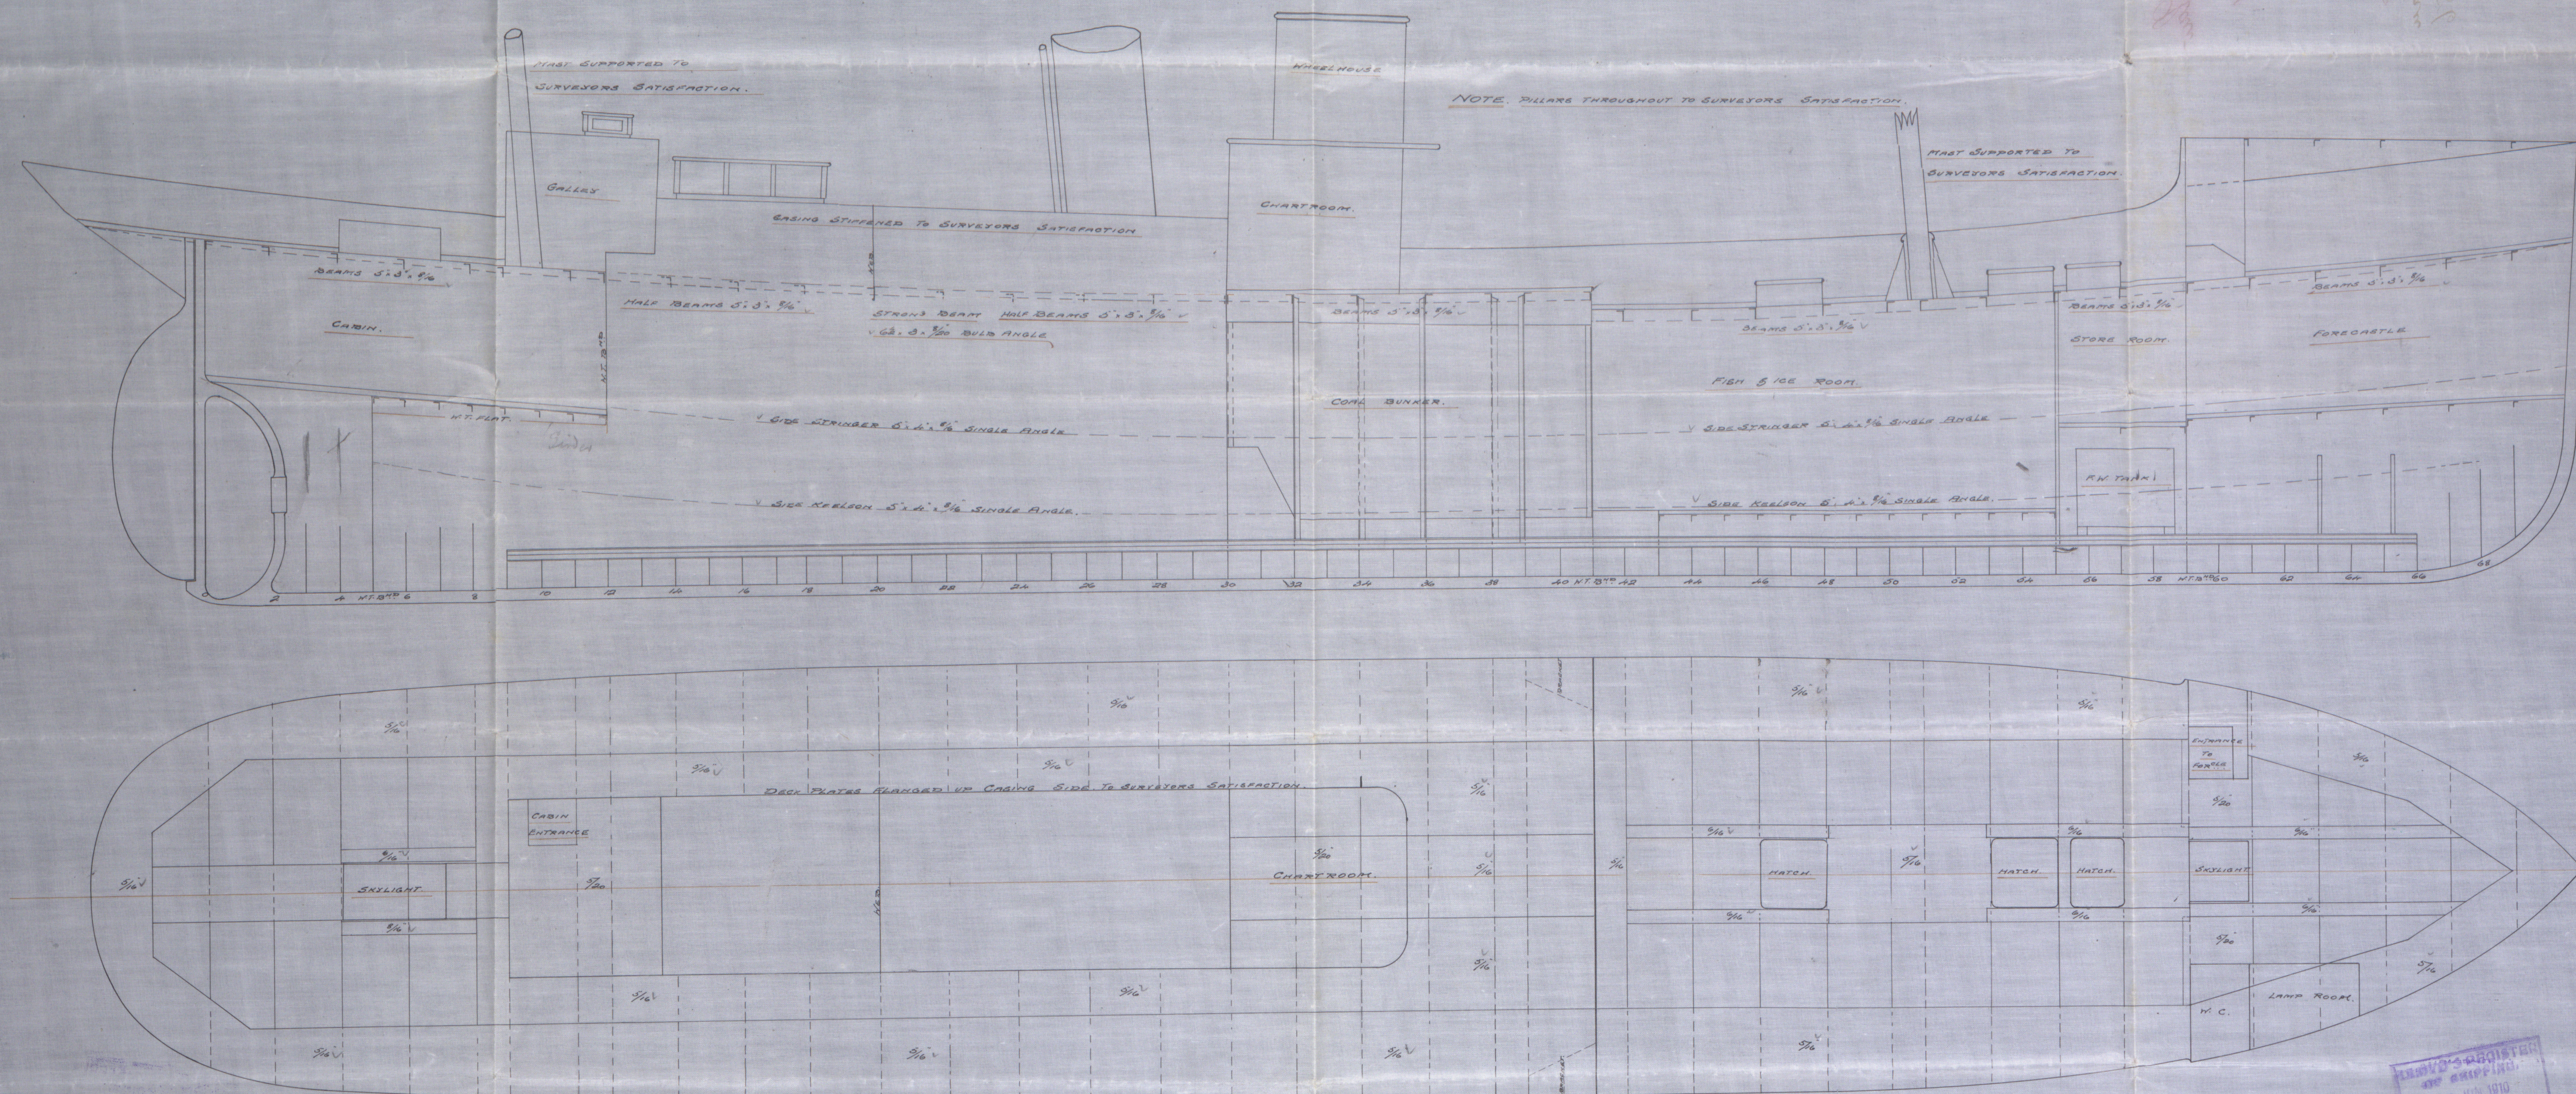


APPROVED FOR SHIPING
31-5-1910

3/6/10

- Profile & Deck Plan
Cochranes & Sons

No 4^{ys}

31/2/10

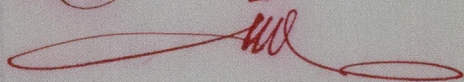

S/S Eileen Duncan
Hull R# 2. 23086

W241-0097



© 2019

Lloyd's Register
Foundation