

3.6.10

PLAN 9249
Mess Lloyd's Surveyors
Hull
DATE 3/5/10 R.H.

MIDSHIP SECTION


STEEL SCREW TRAWLER

N^o 471

DIM^{NS} 120'0" B.P. x 22'0" E. x 12'4" DEPTH M^{LD}

SCALE $\frac{1}{2}$ = 1 FOOT

TO CLASS 100 A.1. AT LLOYD'S FOR FISHING PURPOSES
ENGINE & BOILER CASING AS PREVIOUSLY APPROVED

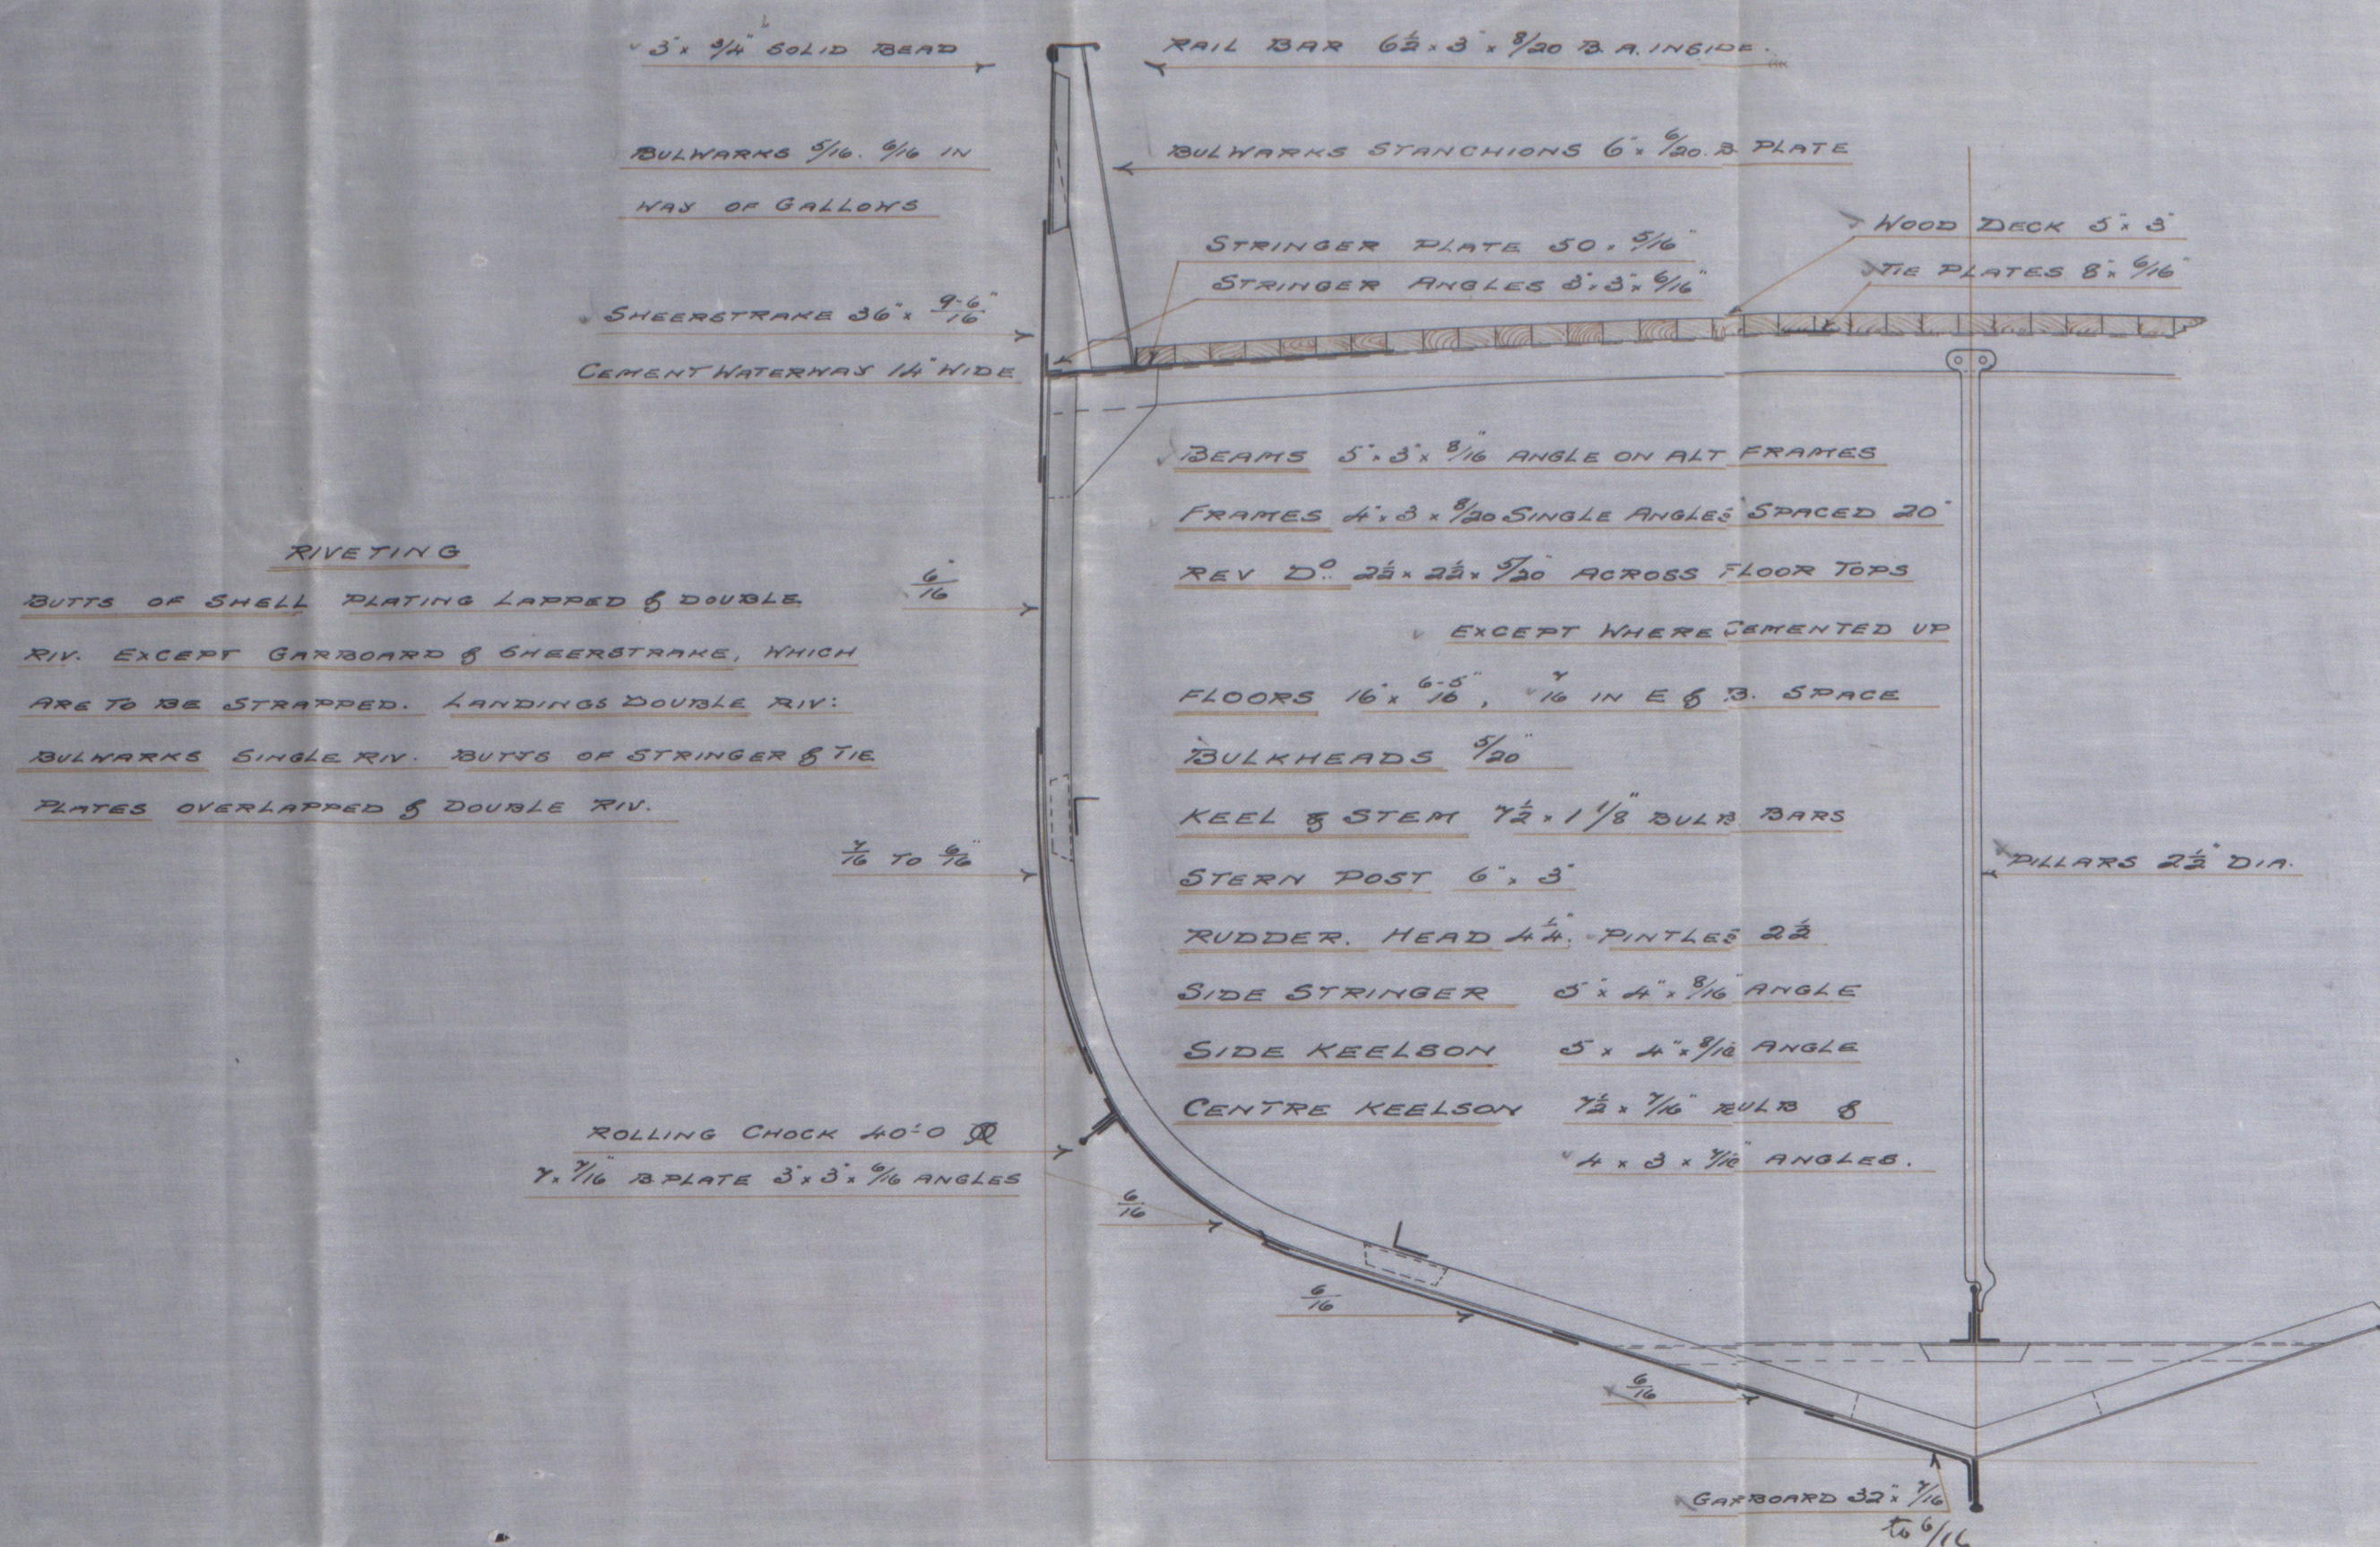

RIVETING.
BUTTS OF SHELL PLATING LAPPED & DOUBLE
RIV. EXCEPT GABBOARD & SHEERSTRAKE, WHICH
ARE TO BE STRAPPED. LANDINGS DOUBLE RIV.
BULKHEADS SINGLE RIV. BUTTS OF STRINGER & TIE
PLATES OVERLAPPED & DOUBLE RIV.

NUMERALS

$B + D = 34.18 \checkmark$
 $L \times (B + D) = 4101.6 \checkmark$


PROPORTIONS

$\frac{B}{L} = \frac{5.4 \checkmark}{9.7 \checkmark}$

EQUIPMENT

1ST BOWER ANCHOR = $5 \frac{1}{2}$ CHTS EX STOCK
2ND " " " " $4 \frac{1}{2}$ " " " "
3RD " " " " $2 \frac{1}{2}$ " " " "
90 FATHOMS " " " " 1" CABLE
60 " " " " 6" HANGER
60 " " " " $4 \frac{1}{2}$ WARP

ASW
1-6-10

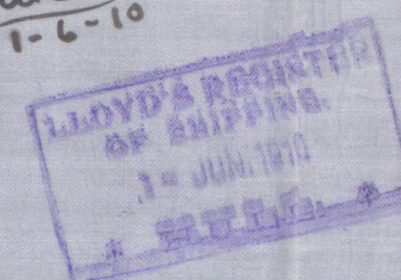

Cf.
3/6/10

- Midship Secretary -
Cochrane & Sons

No 441

Sp Eileen Duncan
Hull Rpt h. 23086

W241-0098



© 2019

Lloyd's Register
Foundation