

S. S. Nº 471.

SECTION OF GIRDER UNDER UPPER DECK
IN MAIN HOLO CLEAR OF BRIDGE.

SECTION OF GIRDER IN FORE HOLD
CLEAR OF HATCH

THIS GIRDER IS A CONTINUATION OF
HATCH SIDE GIRDER. (SEE DECK PLAN

POSITION OF GIRDERS
(AS SHOWN ON DECK PLAN)

4583
471540
12/10/09

© 2019
Lloyd's Register
Foundation

J L Thompson & Sons Ltd.

491 Amended

PROFILE

Std 24383


"Elisabeth Dal."



ex
S. S. Maresfield
Std Fbrd. No. 24356

Std F.E. Rpt 24383

W241-0202

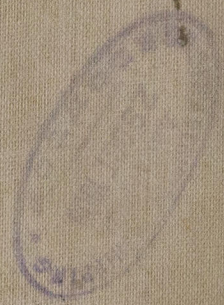

© 2019

Lloyd's Register
Foundation