

Drawing 7793

Glasgow.


Mem Cochran & Co Annan Ld

Boiler 5045

Mem J L Thompson & Sons S/s 471
Maresfield

GLASGOW REPORT No: 28382

Now Elizabeth Dal.
~~Lester~~

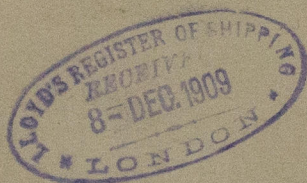

This is a duplicate of
drawing 5952 except that
the tubes in this drawing
are made No 16 W G



© 2019

W241-0203

Lloyd's Register
Foundation