


N° 187 & 188
PROFILE & DECK PLAN
 DIMNS:- 160'-0" x 26'-6" x 10'-3" MLD
 SCALE:- 1/4" = 1 FOOT
 TO CLASS 100 A.1 AT LLOYDS

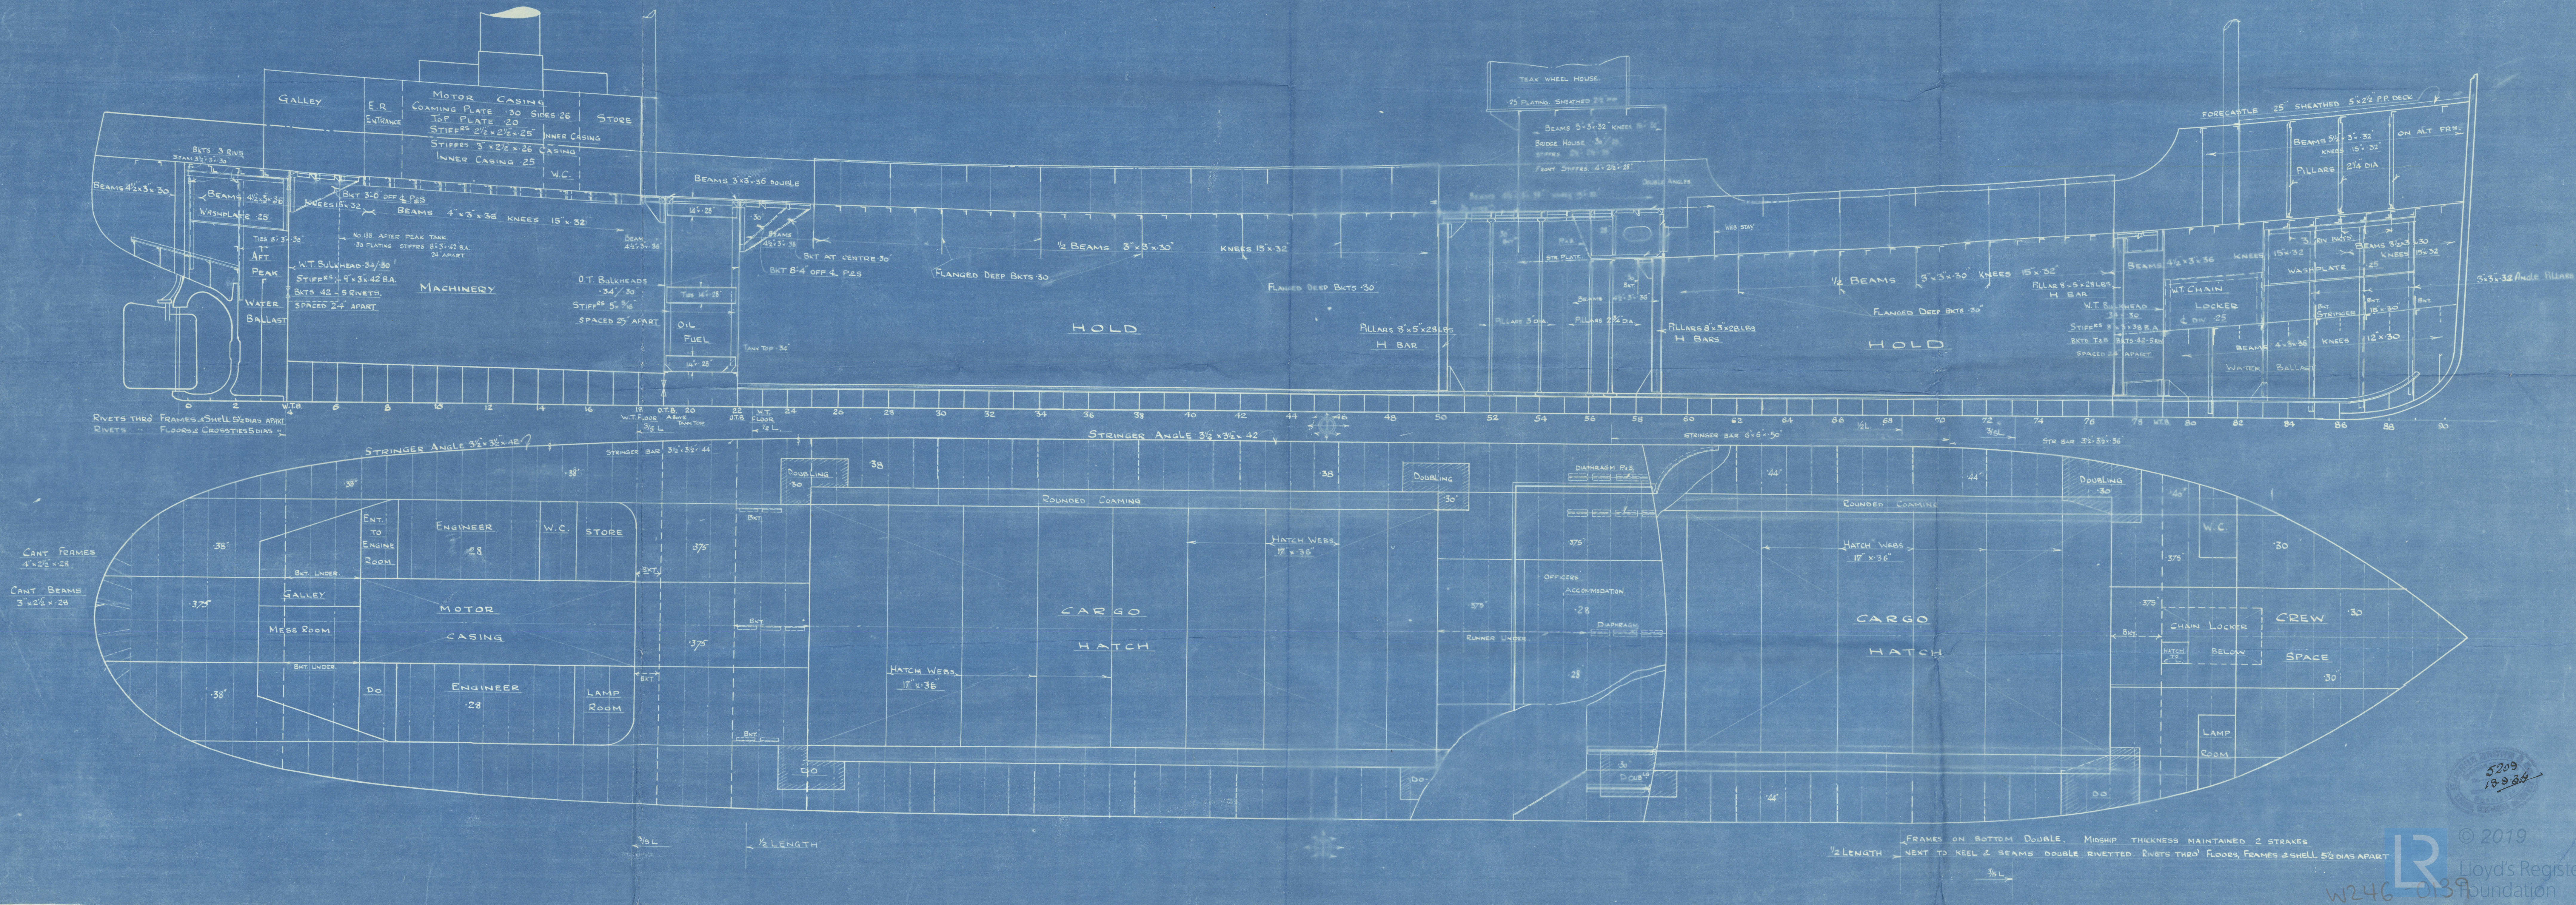

5209
 18-9-36

19817

M.V. GRIT

GEO BROWN & Co's

No 188

PROFILE & DECK PLAN

As BUILT

GREENOCK FIRST ENTRY.

REPORT No 19817



© 2019

Lloyd's Register

Foundation
W246-0139