


S.S.N 403.
- Scale $\frac{1}{2}" = \text{one Ft.}$ -
Dimensions 330'-6" x 48'-9" x 24'-9"
CLASS 100 A.I. SPAR DECK.
LLOYD'S MINIMUM SCANTLING TO OBTAIN FULL FREEBOARD.

18.4.07.
6.5.07.

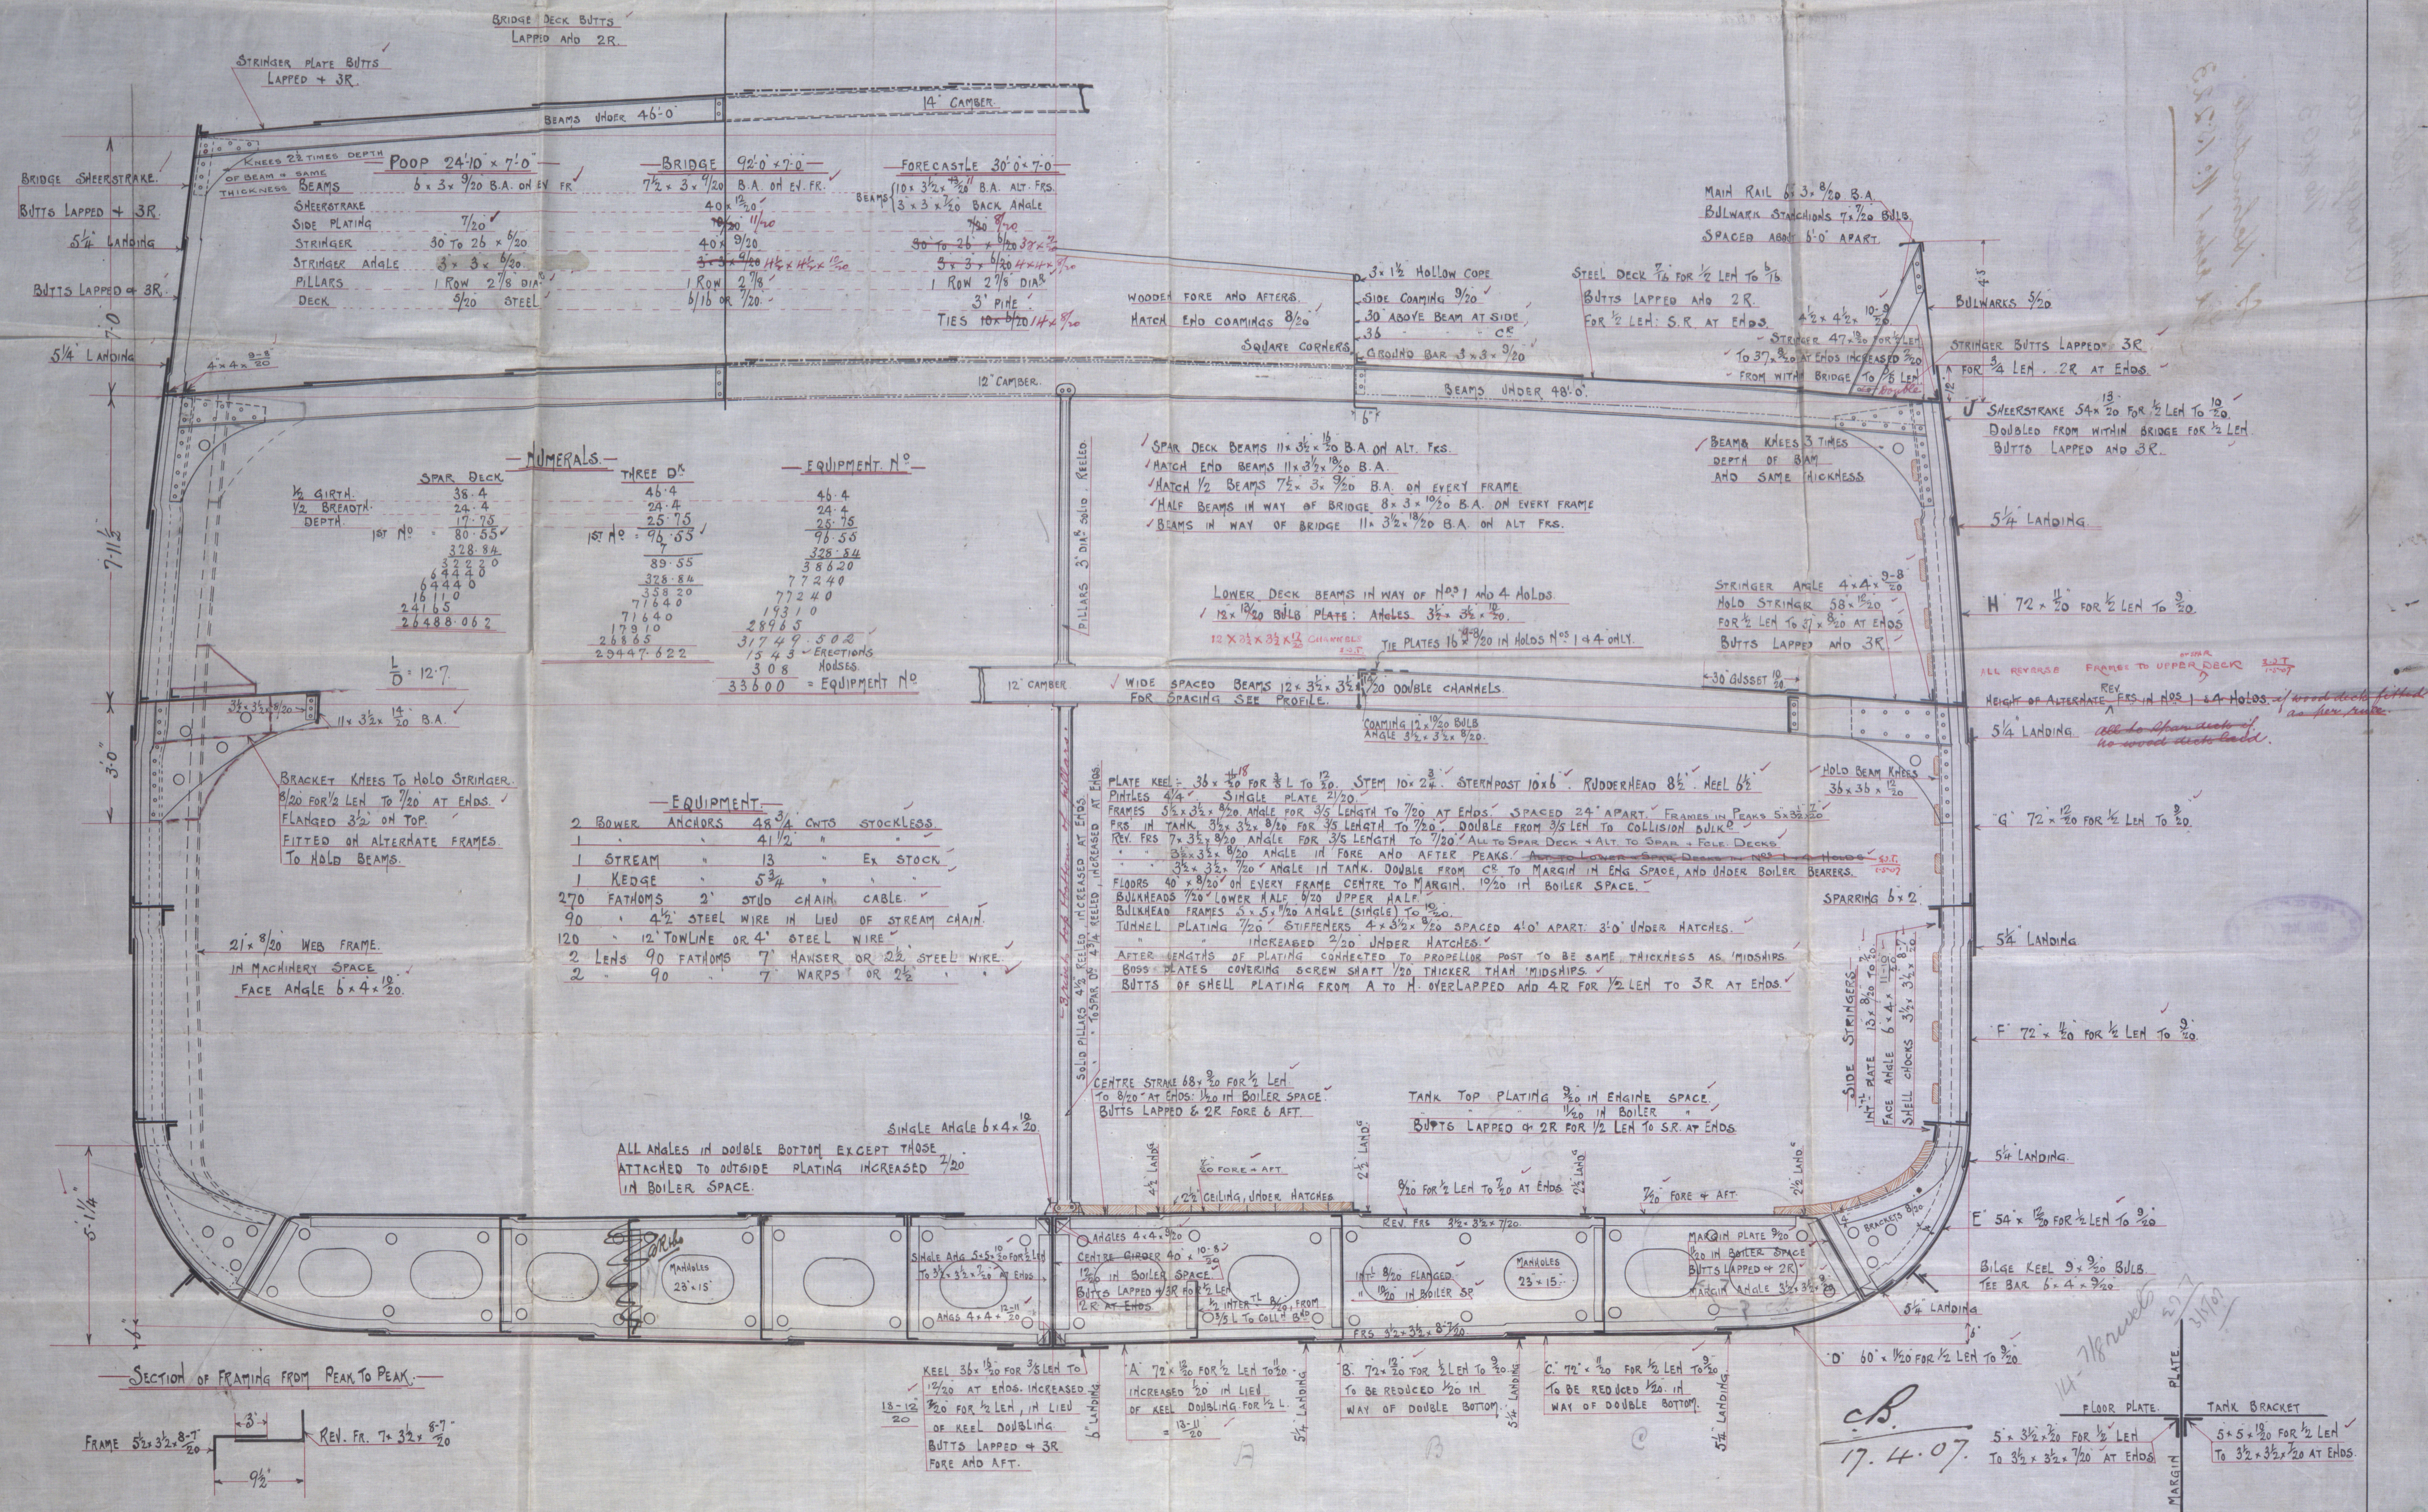

C.B.
17.4.07

W1246-0203

No 403

Gen report № 15223

W246-0203

Lloyd's Register
Foundation

INGMAN

Feb. 15-223

W 246-0203
© 2019

Lloyd's Register
Foundation

