


Nº 129


3.3.08
6.7.08

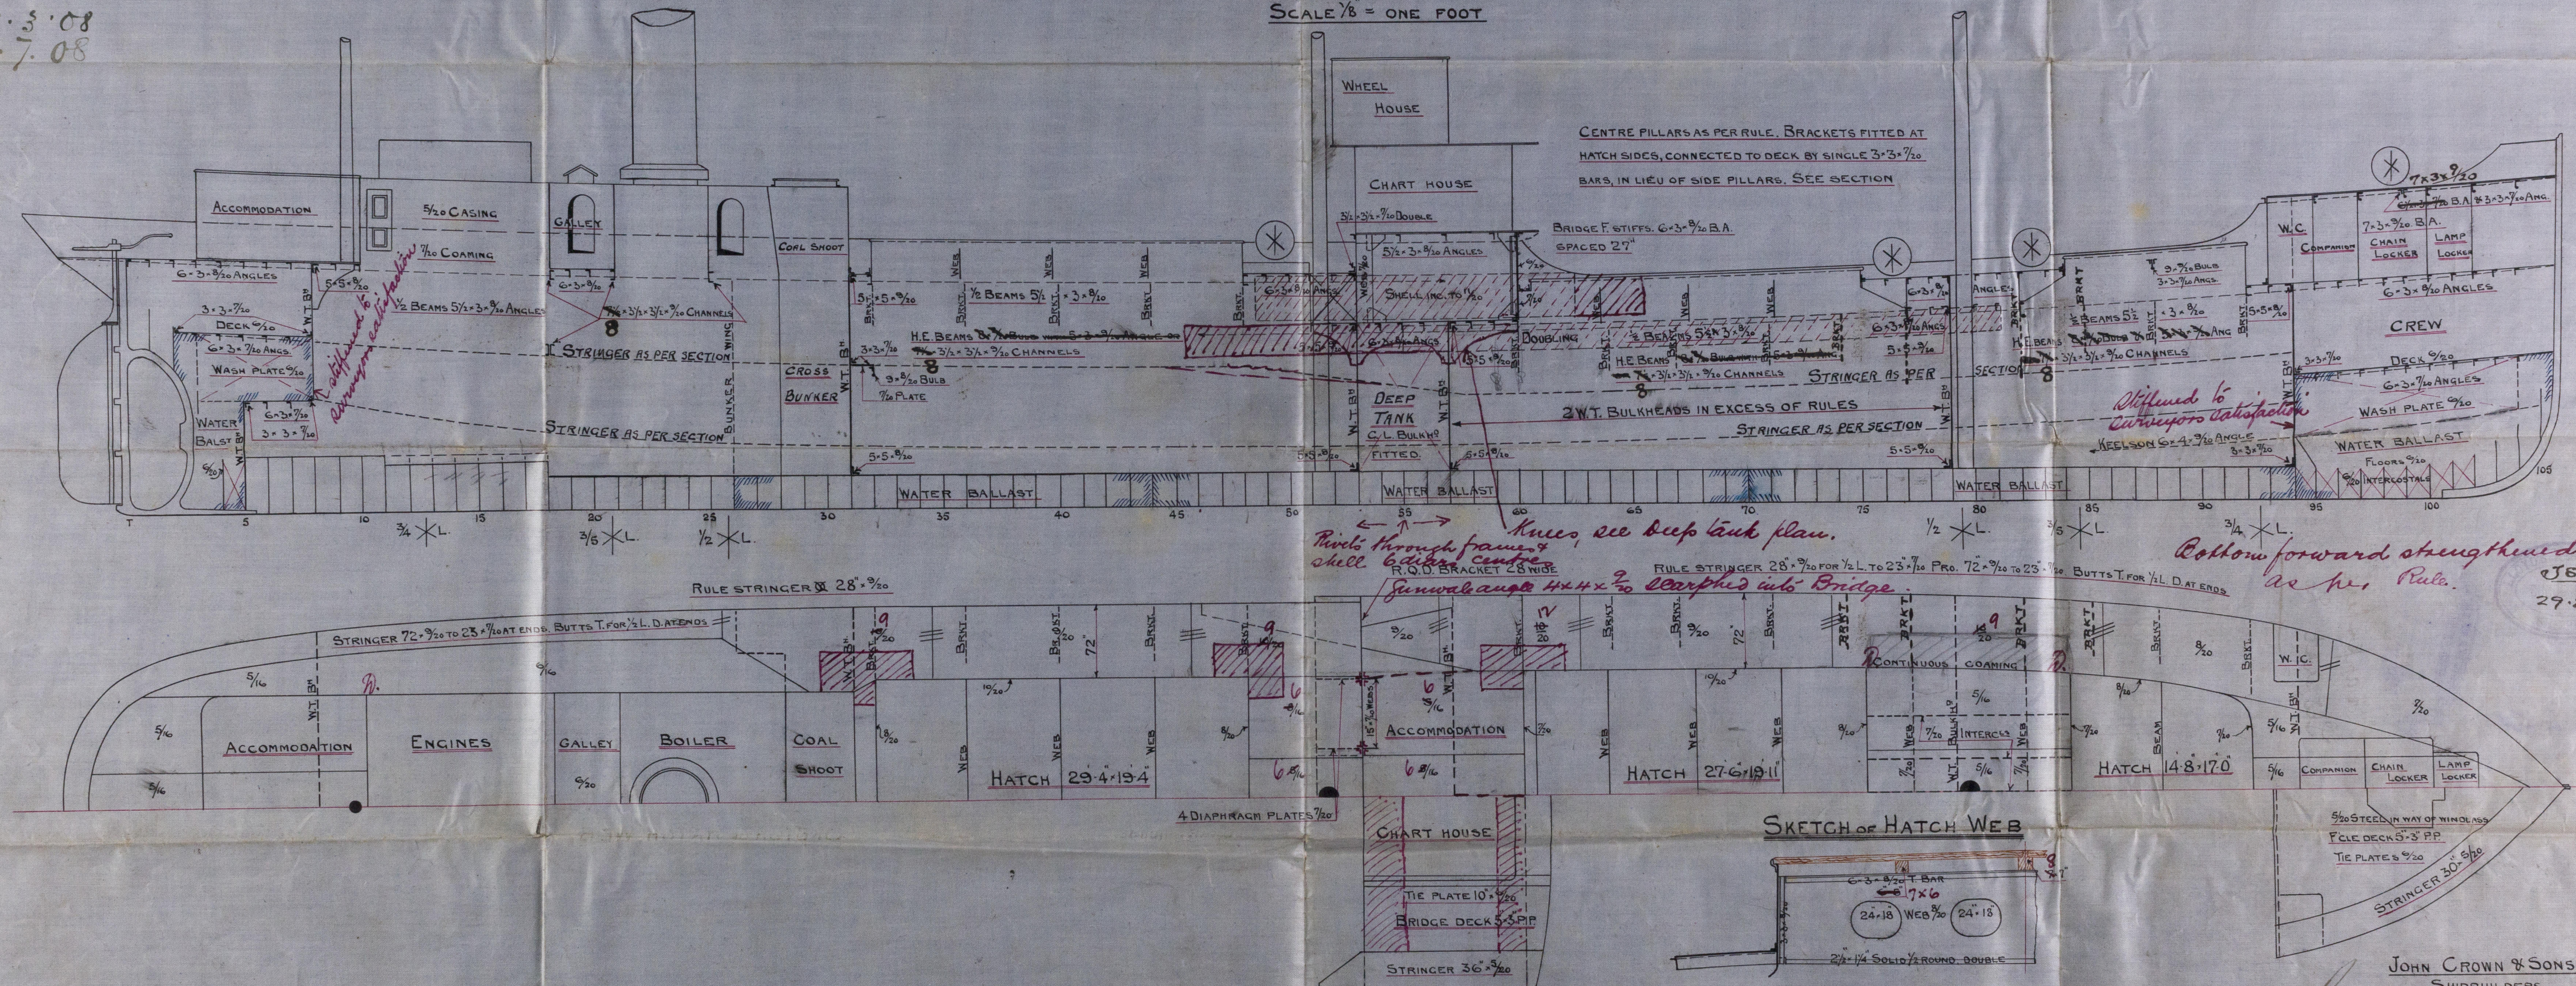

C.B.
3.3.08.

7/10-01/4

Profile & Decks

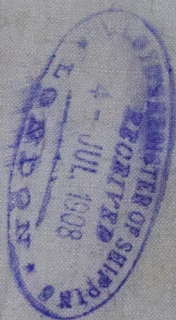

Tim ex
"Hampshire"
Slip No 23804

7-0114 Register
Foundation